


T.29S., R.1W., W.M.

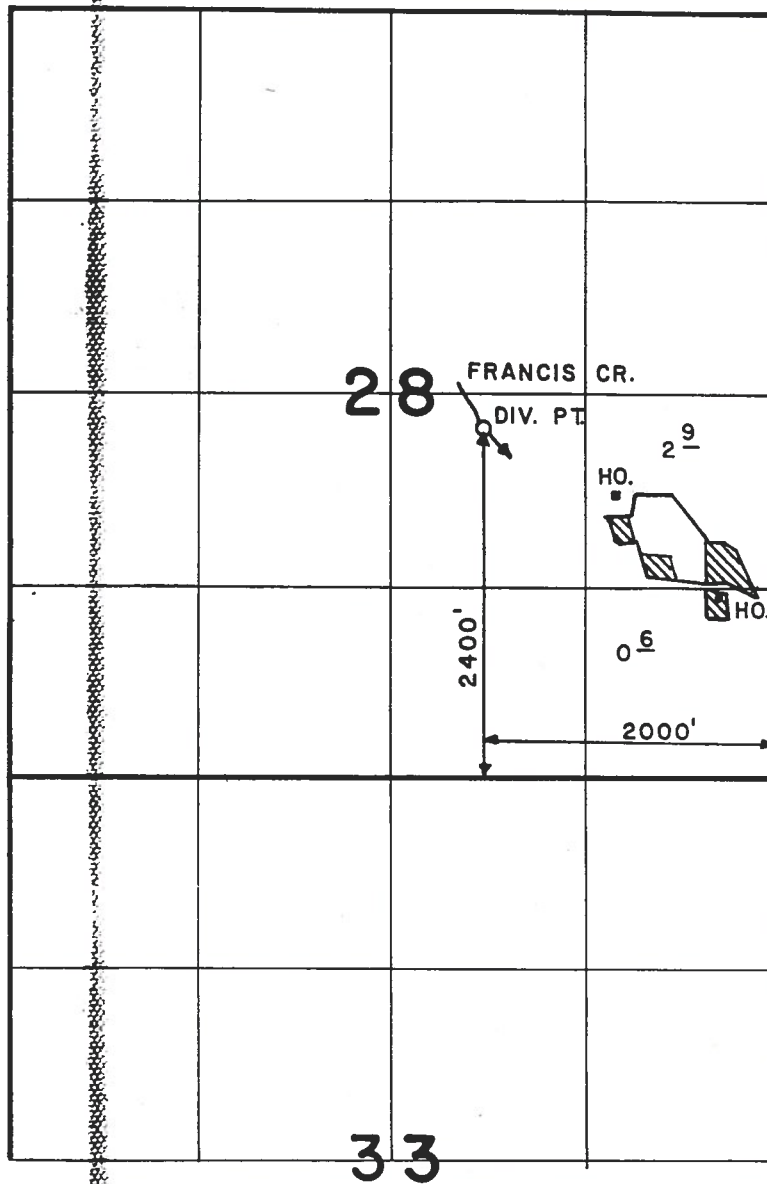

SCALE: 4" = 1 MILE
FINAL PROOF SURVEY
UNDER

RECEIVED

JAN 29 2018

OWRD

Application No. 58837 Permit No. 44694
IN NAME OF

RONALD H. 8 DIANA L. LIZOTTE AND FRANK DIXON

Surveyed JUNE 11 1985, by D.K. CLARK.....

SECTION 28 T.29S. R.1W. W.M.
DOUGLAS COUNTY

1" = 400'


RECEIVED

NOV 24 1997

29 1

WATER RESOURCES DEPT.
SALEM, OREGON

SEE MAP 29 1

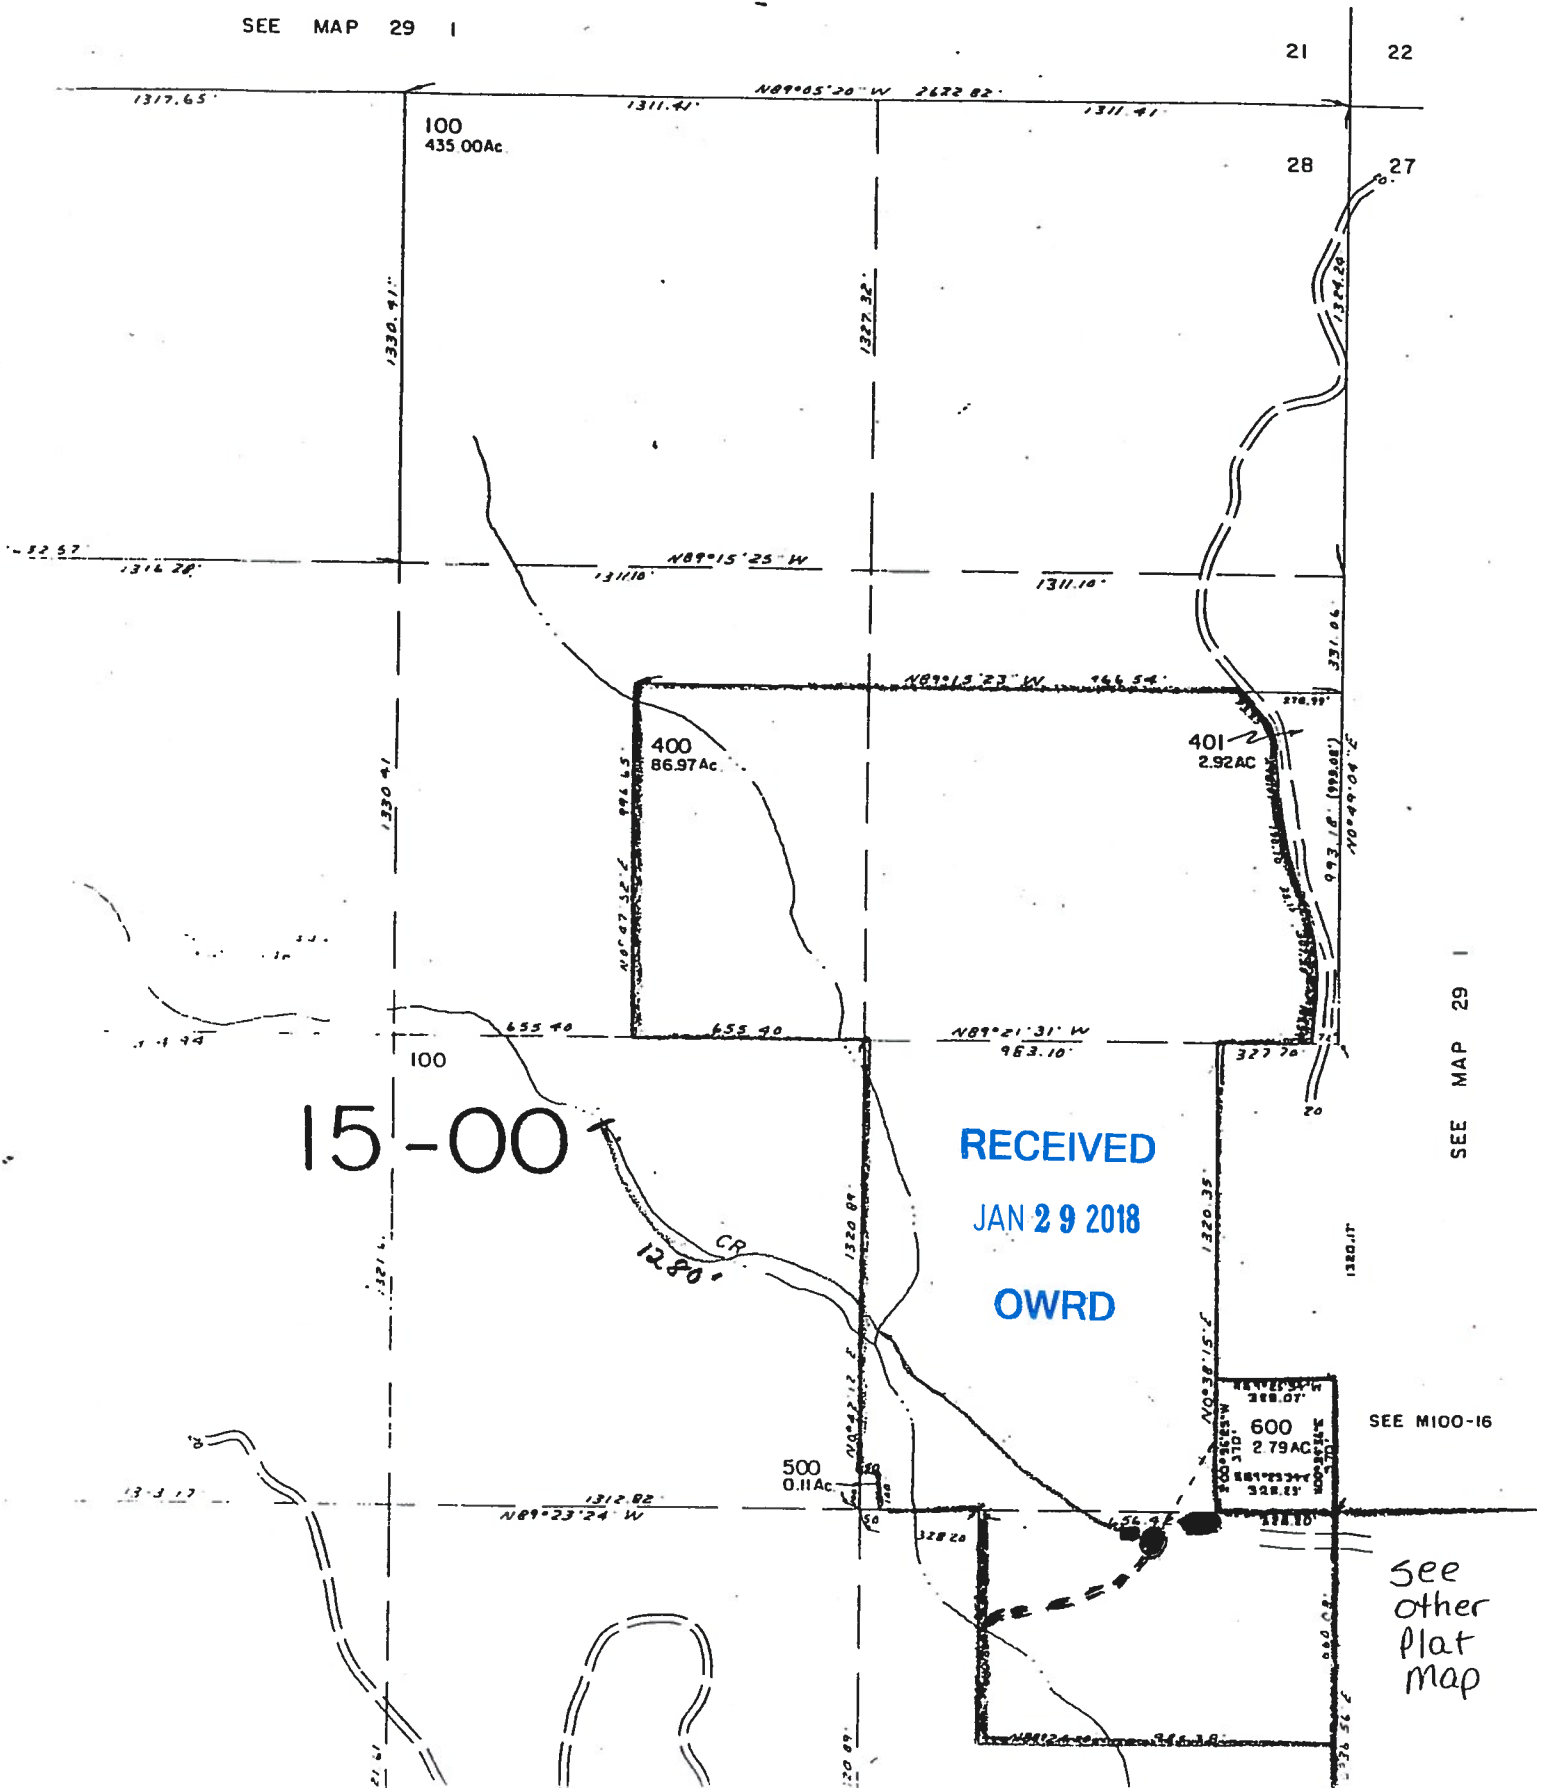

15-00

RECEIVED

JAN 29 2018

OWRD

SEE MAP 29 1

SEE M100-16

see
other
plat
map

