

Scale
1" = 1320'


Surveyed April 25 & 26 and August 9 & 10, 2002

- ⊘ Primary
- ⊙ Supplemental

Claim of Beneficial Use Map
for
J.R. SIMPLOT CO.

App R-72400 & S-72401
Per R-12130 & 53063

This map is for the purpose of
locating a water right only
and has no intent to provide
legal dimensions or the location
of property lines.

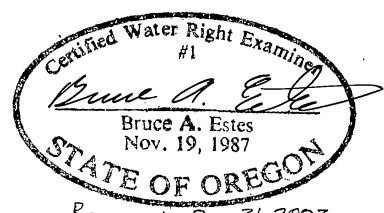

Renewal Dec 31, 2003
Sheet 3 of 4

ESTES SURVEYS, LLC
 PO Box 17519 60382 Arnold Rd
 Salem, OR 97305-7519 Bend, OR 97702
 (503) 585-7593 (541) 382-7391