


T19S, R34E, W.M.
Harney County, Oregon

RECEIVED

AUG 08 2019

OWRD

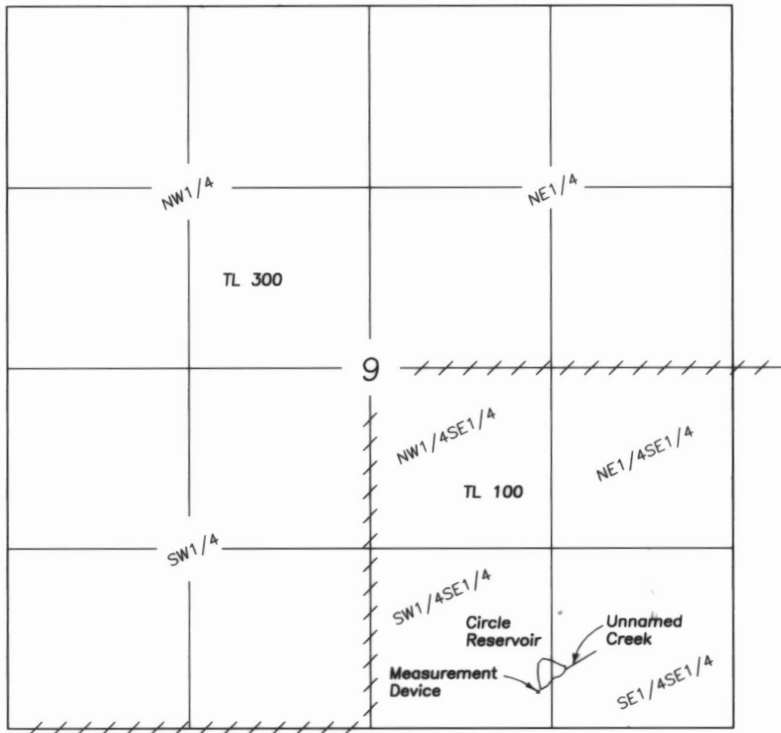

SCALE 1"=1320'

Outlet is located 290' North & 1370' West of the
SE corner of Section 9.

Measuring device is located 70' S & 80' W of the Outlet.

FINAL PROOF SURVEY
CLAIM OF BENEFICIAL USE
CIRCLE RESERVOIR

For

Bureau of Land Management

June 1, 2019

LEGEND

Application No. R-46195
Permit No. R-7894
Priority 7/7/1969

A portion of Tax Lot
19-34 TL100

NOTE: Tax Lot 100 is owned by the BLM
and is more than 11,000 acres.
A portion of the tax lot boundary
is shown.

NOTE: The preparation of this map
was for the purpose of identifying
the location of the proposed water
right and has no intent to provide
dimensions or location of property
ownership lines.

Prepared by
Cornerstone Surveying, Inc

P.O. BOX 33
JOHN DAY, OR. 97845
(541)575-1813
jwsurvey55@gmail.com

