


EXHIBIT A

T32S, R36E, W.M.
Harney County, Oregon

RECEIVED

AUG 08 2019

OWRD

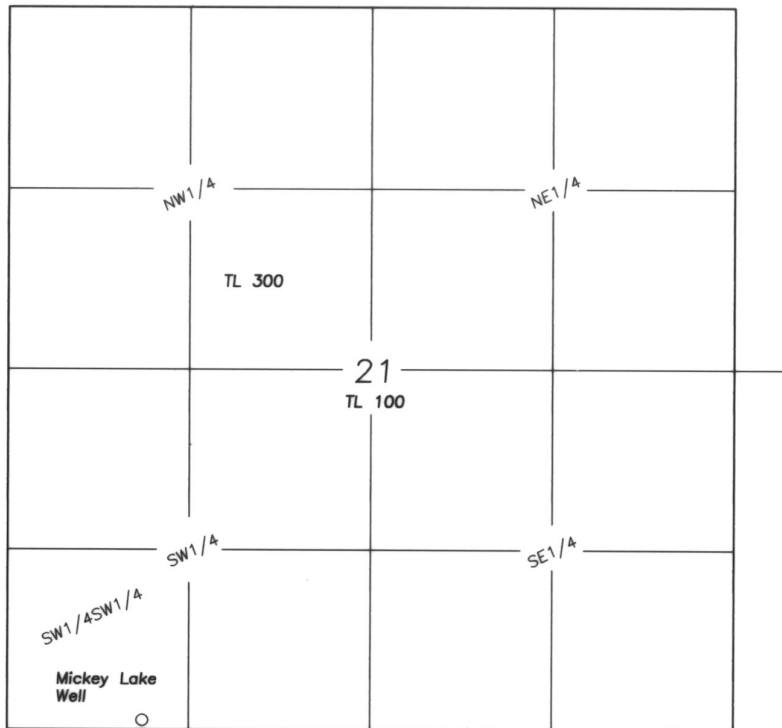

SCALE 1"=1320'

Well is located 70' North & 980' East of the
SW corner of Section 21.

FINAL PROOF SURVEY
CLAIM OF BENEFICIAL USE
MICKEY LAKE WELL

For

Bureau of Land Management

June 3, 2019

LEGEND

Application No. G-10634
Permit No. G-10381
Priority 2/4/1983

A portion of Tax Lot
32-36 TL100

NOTE: Tax Lot 100 is owned by the BLM
and is more that 22,000 acres.
No tax lot boundary can be shown.

NOTE: The preparation of this map
was for the purpose of identifying
the location of the proposed water
right and has no intent to provide
dimensions or location of property
ownership lines.

Prepared by

Cornerstone Surveying, Inc

P.O. BOX 33
JOHN DAY, OR. 97845
(541)575-1813
jwsurvey55@gmail.com

