


1156

10577  
7156

17201 A

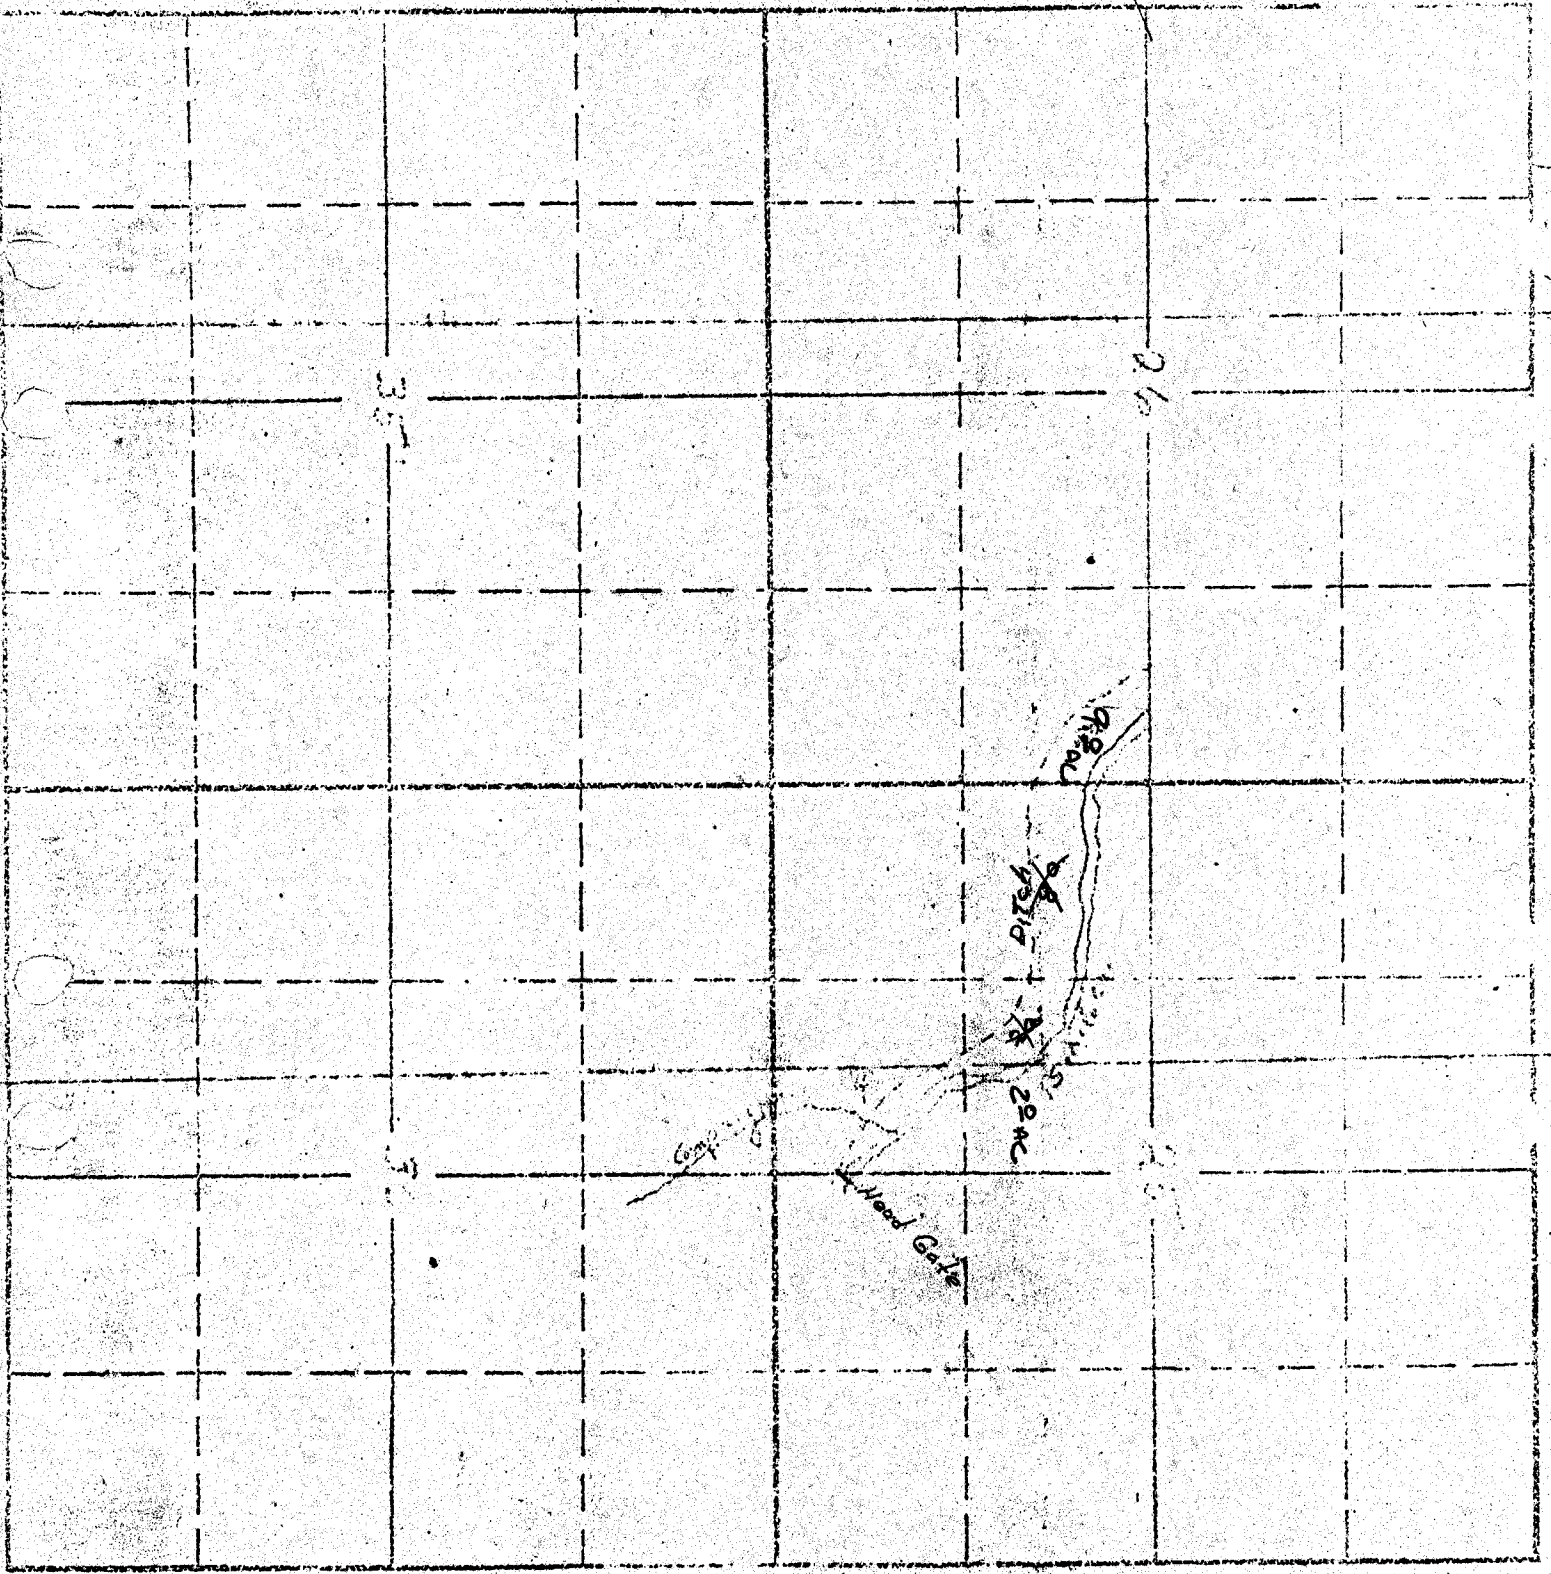

Sec 24

23

Tp 2 N

R. 1 E