


SECTIONS 11 & 12
T. 23 S., R. 1 E., W. M.

EXHIBIT A, CERTIFICATE 76782
HE 242/HE 248
PAGE 2 OF 2

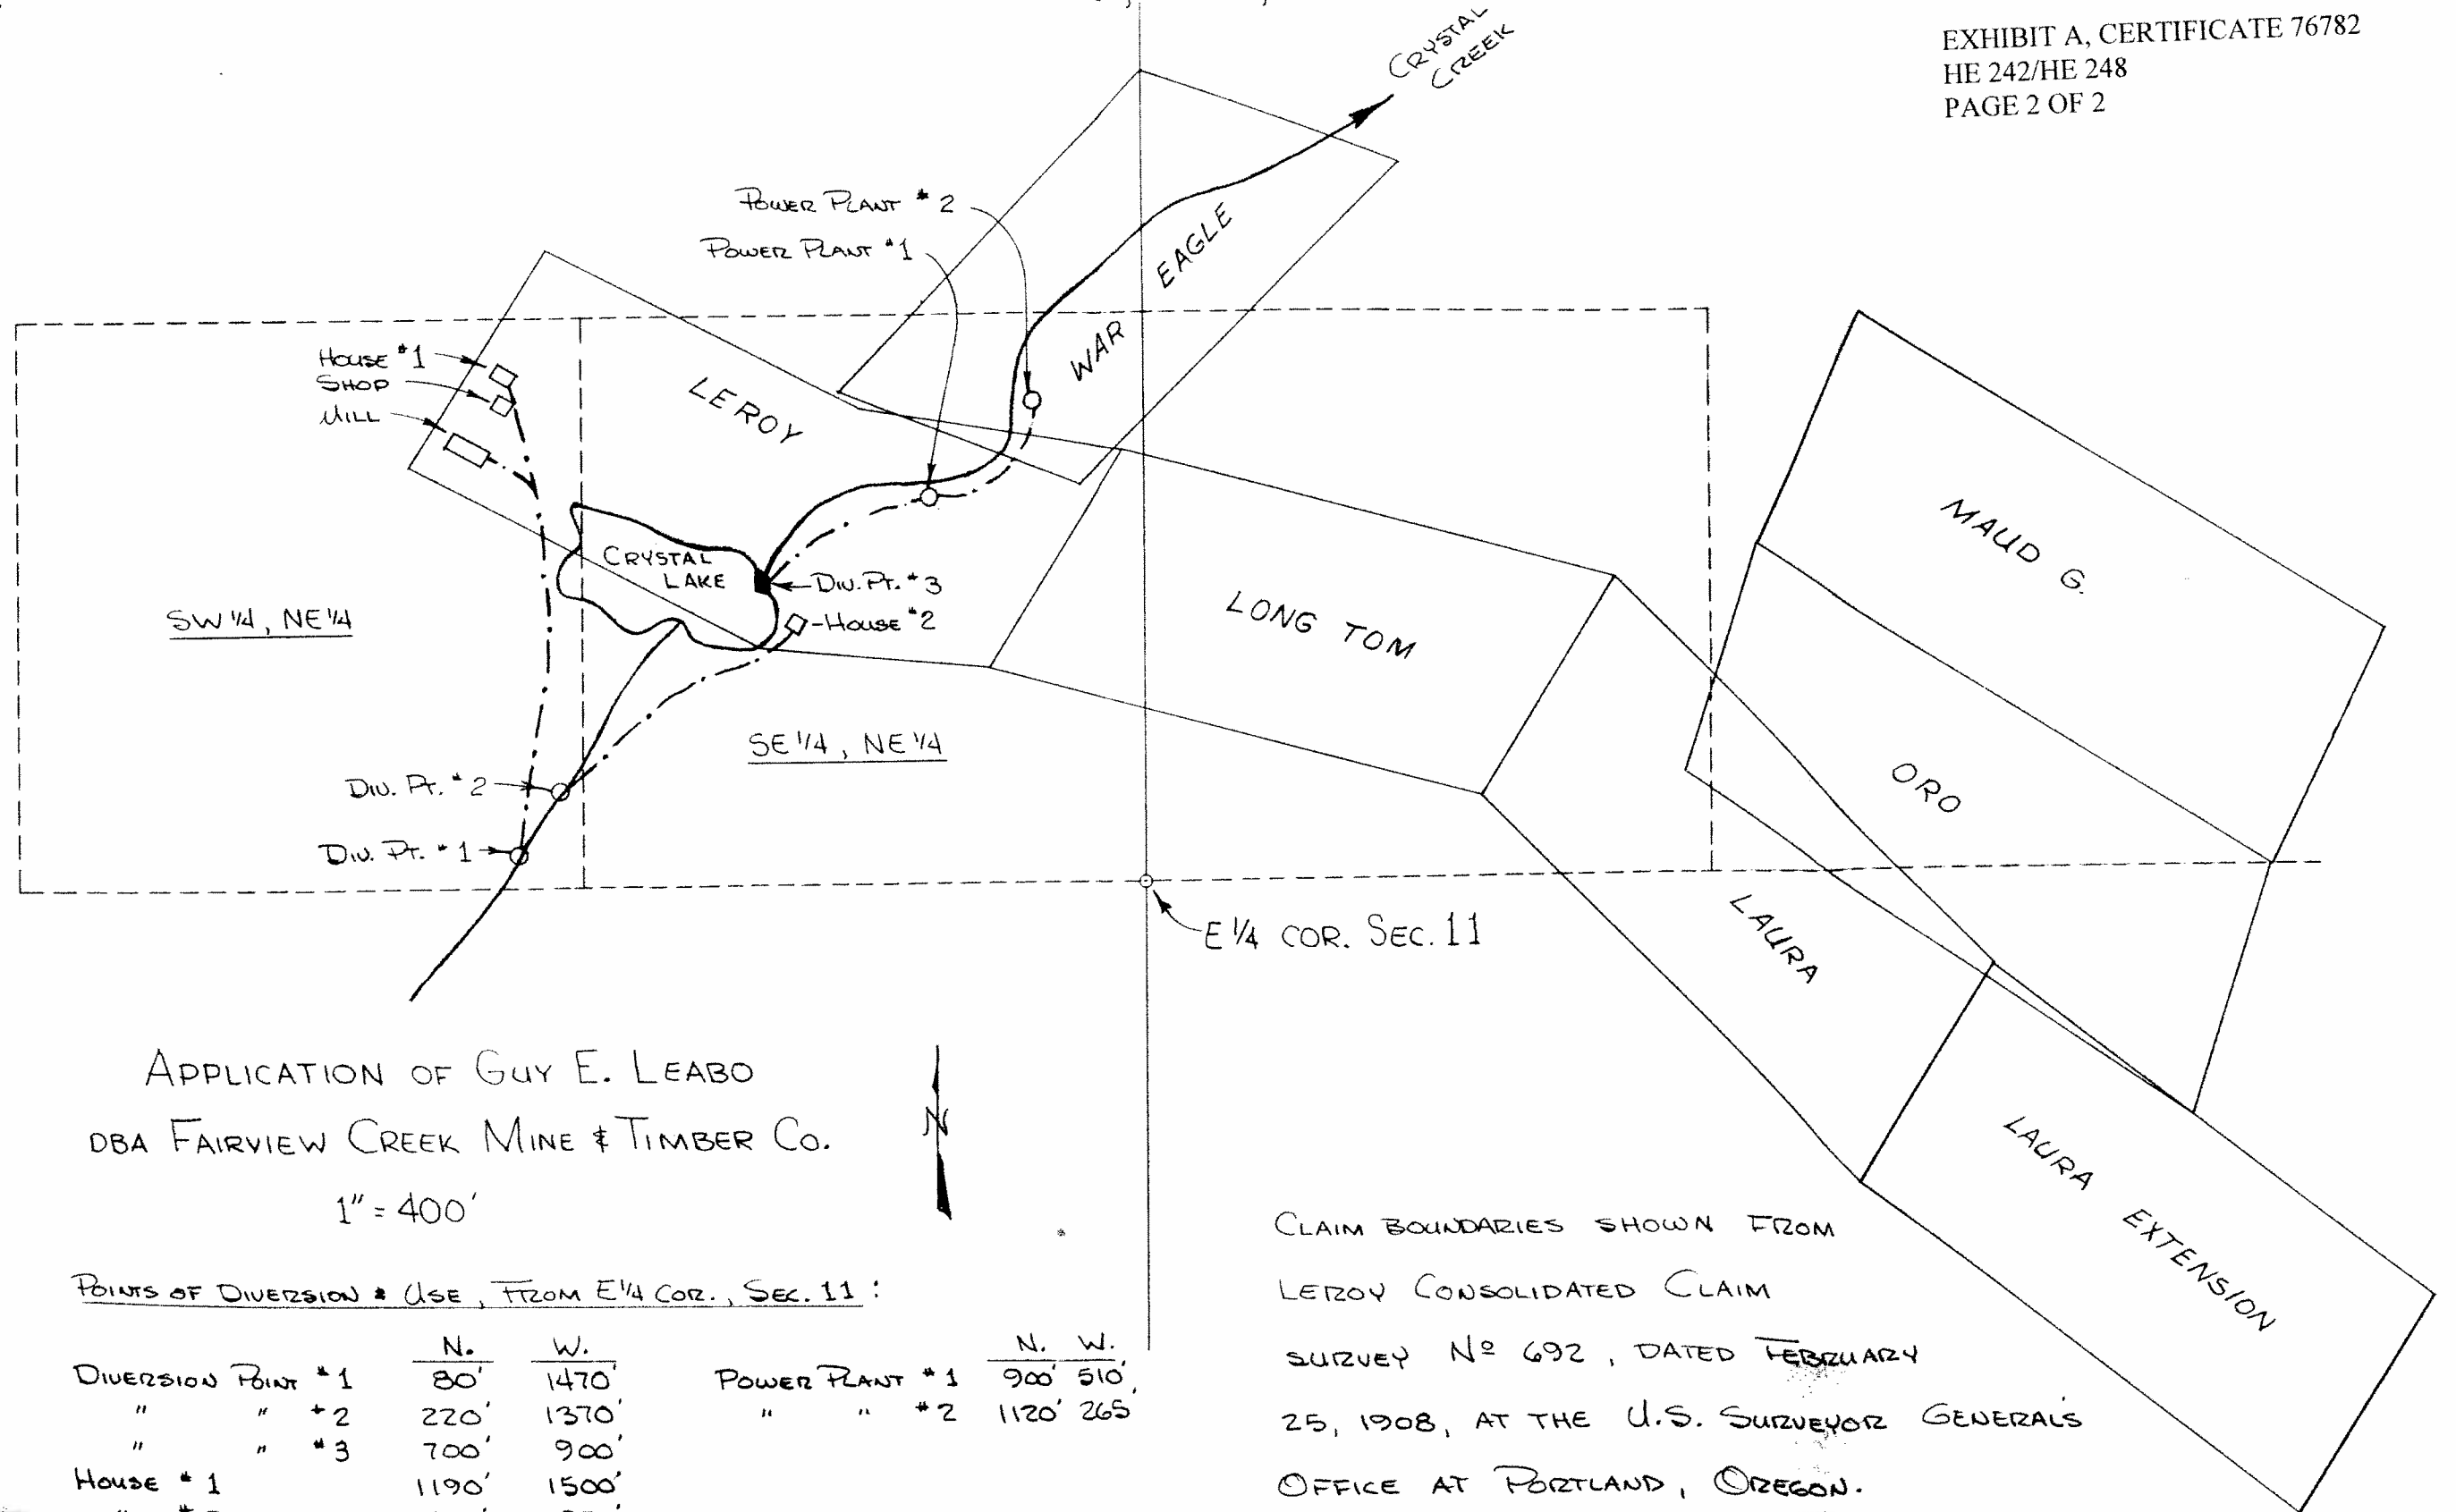

REVISED

RECEIVED

MAR 13 1998


FAIRVIEW PEAK QUADRANGLE
OREGON

APR 05 2018


WATER RESOURCES DEPT. 7.5 MINUTE SERIES (TOPOGRAPHIC)

SALEM, OREGON

OWRD

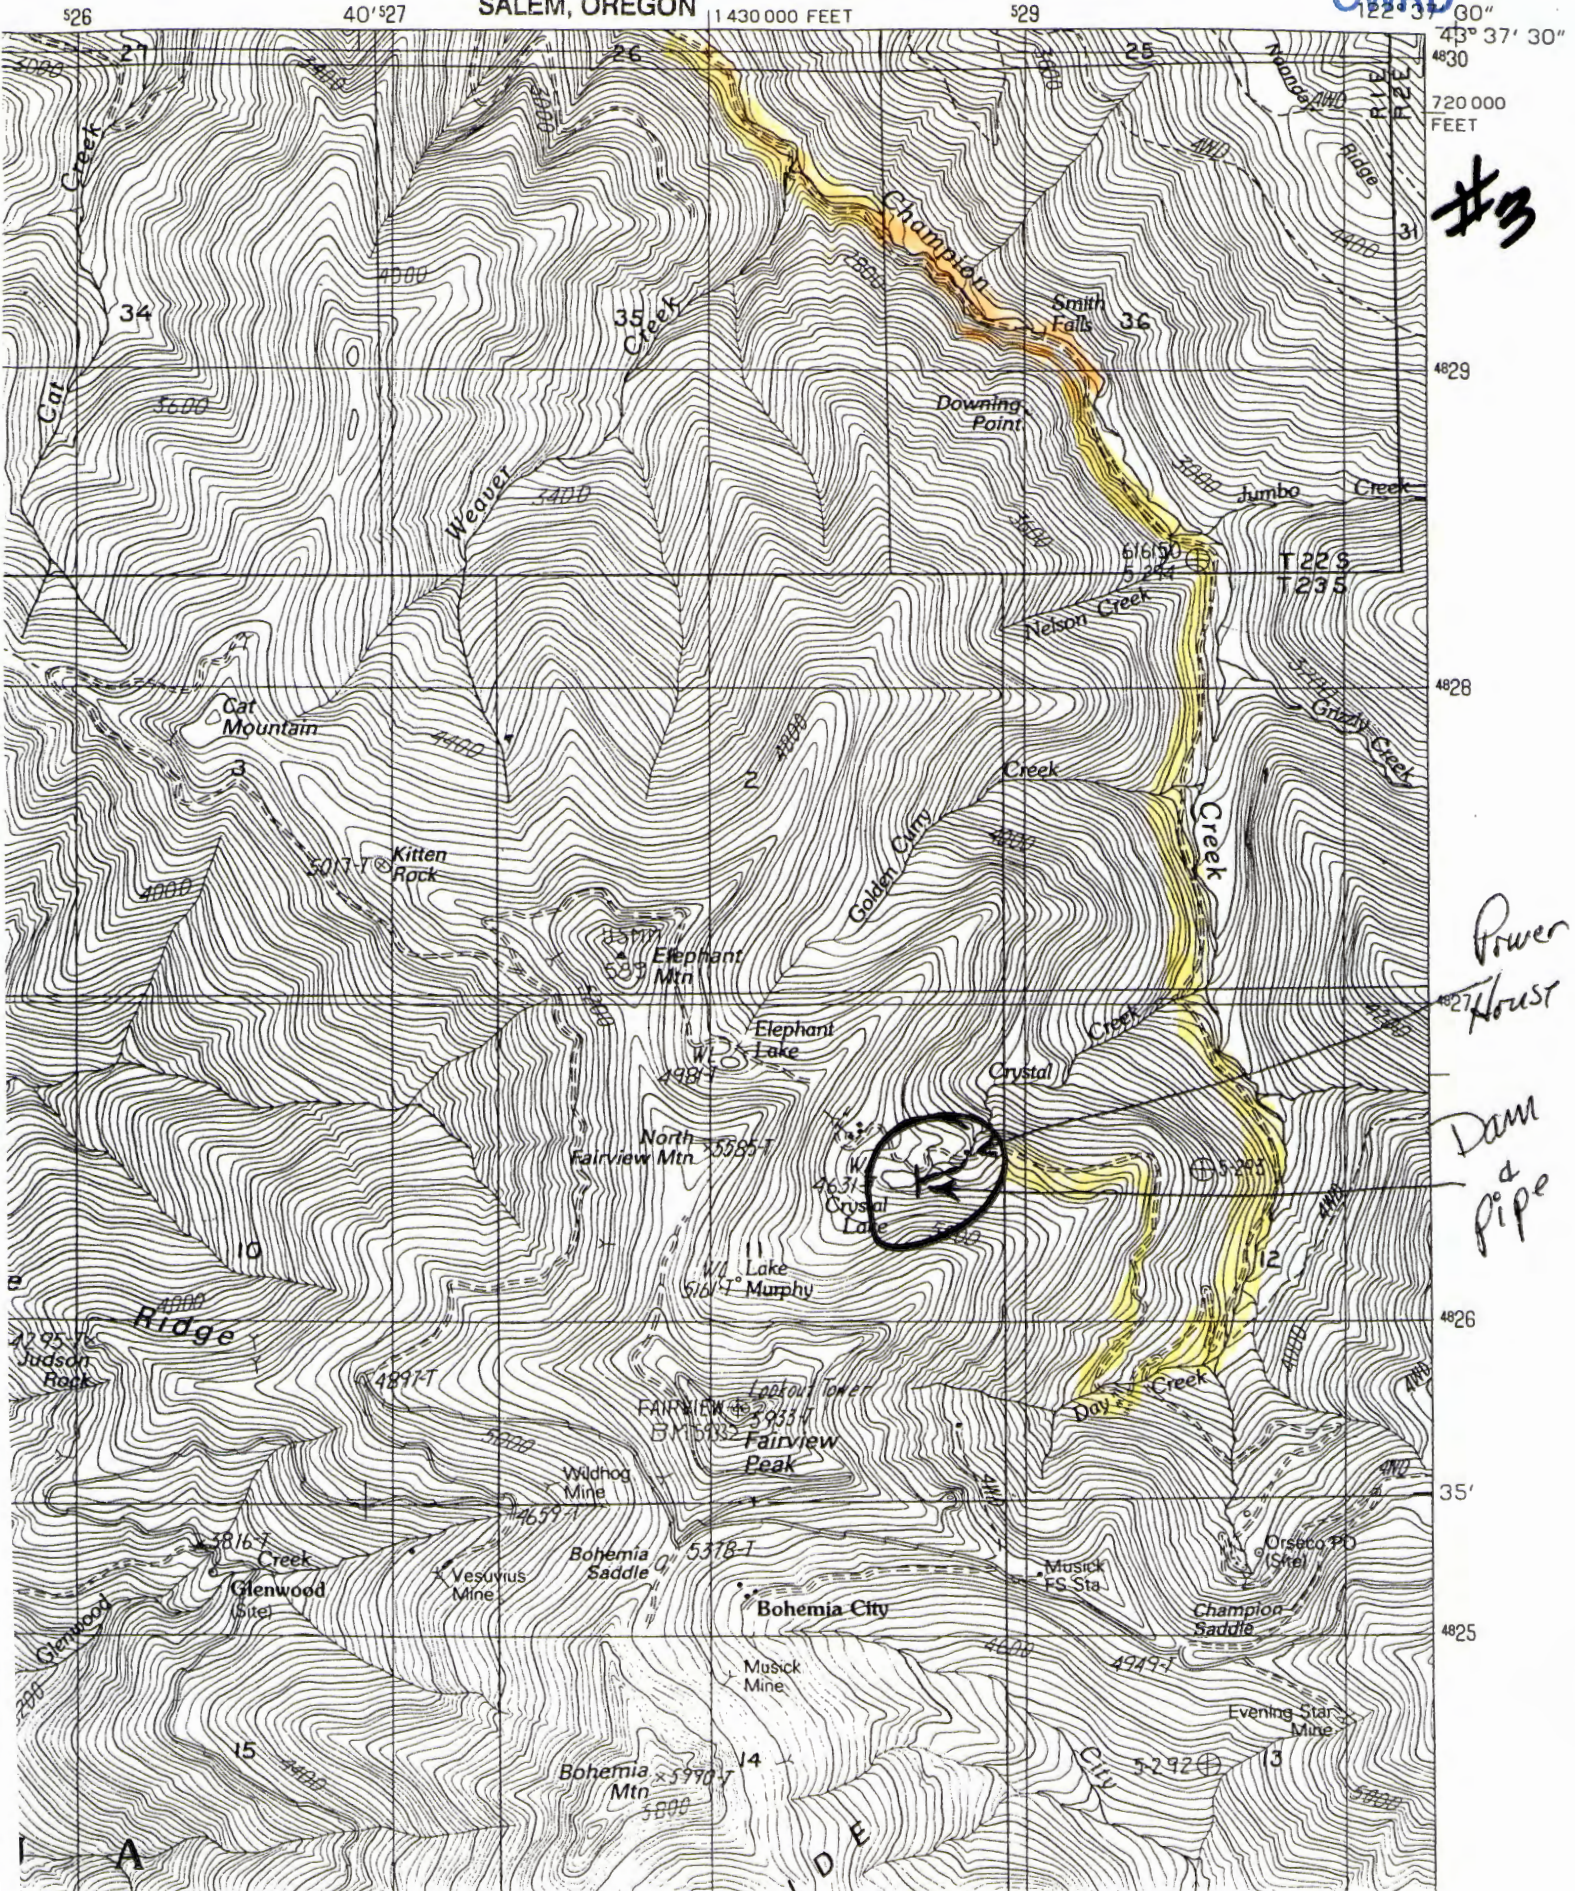

See Map 23 15 12

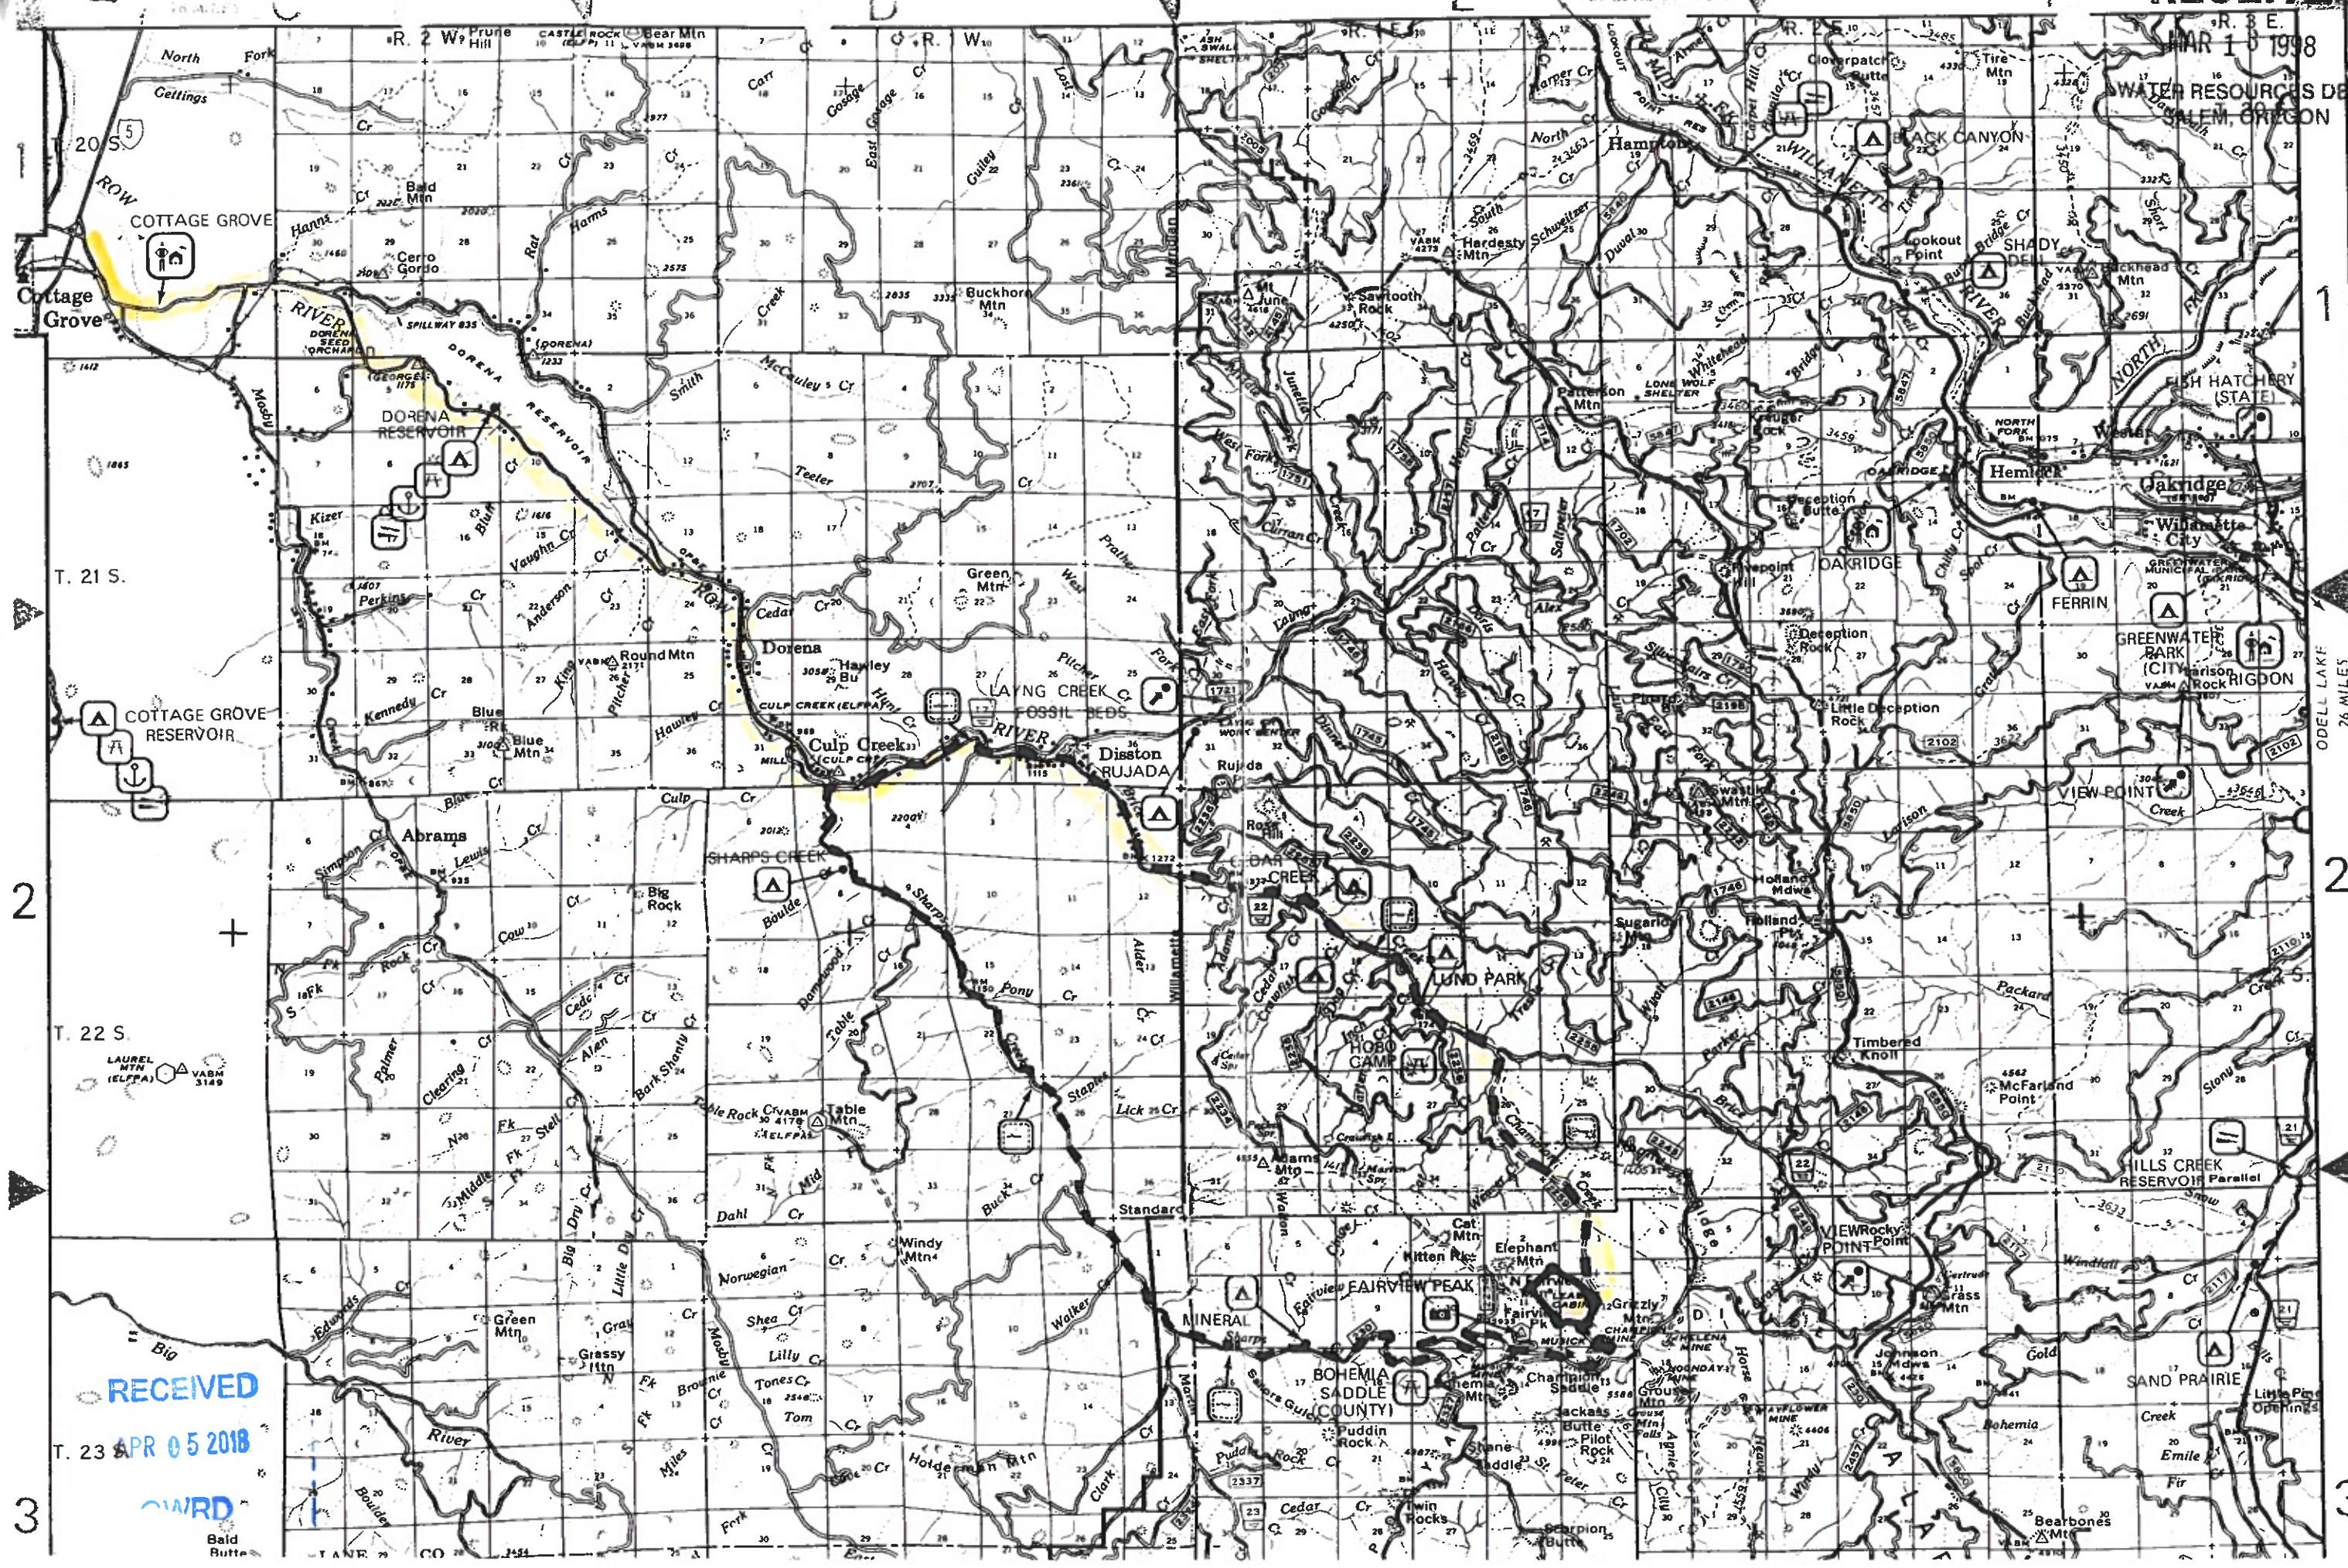

WATER RESOURCES DEPT.
SALEM, OREGON

#2

Tr
Pac
Nat
Sci
Mo
Pan
Bra
Bo
Cre
Mal
Ter
Tw
Yak
Her
Fal
Yel
Jac
Bl
Ro
Dial
Lal
Mt
Mt
Hc
Th
Cr
Wi
Fl
Be
Sw
Gr
Ac
Sk
He
La
Do
Co
*E
M
S
Ti
a
d
b
C
S
re
fo

RECEIVED
APR 05 2018
WRD
Bald Butte