


1156

10577
7156

1731

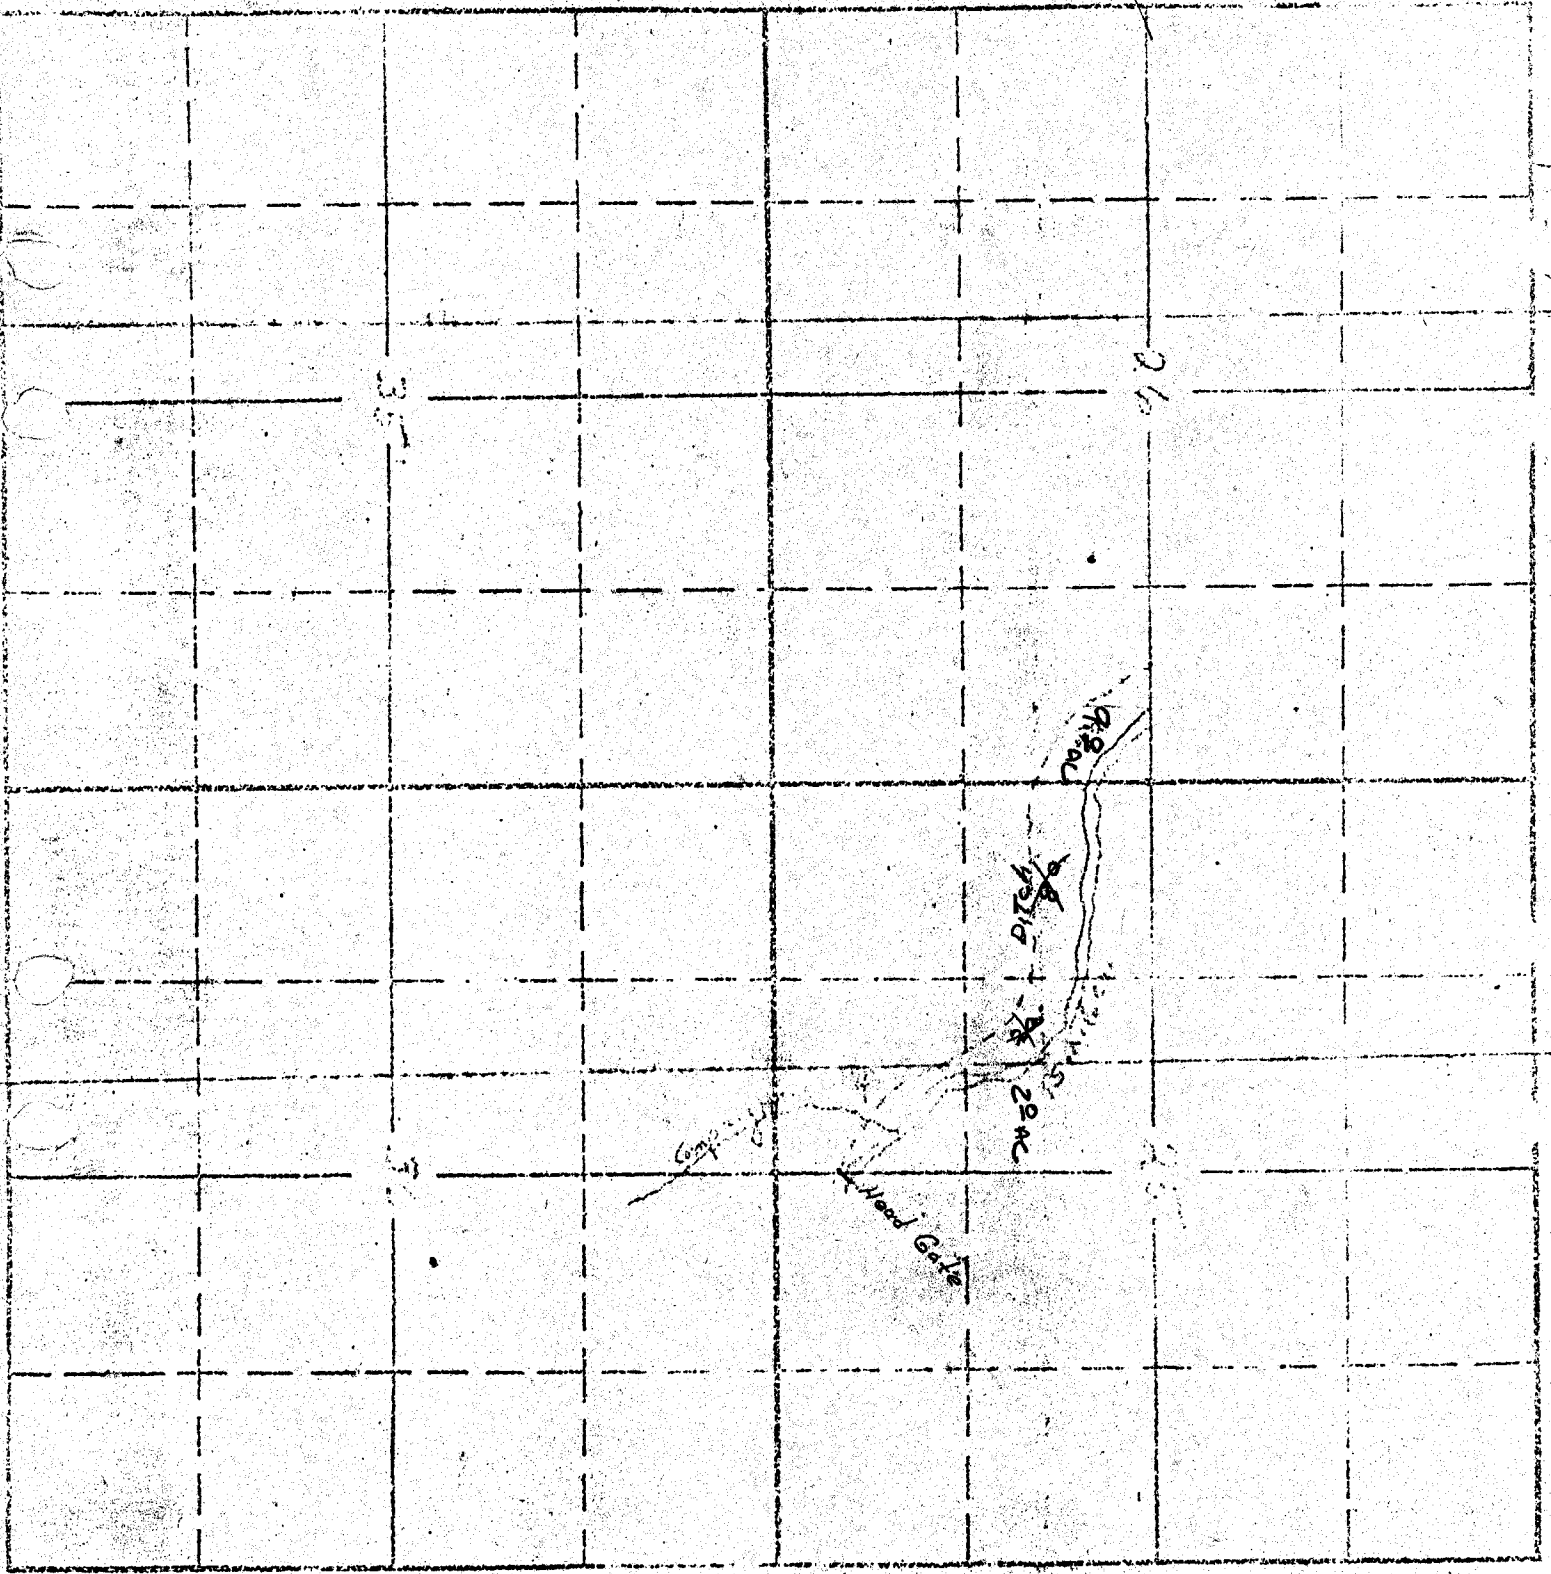

Sec. 24

23

Tp. 2 N

R. 1 E