
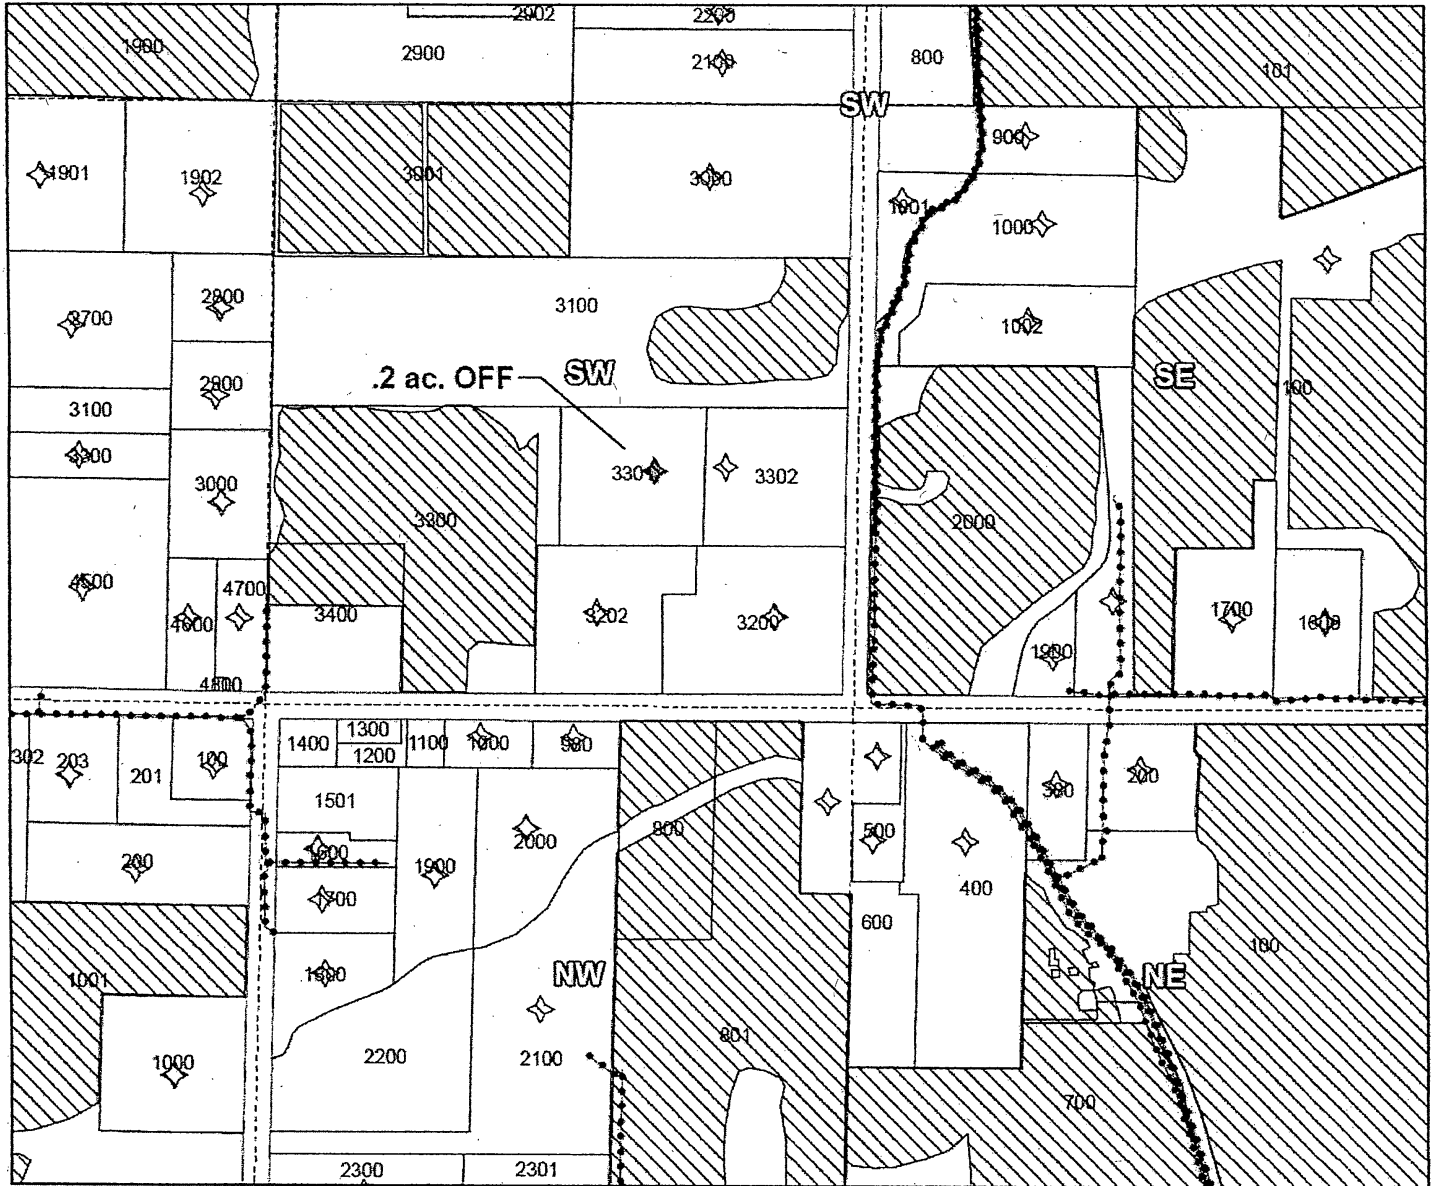


Farmers Irrigation District

2019 District Transfer Application "Off" Map # 8

Certificates: IR 85974, IS 74299, IS 85975, IS 85976

Wolverton, Brad

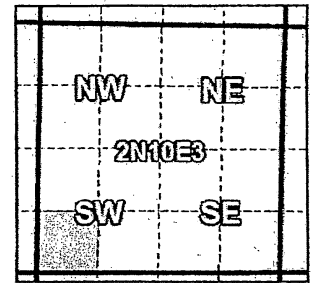

2N-10E-03-SW/SW-3301, 2.30 acres certificates 85974, 74299, 85975, 85976, .20 ac. OFF.

2.10 ac. remains all certificates.

Private certificate IS 94243, .20 ac. OFF, 9.60 ac. remains.

- Pipelines and Canals
- Transfer
- Taxlots
- Primary Water Right

RECEIVED

OCT 17 2019

OWRD



1 inch = 400 feet

Prepared by Farmers Irrigation District September 2019

13268