

T.35 & 36 S. R.33 E. W.M.

RECEIVED
SEP 2 - 1981
WATER RESOURCES DEPT.
SALEM, OREGON

Application No. 62436
Permit No. 46062

FINAL PROOF SURVEY

UNDER

APPLICATION NO. 28563 PERMIT NO. 22338


IN NAME OF

CATLOW - STEENS CORP.

SURVEYED OCT. 21-22, 1965 BY R. JACKSON
OCT. 3-10, 1967 BY W.J. RIPPERT





SCALE 4" = 1 MILE

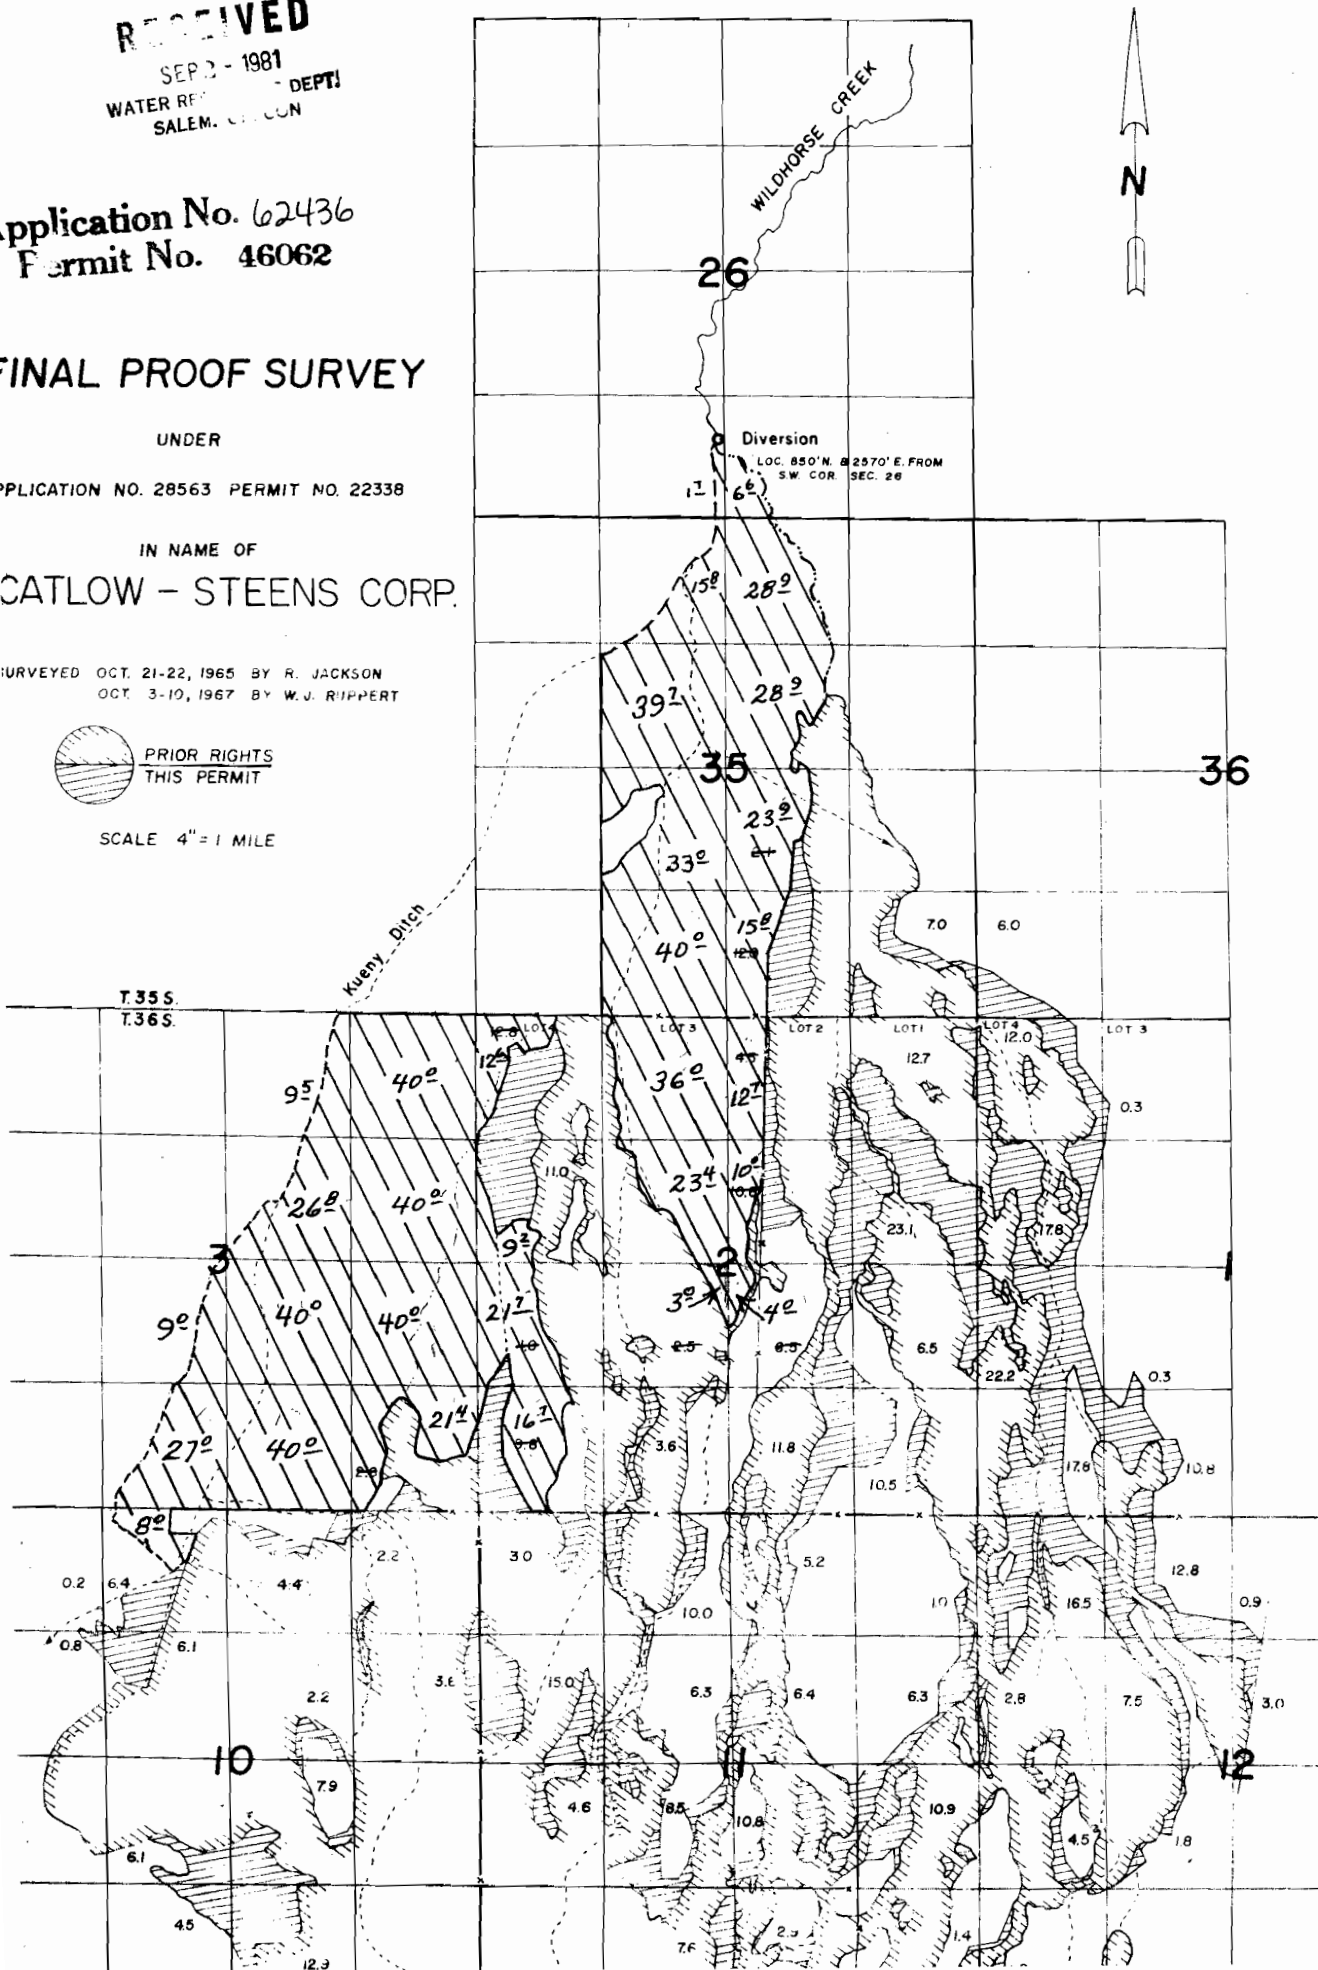


TRANSFER MAP TO ACCOMPANY APPLICATION
TO CHANGE PLACE OF USE FOR
DAVIS RANCHES AND FARMS

TAX LOT 100
IN SECTIONS 10 & 15, TOWNSHIP 36 SOUTH, RANGE 33 EAST, W.M.
HARNEY COUNTY, OREGON

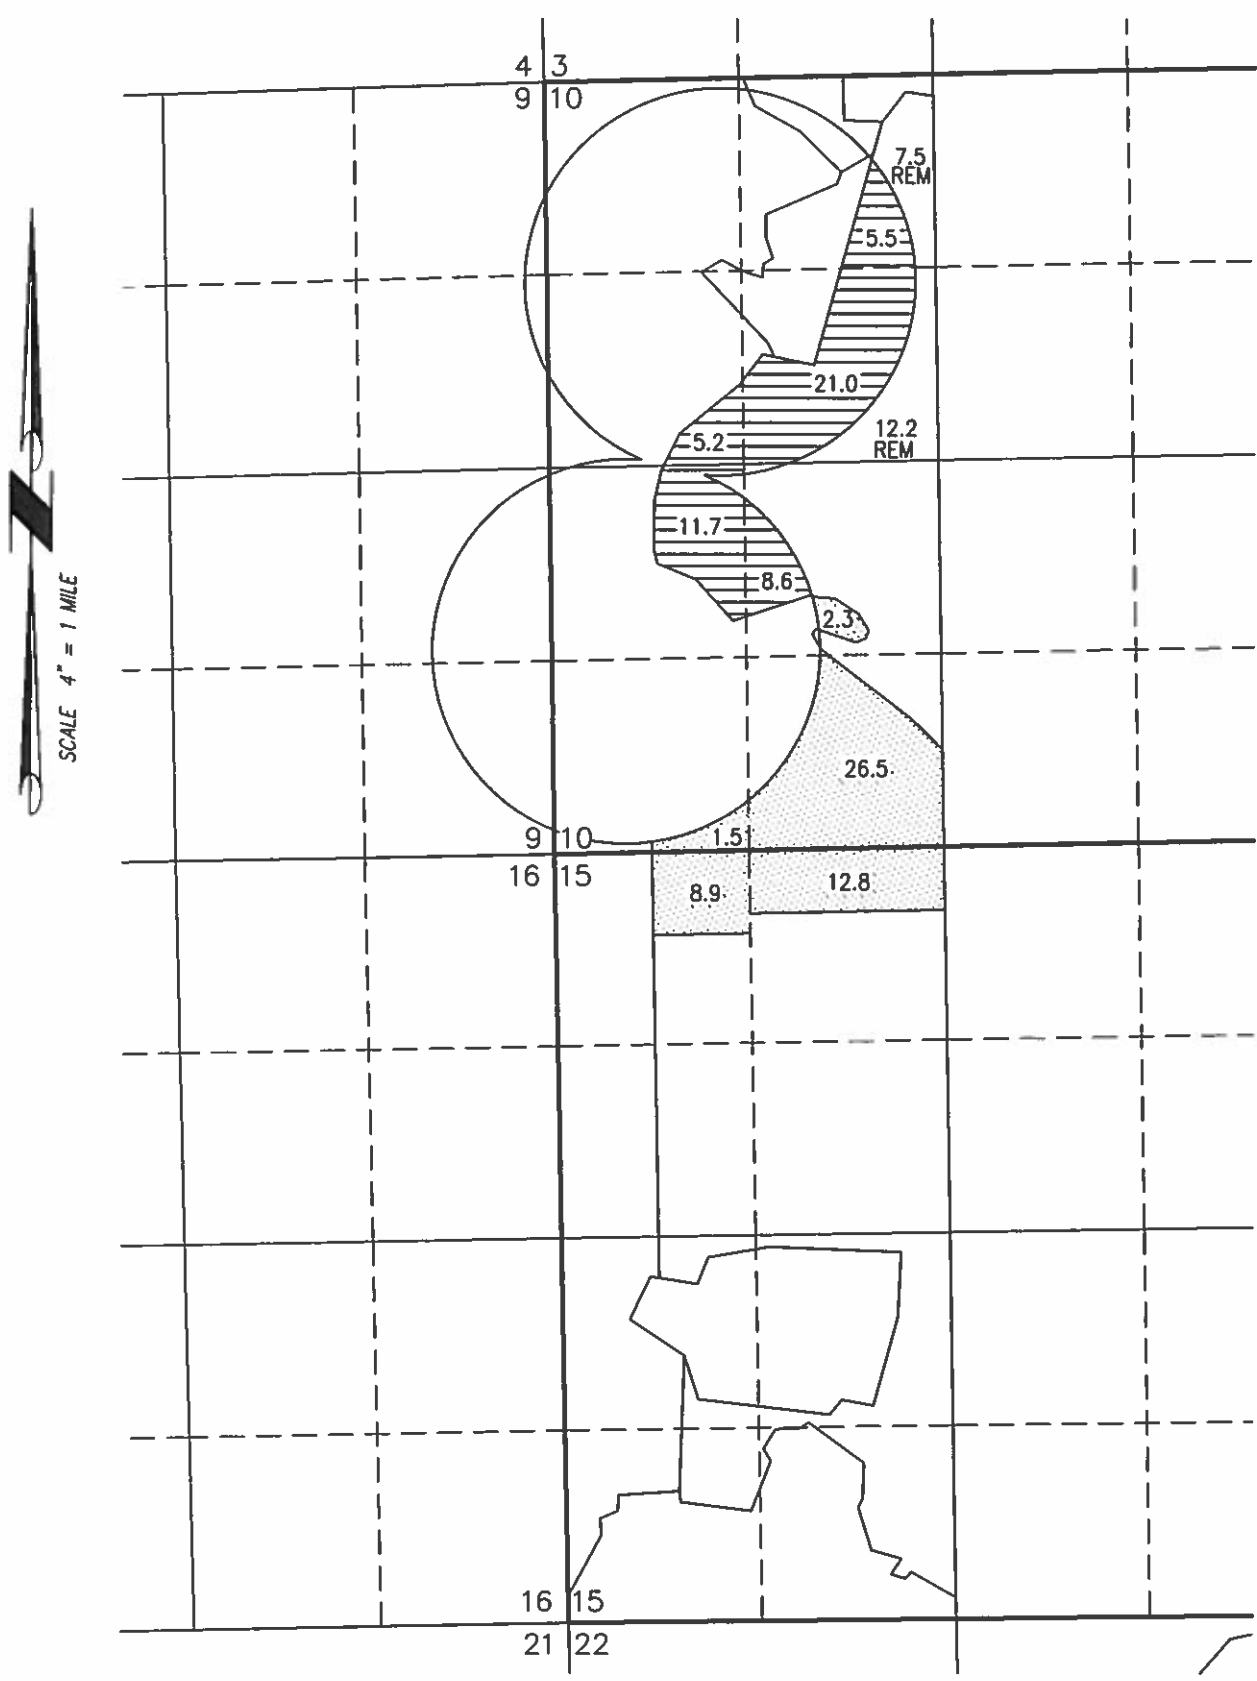

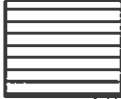
- **POD #1 (SEE SW MAP)**
WILDHORSE CREEK DECREE
850' NORTH & 2570' EAST FROM THE SW
CORNER SECTION 26, T35S, R33E, W.M.
-  52.0 ACRES 'IR' FROM POD (DECREE)
TRANSFERRED, AS SHOWN

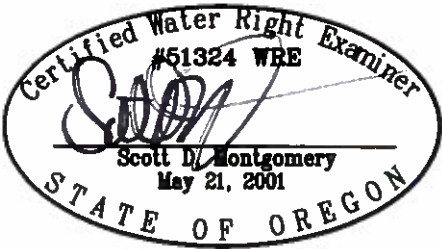

RENEWAL DATE: 12/31/2018

RECEIVED
JUL 25 2018
OWRD

PROJECT No. 18-007	ALL POINTS ENGINEERING & SURVEYING, INC.  P.O. BOX 767 TERREBONNE, OREGON 97760 (541) 548-5833 PH (844) 273-9878 FX www.APEandS.com	THIS MAP IS FOR THE PURPOSE OF LOCATING A WATER RIGHT ONLY AND HAS NO INTENT TO PROVIDE LEGAL DIMENSIONS OR THE LOCATION OF PROPERTY LINES.
PREPARED AT THE REQUEST OF: MIKE DAVIS 42970 KUENY RANCH LANE PRINCETON, OR 97721		

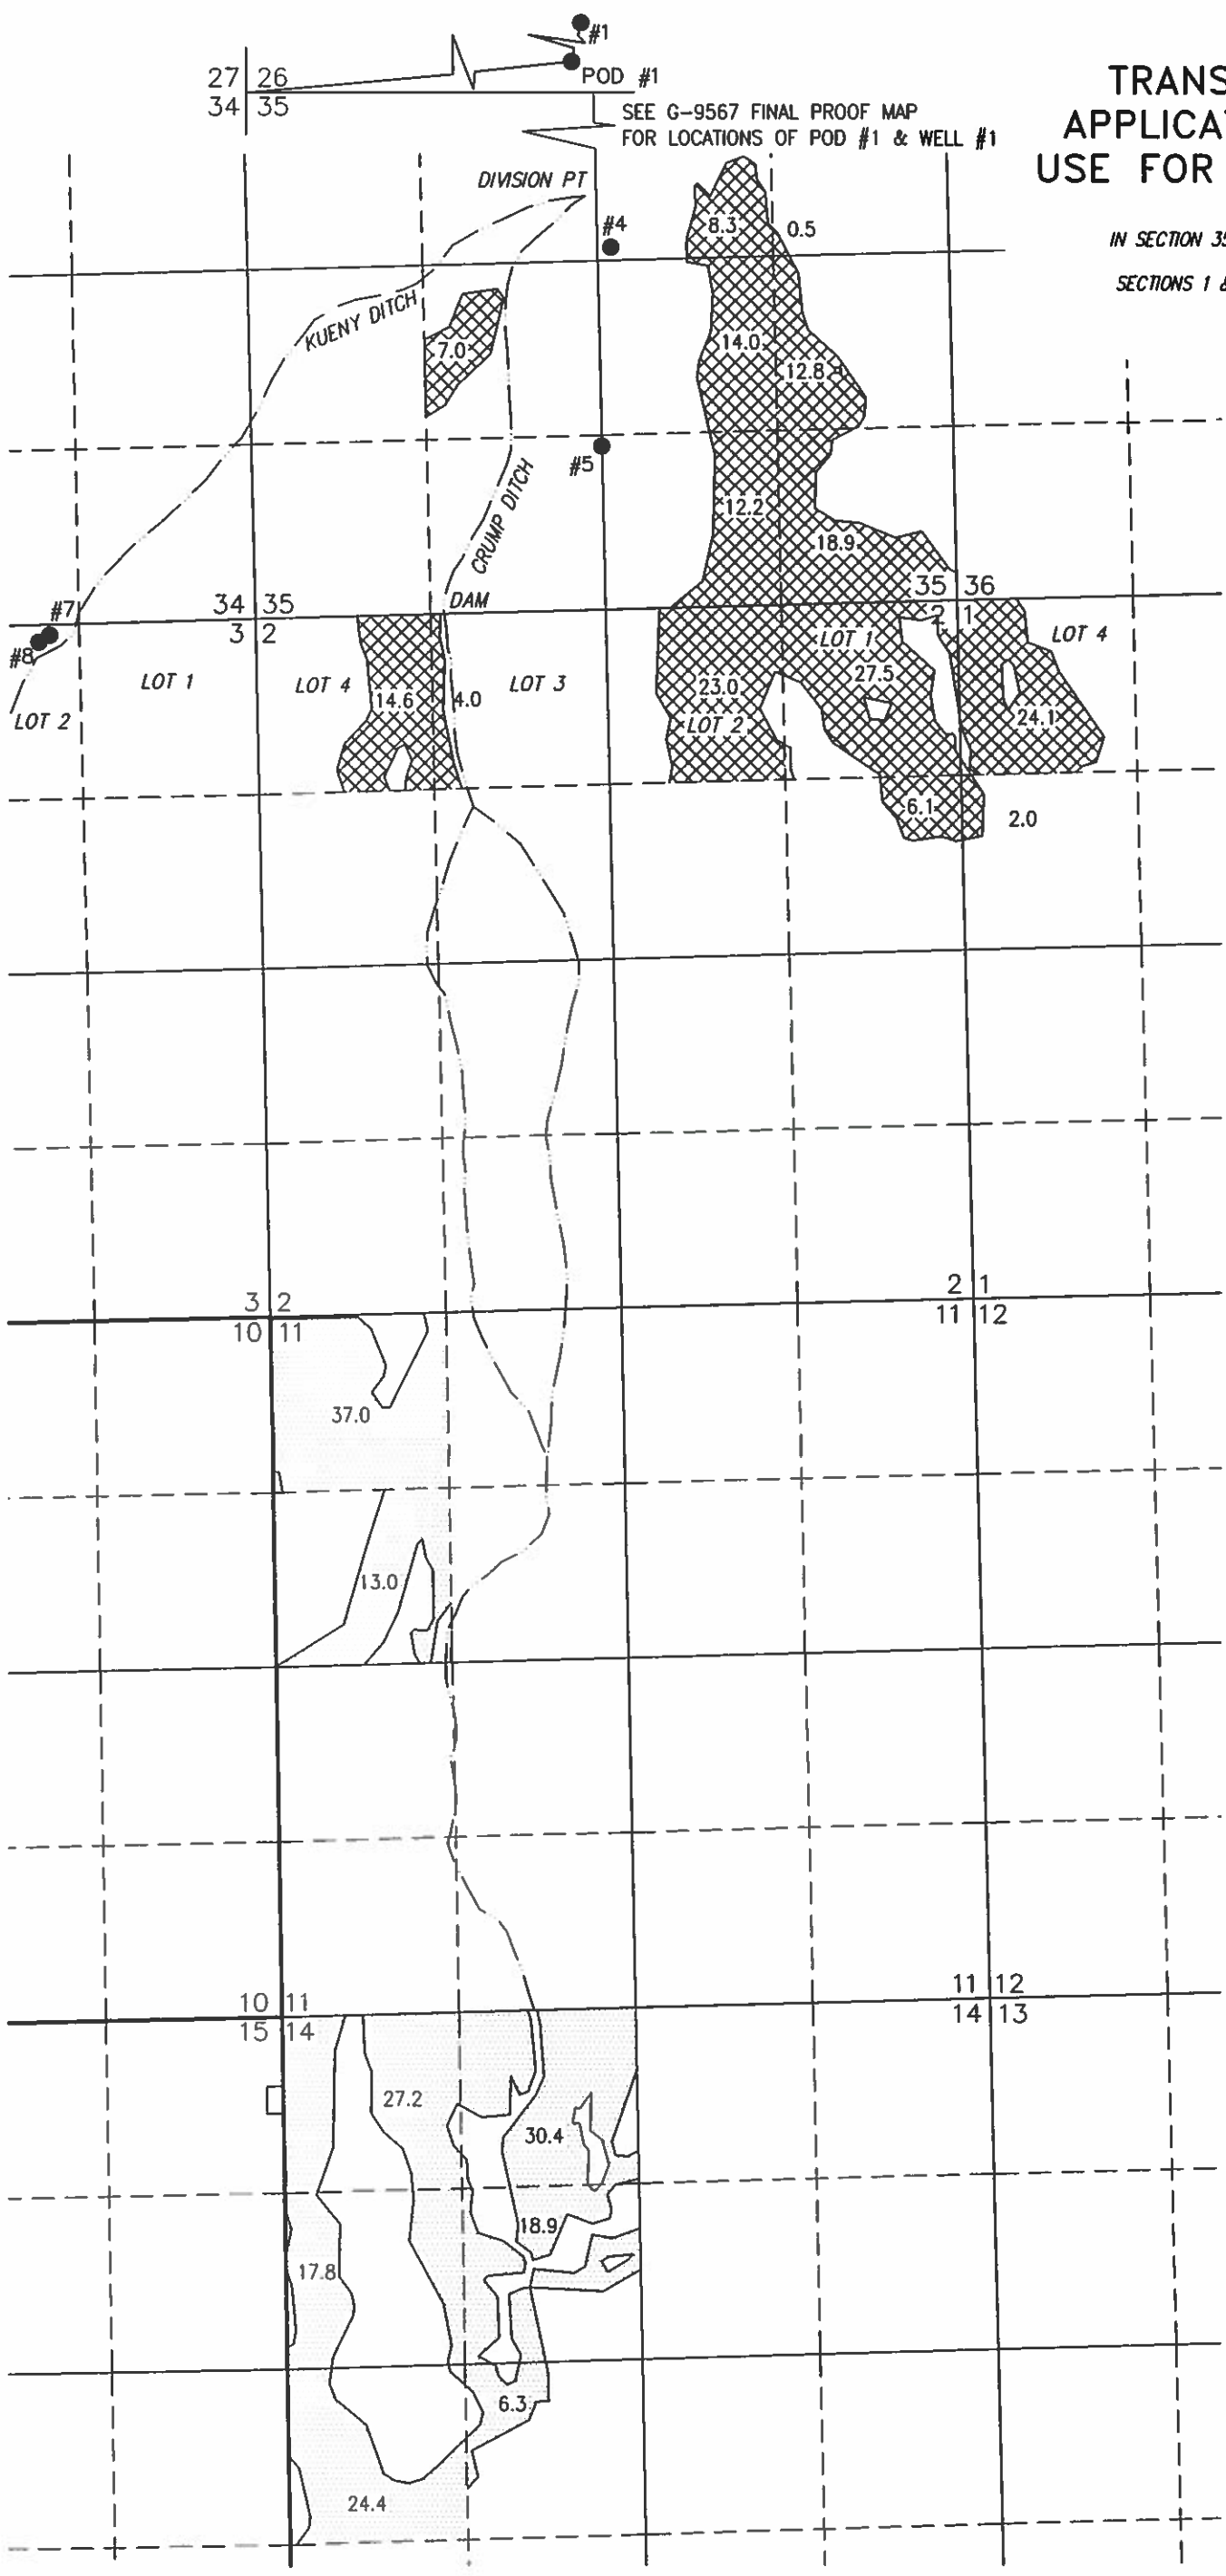


TRANSFER MAP TO ACCOMPANY
APPLICATION TO CHANGE PLACE OF
USE FOR DAVIS RANCHES AND FARMS

TAX LOT 2000
IN SECTION 35, TOWNSHIP 35 SOUTH, RANGE 33 EAST, W.M. &
TAX LOT 100
SECTIONS 1 & 2, TOWNSHIP 36 SOUTH, RANGE 33 EAST, W.M.
HARNEY COUNTY, OREGON

SW MAP
"TO"

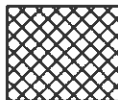

 175.0 ACRES 'IR' FROM POD #1
(DECREE TRACT 1) TRANSFERRED,
AS SHOWN


 175.0 ACRES 'IR' FROM POD #1
(DECREE TRACT 5) TRANSFERRED,
AS SHOWN

● **POD #1**
WILDHORSE CREEK DECREE
850' NORTH & 2570' EAST FROM THE SW
CORNER SECTION 26, T35S, R33E, W.M.

RECEIVED

JUL 25 2018

OWRD

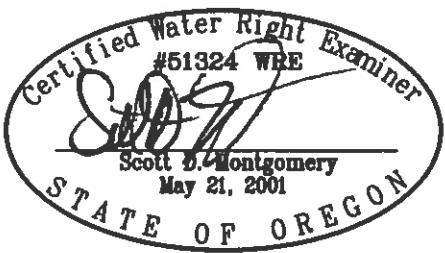

RENEWAL DATE: 12/31/2018

PROJECT No. 18-007

PREPARED AT THE REQUEST OF:
MIKE DAVIS
42970 KUENY RANCH LANE
PRINCETON, OR 97721

**ALL POINTS ENGINEERING
& SURVEYING, INC.**



P.O. BOX 767
TERREBONNE, OREGON 97760
(541) 548-5833 PH
(844) 273-9878 FX
www.APEandS.com

THIS MAP IS FOR THE PURPOSE OF
LOCATING A WATER RIGHT ONLY AND
HAS NO INTENT TO PROVIDE LEGAL
DIMENSIONS OR THE LOCATION OF
PROPERTY LINES.