

RECEIVED

SEP 2 1981

WATER RESOURCES DEPT.
SALEM, OREGON

Application No. **G-8769**
Permit No. **G 9529**

T.35&36S.R.33E.

APPLICATION NO. **G-8769** PERMIT NO.

IN NAME OF

CATLOW - STEENS CORP.

SUPPLEMENTAL IRRIGATION


- | | |
|---|---|
|  Wells 1 & 2 |  Wells 1, 2, & 3 |
|  Wells 1, 2, & 4 |  Wells 1, 2, 3, & 5 |
|  Wells 1, 2, & 5 |  Wells 1, 2, 4, 5, & 6 |


PRIMARY IRRIGATION

-  WELL 6


SCALE 4" = 1 MILE



-  WELL 6 (SUPPLEMENTAL)

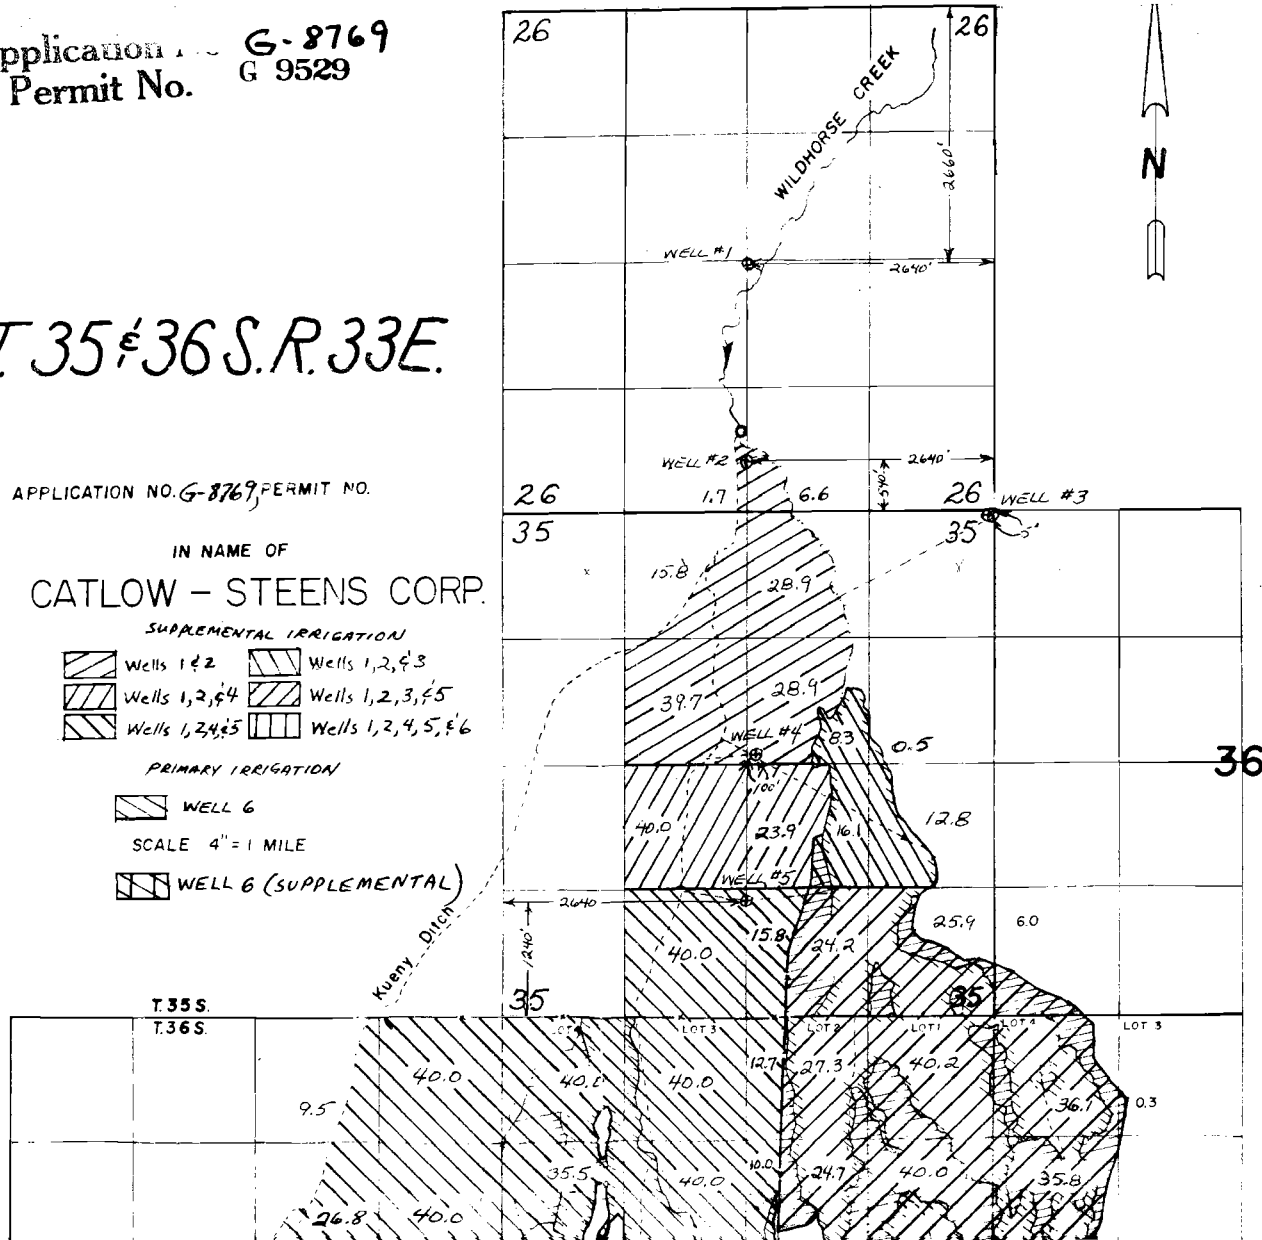

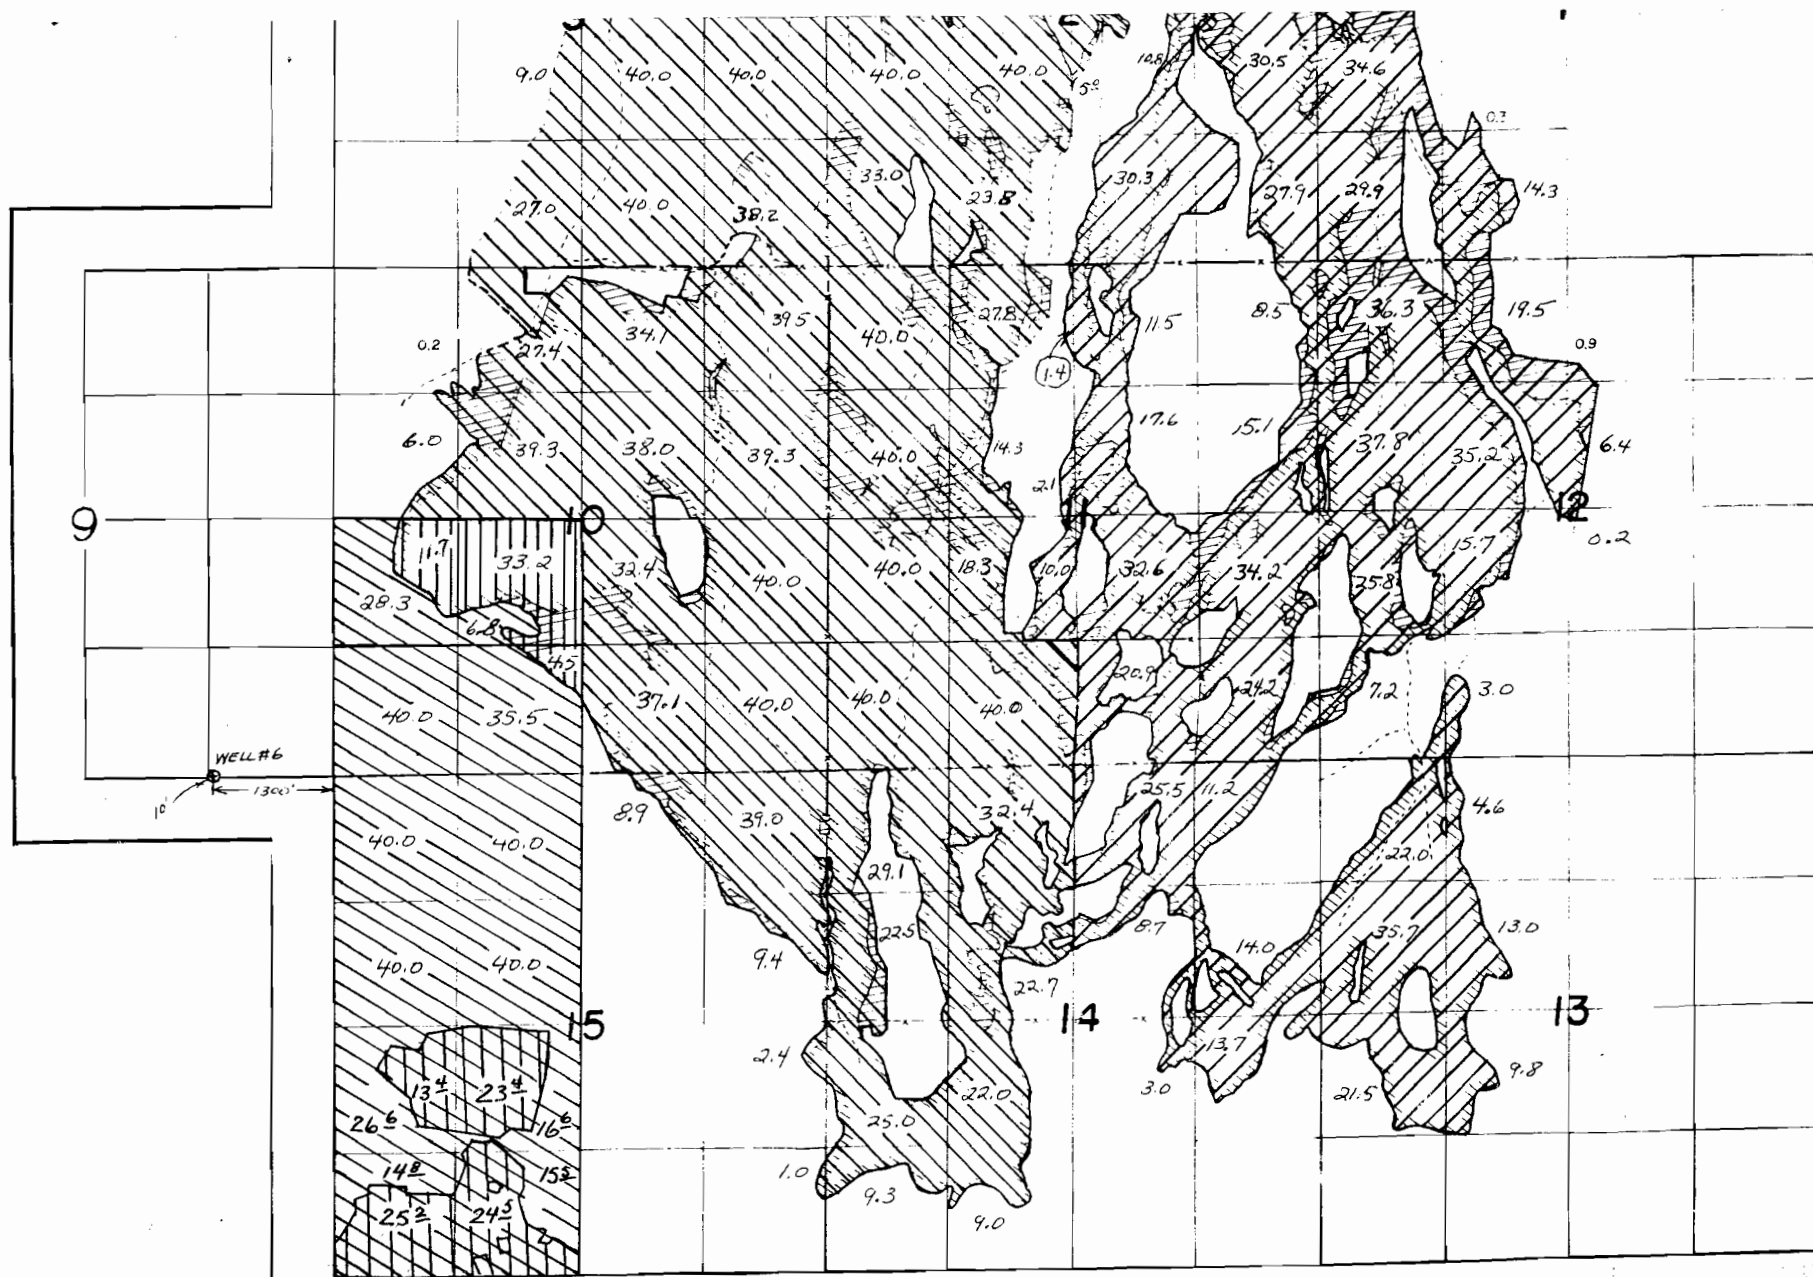

TAX LOT 100
IN SECTIONS 10 & 15, TOWNSHIP 36 SOUTH, RANGE 33 EAST, W.M.
HARNEY COUNTY, OREGON

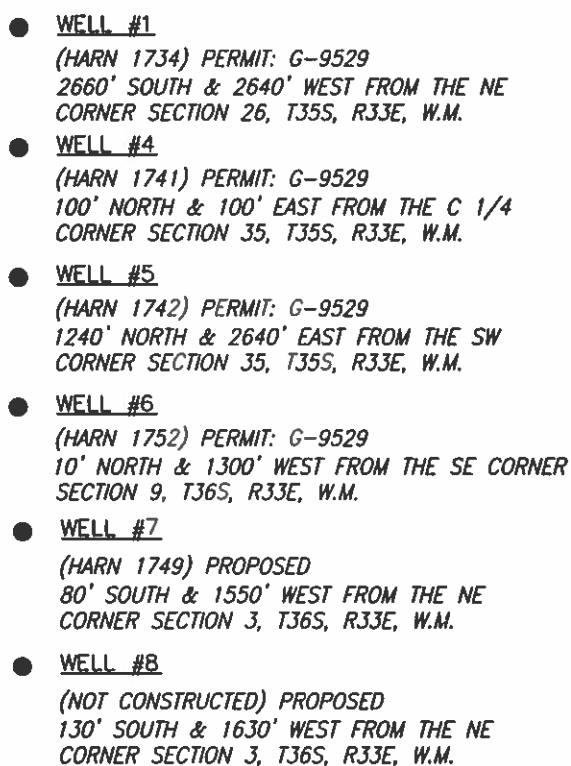

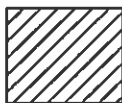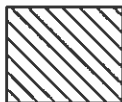- | | |
|---|---|
|  | 121.9 ACRES 'IR' FROM WELL 6 (C#84245)
PICKED UP, AS SHOWN |
|  | 121.9 ACRES 'IR' FROM WELL 6 (C#84245)
PUT DOWN, AS SHOWN |
|  | 152.2 ACRES 'IR' FROM WELL 6 (C#84245)
REMAIN, AS SHOWN |
|  | 70.2 ACRES 'IR' PUT DOWN FROM WELL 6
70.2 ACRES 'IS' FROM WELLS 1, 4, & 5
(C#84245) PICKED UP, AS SHOWN |
|  | 70.2 ACRES 'IS' PUT DOWN FROM WELLS
1, 4, 5, 6, 7, & 8
70.2 ACRES 'IR' PICKED UP FROM WELL 6
(C#84245), AS SHOWN |

Certified Water Right Examiner
 #51324 WRE
 Scott D. Montgomery
 May 21, 2001
 STATE OF OREGON

RENEWAL DATE: 12/31/2018

PREPARED AT THE REQUEST OF:
MIKE DAVIS
42970 KUENY RANCH LANE
PRINCETON, OR 97721

P.O. BOX 767
TERREBONNE, OREGON 97760
(541) 548-5833 PH
(844) 273-9878 FX
www.APEandS.com

THIS MAP IS FOR THE PURPOSE OF
LOCATING A WATER RIGHT ONLY AND
HAS NO INTENT TO PROVIDE LEGAL
DIMENSIONS OR THE LOCATION OF
PROPERTY LINES.