


Johnston Lane Allocation of Conserved Water

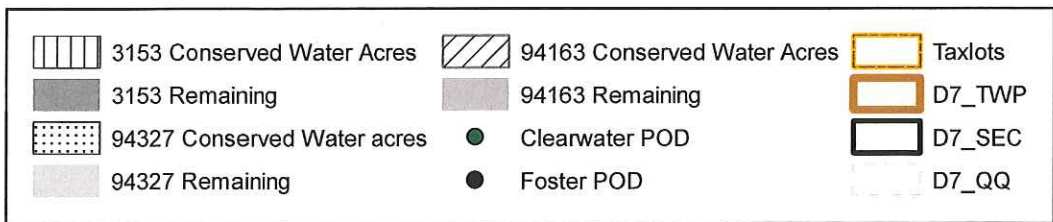


RECEIVED

APR 25 2019

OWRD

↑
N

1 in = 1,320 ft

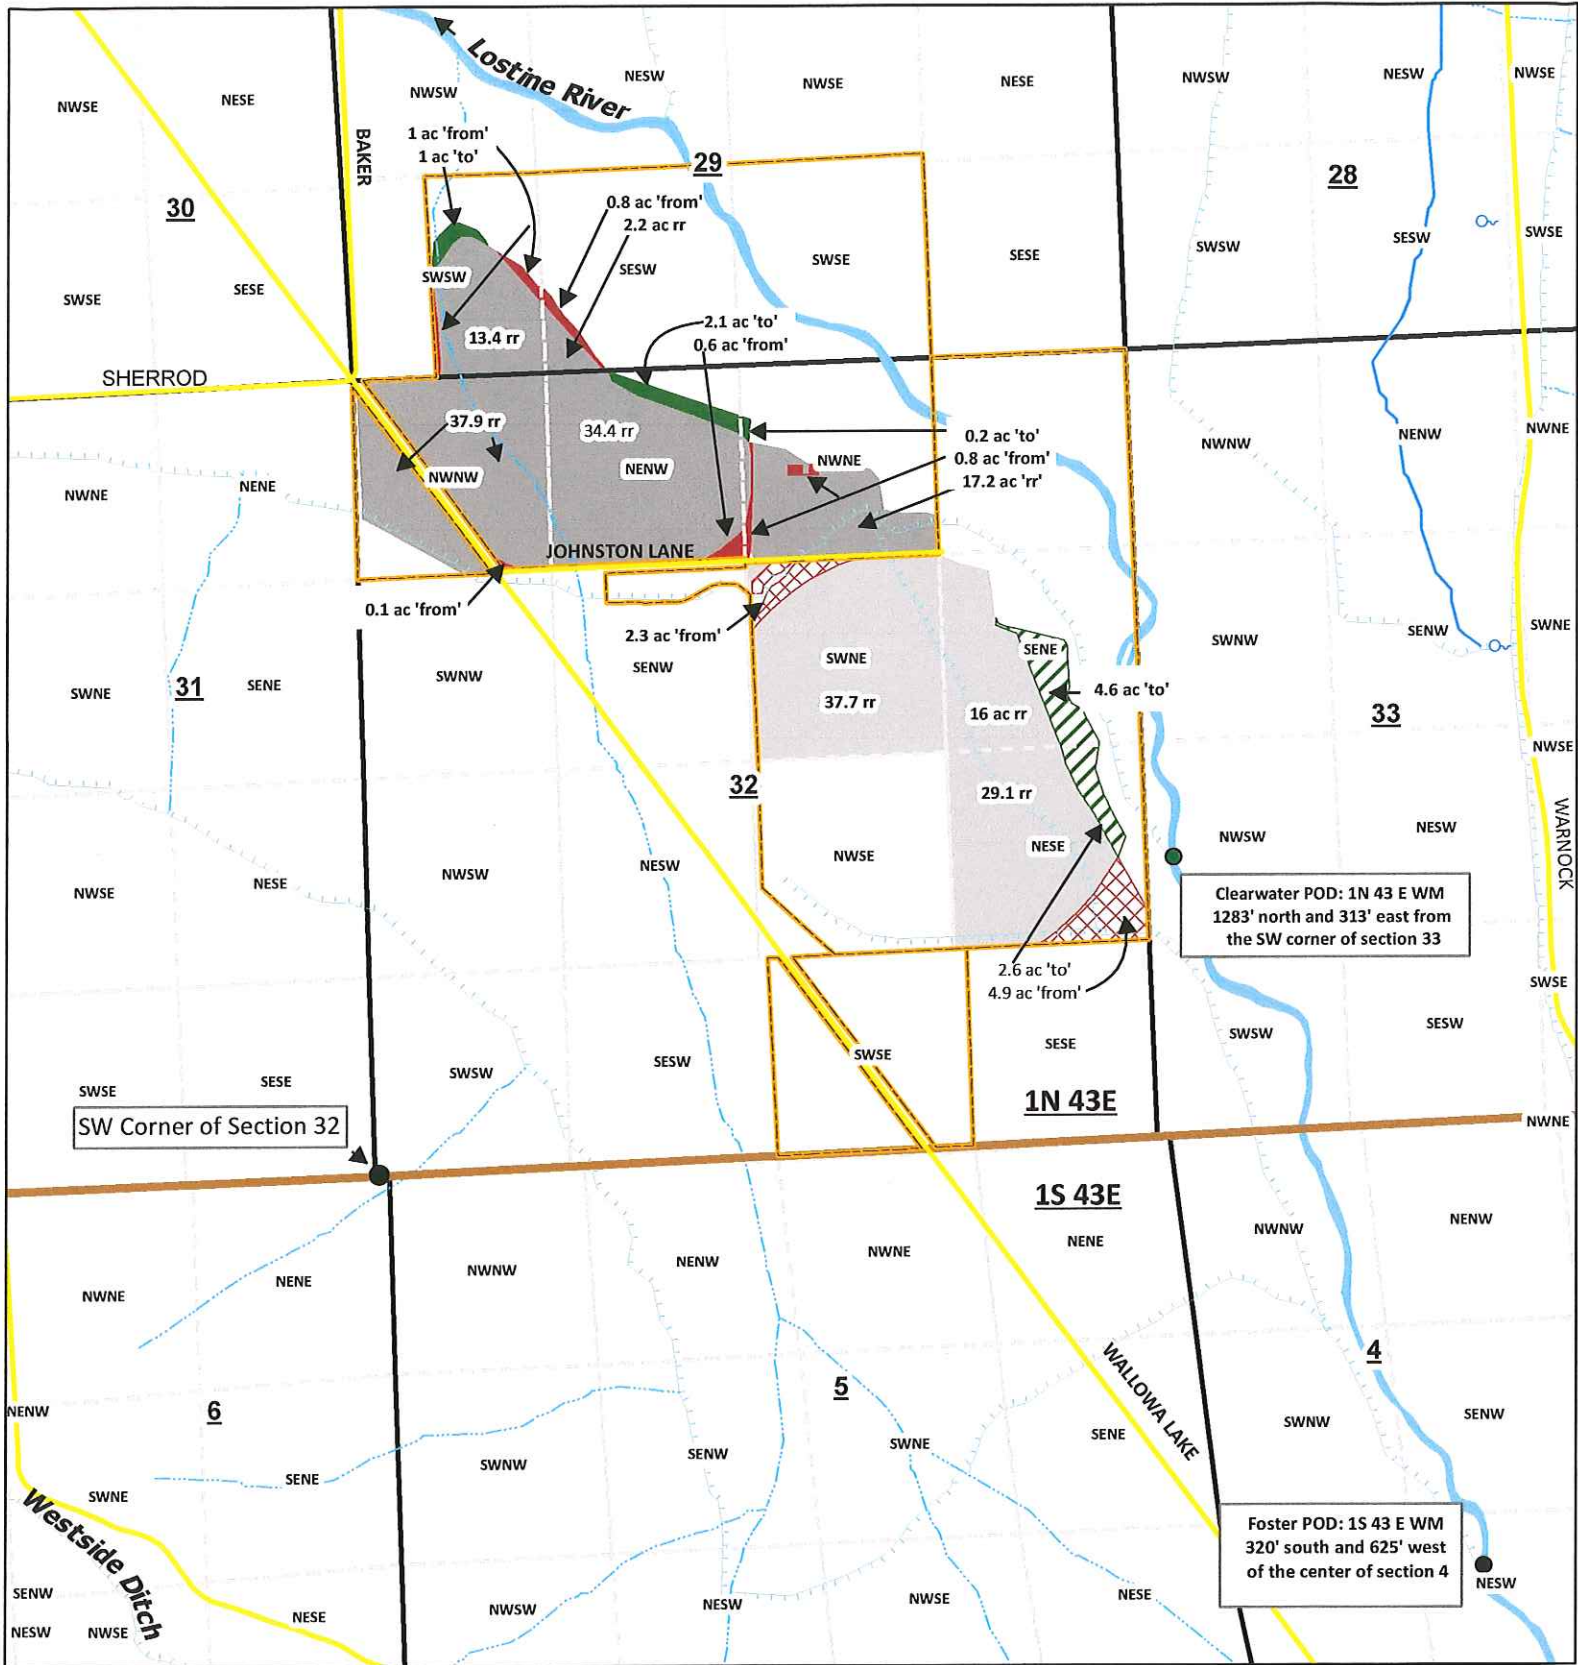

Proposed POU Transfer Certificates 3153 and 94327

	To Lands 94327		To Lands 3153		Clearwater POD		D7_TWP
	From Lands 94327		From Lands 3153		Foster POD		D7_SEC
	Remaining 94327		Remaining 3153		Taxlots		D7_QQ

RECEIVED
APR 25 2019



1 in = 1,320 ft