

T.1S. R.3E. Section 34, W.M.

Borges Road



RECEIVED June 30, 2021

Unnamed
Intermittent
Stream

TL 1 3E 34A 500

TL 1 3E 34A 600

Well 1 (CLAC 784) is located 890 feet south and 680 feet east from the N1/4 corner, Section 34.

Well 2 (CLAC 777) is located 2,060 feet south and 2,270 feet west from the NE corner, Section 34.

Area (35.6 Acres) of nursery operations under T- 8334, by 44 Acre Farms LLC.

Area (26.8 Acres) of nursery operations under T-8334, by David Tillstrom.

----- Tax lot boundary

SE 232nd Ave

SE 242nd Ave.

34

Tillstrom Road/Market Road


TL 1 3E 34A 800

RECEIVED

DEC 06 2019

OWRD

Scale: 1" = 400'

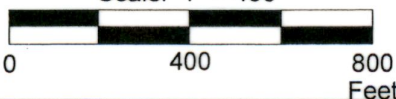

This map was prepared for the purpose of identifying the location of a water right only and is not intended to provide legal dimensions or location of property ownership lines.

Claim of Beneficial Use Map
T-8334

44 Acre Farms LLC and David and Michelle Tillstrom
T.1S., R.3E., Section 34 W.M.

12/2018
Rev. 12/2019

Pacific Hydro-Geology Inc.