


LAKE COUNTY
TOWNSHIP 29 SOUTH, RANGE 17 EAST, W.M.

RECEIVED

OCT 07 2010

WATER RESOURCES DEPT
SALEM, OREGON

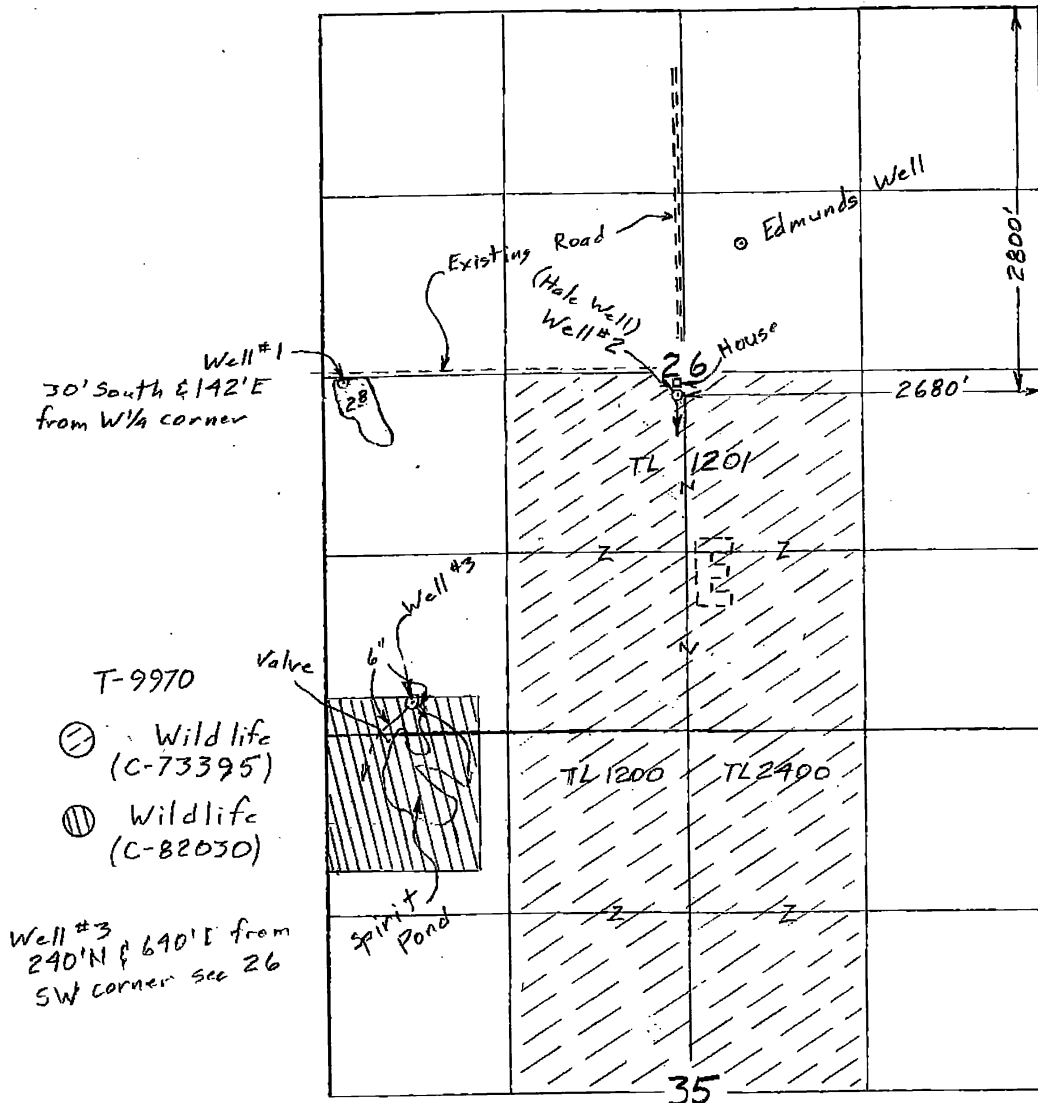


Scale 1" = 1320'
(4" = 1 mile)

T-9970

Surveyed July 3, 2009

Claim of Beneficial Use Map
for

DON & CAROL EDMUNDS

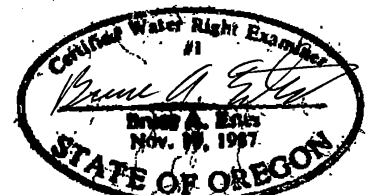

Renewal Dec 31, 2011

This map is for the purpose of
locating a water right only
and has no intent to provide
legal dimensions or the location
of property lines.

ESTES SURVEYS, LLC

PO Box 47540 60382 Arnold Rd
Salem, OR 97306-7540 Bend, OR 97702
(503) 645-7605 (541) 382-7394