

CLAIM OF BENEFICIAL USE


IN THE NAME OF: CLEAN WATER SERVICES

T2S, R1W, WM

RECEIVED BY OWRD

MAY 22 2015


SALEM, OR

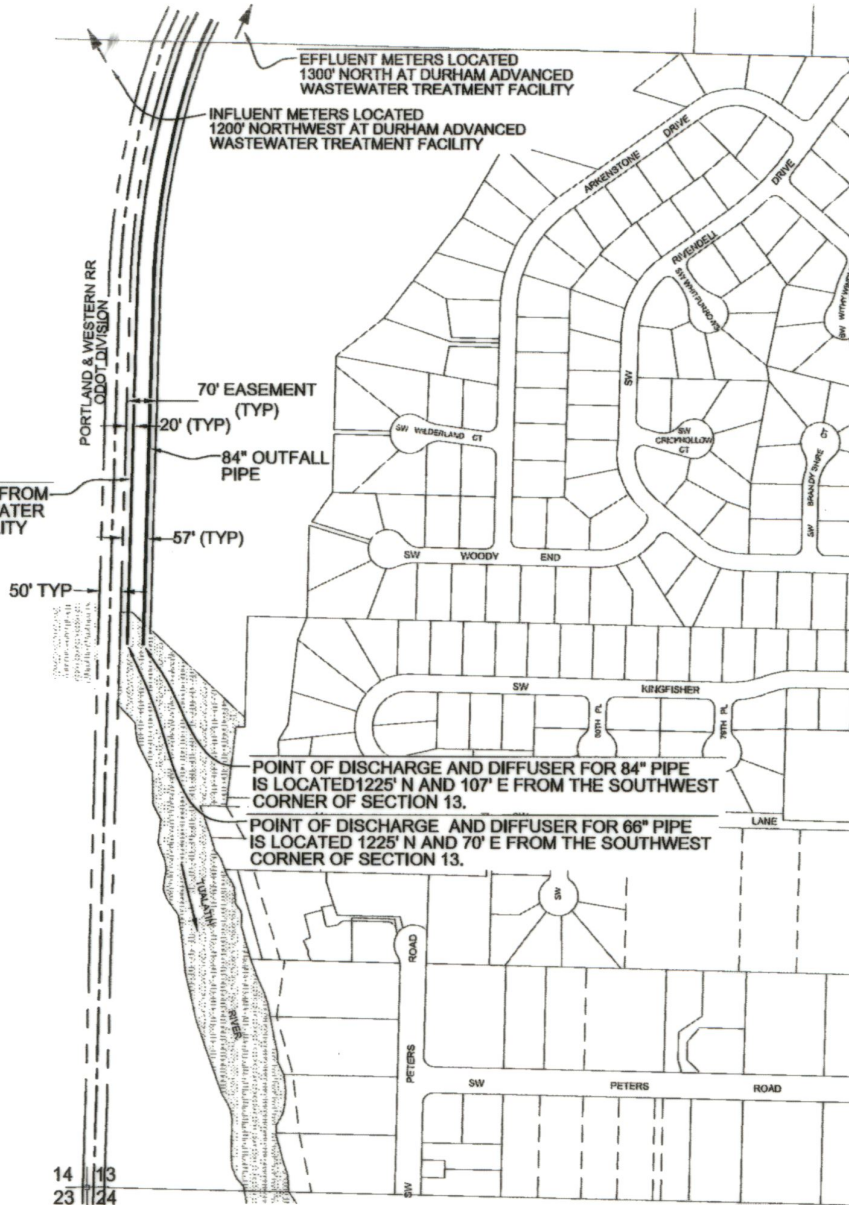

PLACE OF USE IS AS FOLLOWS: FROM THE POINT OF DISCHARGE, DOWNSTREAM IN THE TUALATIN RIVER TO THE CONFLUENCE WITH THE WILLAMETTE RIVER LOCATED WITHIN THE SW ¼, SECTION 2, T3S, R2E, WM.

APPLICATION NUMBER: S-86703
PERMIT NUMBER: S-54475

THIS MAP IS NOT INTENDED TO PROVIDE LEGAL DIMENSIONS OR LOCATIONS OF PROPERTY OWNERSHIP LINES.

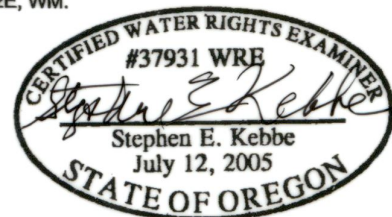

EXPIRATION DATE: 06/30/2017