



Township 2 North, Range 32 East, W.M. SW 1/4 NE 1/4 of Section 34

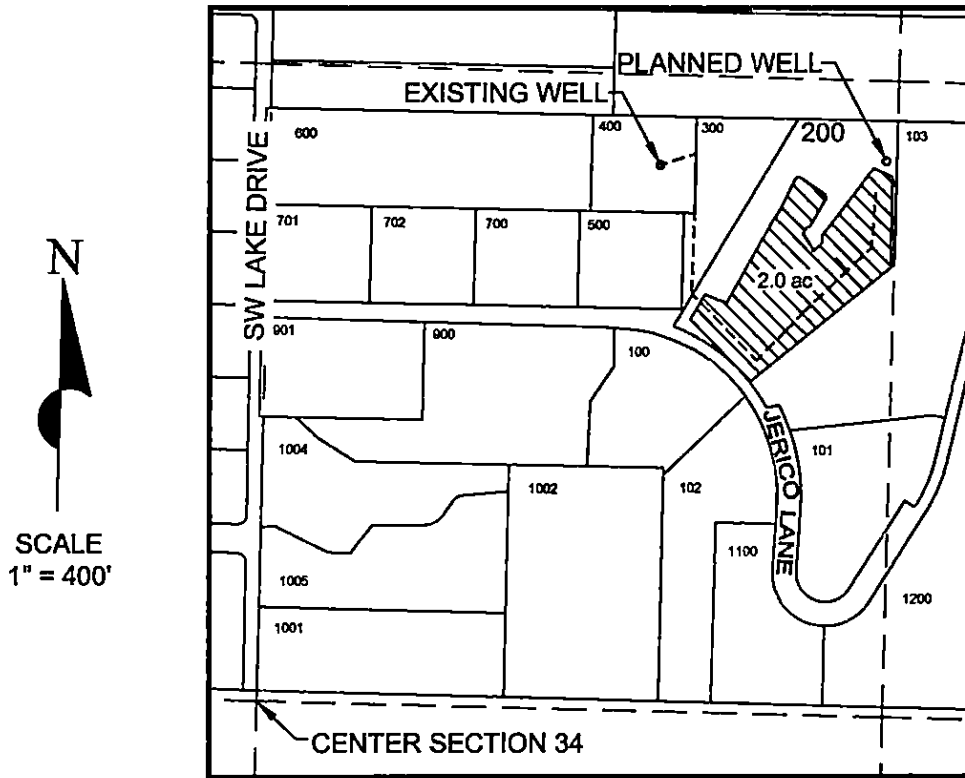

EXISTING WELL: LOCATED 1120' NORTH AND 820' EAST FROM CENTER OF SECTION 34
(1530' SOUTH AND 1810' WEST FROM NE CORNER OF SECTION 34)

Legend

- Quarter-Quarter Section Lines
- Tax Lots
-  2.0 acres under Beneficial Use
- Buried Pipeline
- o Well

CLAIM OF BENEFICIAL USE MAP under


Permit No. G-8969 Certificate No. 53749

Transfer T-10566

in name of

GUY KRISZA

June 11th, 2018

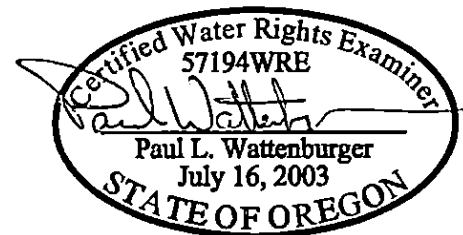

RECEIVED

JUN 28 2018

OWRE

EXPIRES: 6/30/18-

THIS MAP WAS PREPARED FOR THE PURPOSE OF IDENTIFYING THE LOCATION OF A WATER RIGHT ONLY AND IS NOT INTENDED TO PROVIDE LEGAL DIMENSIONS OR LOCATION OF PROPERTY OWNERSHIP LINES.

6/30/20 PW