


#1201

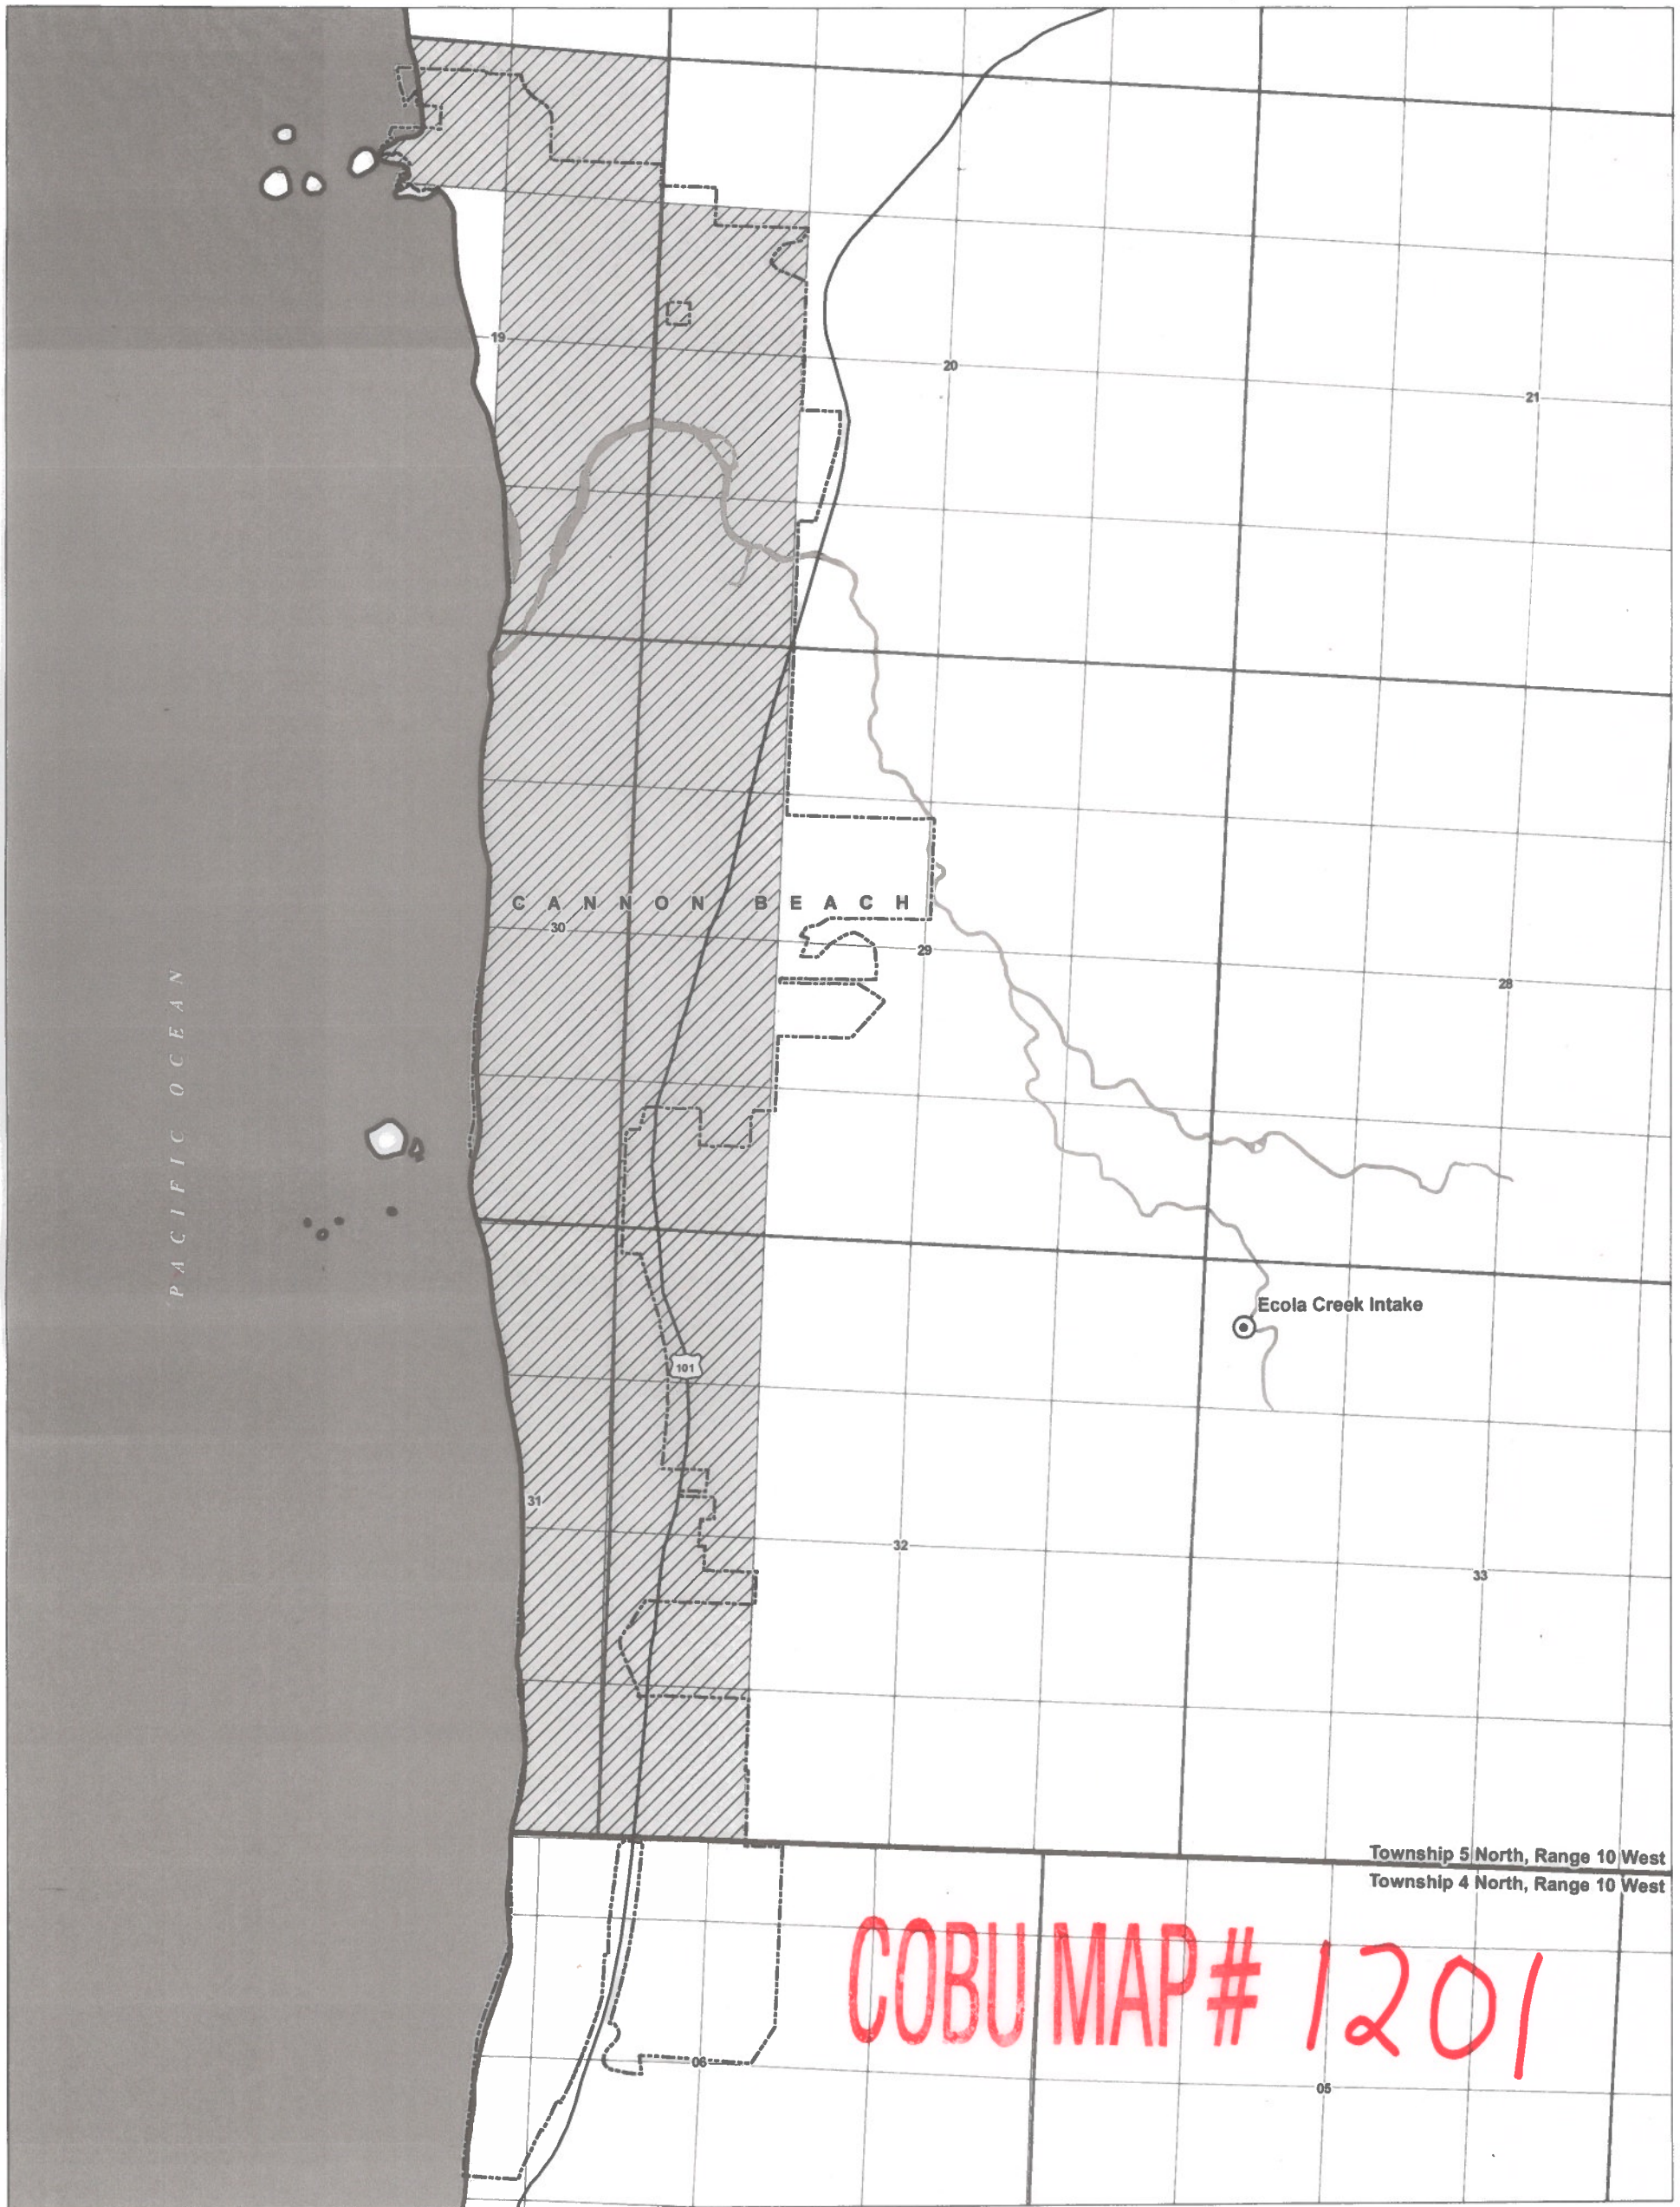

LEGEND


- Point of Diversion (POD)
- Major Road
- Place of Use (POU)
- Watercourse
- City Boundary
- Waterbody

DISCLAIMER

This map was prepared for the purpose of identifying the location of a water right only and it is not intended to provide legal dimensions or location of property ownership lines.

Date: June 21, 2019
Data Sources: BLM, OWRD, USGS, ESRI

Certified Water Rights Examiner Stamp

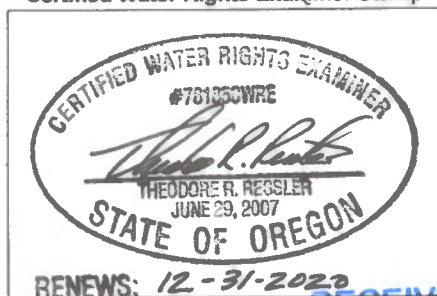

**Claim of Beneficial Use - Place of Use
Permit S-41717 (Application S-55694)**

**A Water Right in the Name of
City of Cannon Beach**

Clatsop County, Oregon
Township 5 North, Range 10 West, (W.M.)



0 750 1,500 2,250
Feet



RECEIVED

AUG 12 2019

OWRD



RECEIVED
AUG 12 2019
OWRD

Certified Water Rights Examiner Stamp



RENEWS: 12-31-2020

LEGEND

- ⊙ Point of Diversion (POD)
- Watercourse
- Road
- Waterbody

POD LOCATION DESCRIPTION

Point of Diversion
Located 810 feet South and 380 feet East from the NW corner of Section 33, Township 5 North, Range 10 West (W.M.)

DISCLAIMER

This map was prepared for the purpose of identifying the location of a water right only and it is not intended to provide legal dimensions or location of property ownership lines.

Date: June 21, 2019
Data Sources: BLS, OWRD, USGS, EBR

Document Path: Y:\0732 Cannon Beach\Source Figures\002 COBU\COBU S_55694_POD.mxd

**Claim of Beneficial Use - Point of Diversion
Permit S-41717 (Application S-55694)**

**A Water Right in the Name of
City of Cannon Beach**

**Clatsop County, Oregon
Township 5 North, Range 10 West, (W.M.)**

