


G-9311
64434
75829
T8028

T.27S.,R.17&18E.,W.M.

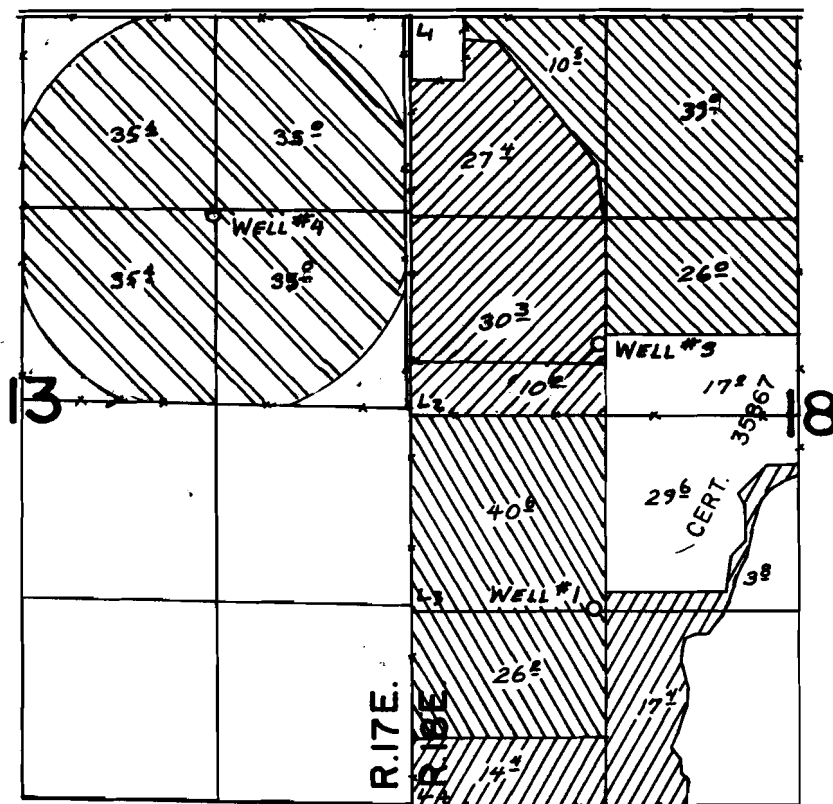


WELL #1 - 4040 ft. S and 1240 ft. E } all from the NW Cor.
WELL #3 - 2240 ft. S and 1290 ft. E } Sec. 18
WELL #4 - 1350 ft. S and 1350 ft. W }

FINAL PROOF SURVEY

G-7737

G-7191

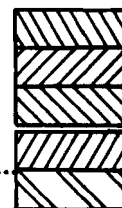

WELL 1- PRIMARY
WELL 3- PRIMARY
WELL 3- SUPPLEMENTAL
WELL 1- PRIMARY
WELL 4- PRIMARY

Application No. G-9385 Permit No. G-9311.....
IN NAME OF

JACK L. GILLETTE.....

Surveyed OCT. 28, 1981, by L.T.OLL.....

LAKE 1135 G-1224, G-7191, & G-9311

● #1 WELL LOCATED IN THE SW 1/4 SW 1/4 AND 4040 FEET SOUTH AND 1240 FEET EAST FROM THE NORTHWEST CORNER OF SECTION 18.

LAKE 1112 G-1224, G-6261, G-7191, & G-9311

● #2 WELL LOCATED IN THE NE 1/4 SW 1/4 AND 1320 FEET NORTH AND 1958 FEET EAST FROM THE SOUTHWEST CORNER OF SECTION 7.

LAKE 1136 G-1224, G-7191, & G-9311

● #3 WELL LOCATED IN THE SW 1/4 NW 1/4 AND 2240 FEET SOUTH AND 1290 FEET EAST FROM THE NORTHWEST CORNER OF SECTION 18.

LAKE 996 G-9311

● #4 WELL LOCATED IN THE SW 1/4 NE 1/4 AND 1350 FEET SOUTH AND 1350 FEET WEST FROM THE NORTHEAST CORNER OF SECTION 13.

LAKE 990 G-8248

● #8 WELL LOCATED IN THE SW 1/4 SW 1/4 AND 1360 FEET SOUTH AND 1320 FEET EAST FROM THE WEST 1/4 CORNER OF SECTION 13.

LAKE 52360 G-6261, G-7191, G-8248, & G-9311


● #9 WELL LOCATED IN THE SE 1/4 NE 1/4 AND 0 FEET SOUTH AND 1320 FEET WEST FROM THE EAST 1/4 CORNER OF SECTION 17.

TAX LOTS 2400 AND 2600
IN SECTION 13, TOWNSHIP 27 SOUTH, RANGE 17 EAST, W.M.
LAKE COUNTY, OREGON

TAX LOTS 2701 AND 2800
IN SECTION 7
AND
TAX LOTS 2801 AND 3801
IN SECTION 18
TOWNSHIP 27 SOUTH, RANGE 18 EAST, W.M.
LAKE COUNTY, OREGON

MAP TO ACCOMPANY APPLICATION TO CHANGE PLACE OF USE AND POINT OF APPROPRIATION FOR JACK L. AND KATHERINE GILLETTE

SCALE 4" = 1 MILE

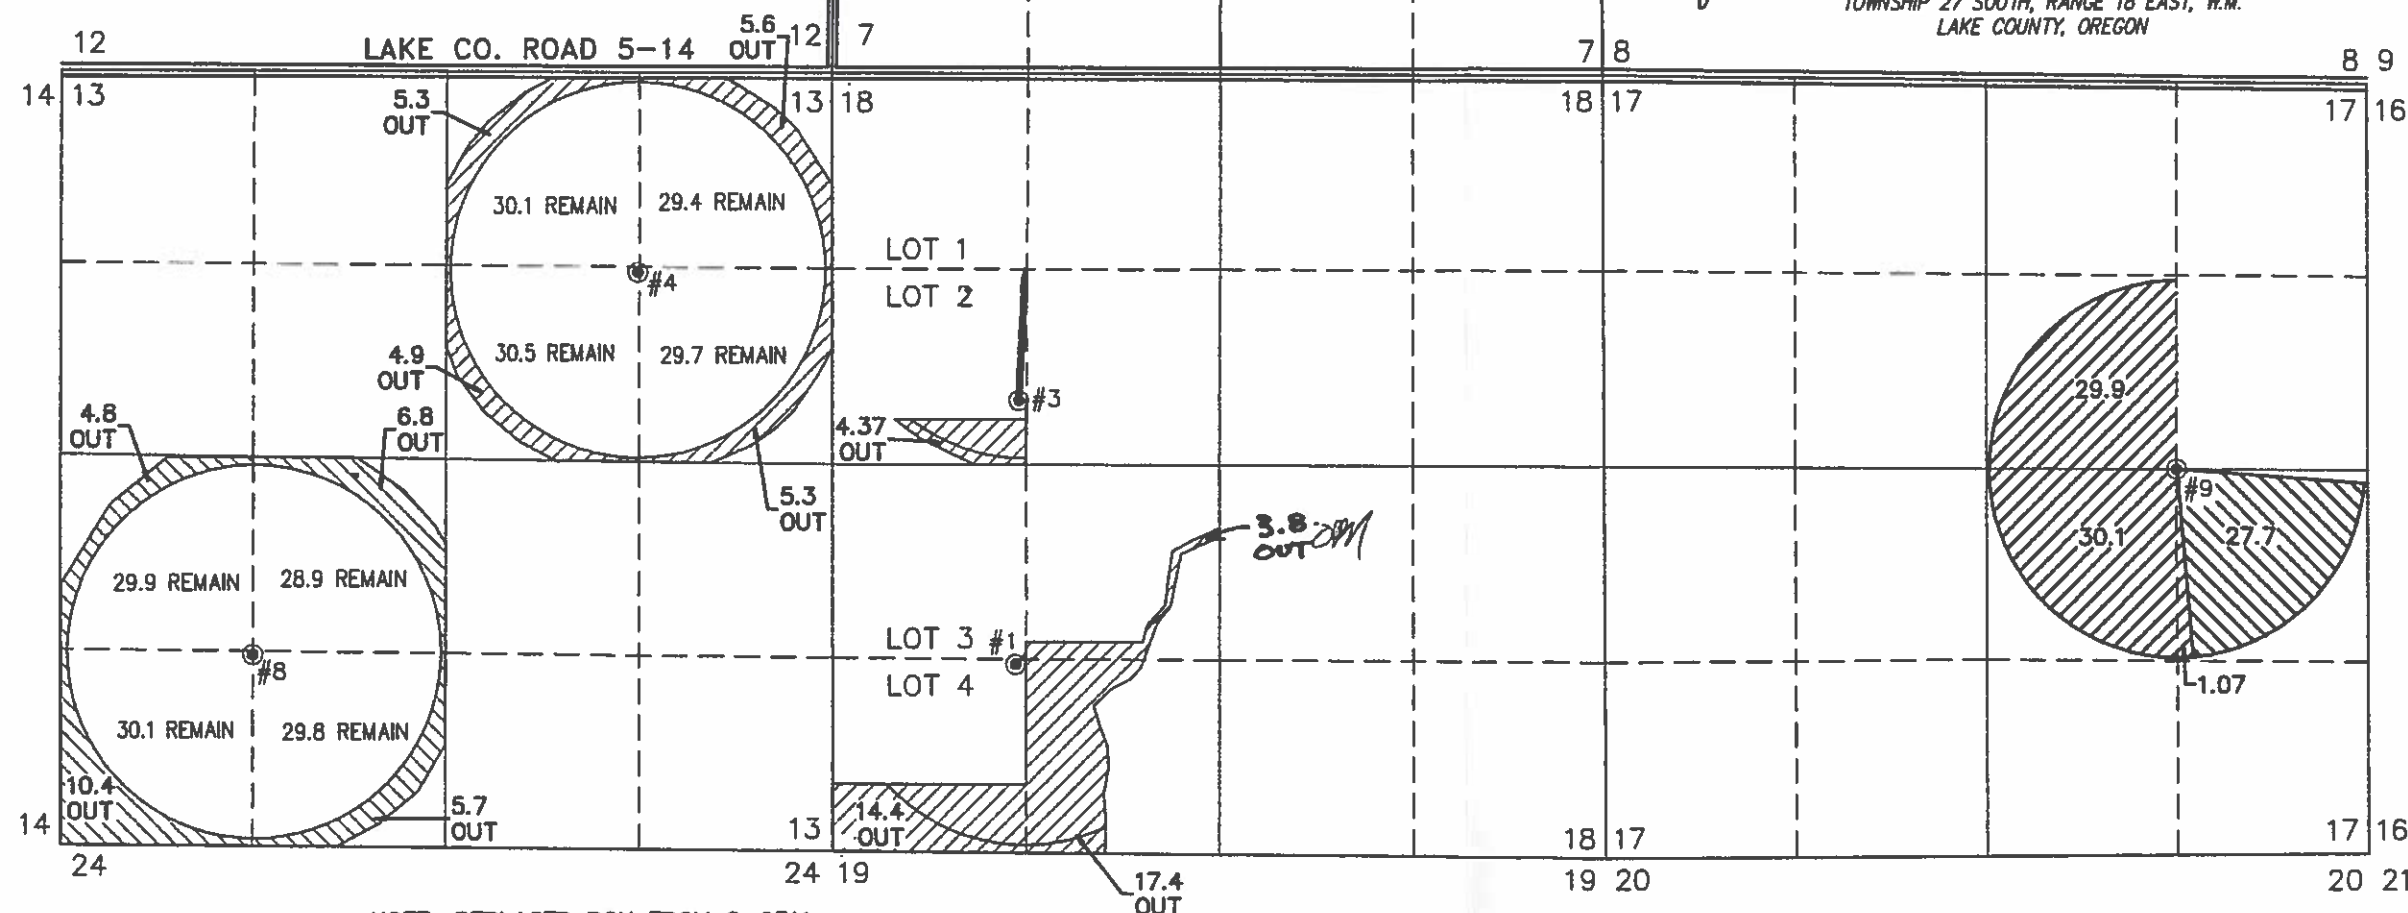

- 27.7 ACRES WATER RIGHTS FROM C #54692 (G-8248) TRANSFERRED, AS SHOWN.
- 61.07 ACRES WATER RIGHTS FROM C #75829 (G-9311) TRANSFERRED, AS SHOWN.
- 15.27 ACRES WATER RIGHTS FROM C #85938 (G-1224) TRANSFERRED, AS SHOWN.
- 15.2 ACRES WATER RIGHTS FROM C #75830 (G-1224) TRANSFERRED, AS SHOWN.
- 11.8 ACRES WATER RIGHTS FROM C #85939 (G-6261) TRANSFERRED, AS SHOWN.
- 16.5 ACRES WATER RIGHTS FROM C #85931 (G-6261) TRANSFERRED, AS SHOWN.
- 4.58 ACRES WATER RIGHTS FROM C #85940 (G-7191) TRANSFERRED, AS SHOWN.
- 15.3 ACRES WATER RIGHTS FROM C #75828 (G-7191) TRANSFERRED, AS SHOWN.

RECEIVED BY OWRD

AUG 31 2016

SALEM, OR

THIS MAP IS FOR THE PURPOSE OF LOCATING A WATER RIGHT ONLY AND HAS NO INTENT TO PROVIDE LEGAL DIMENSIONS OR THE LOCATION OF PROPERTY LINES.

PROJECT No. 12-002

PREPARED AT THE REQUEST OF:

GILLETTE RANCH
P.O. BOX 556
CHRISTMAS VALLEY, OR 97641

ALL POINTS ENGINEERING
& SURVEYING, INC.



P.O. BOX 767 (CRR)
TERREBONNE, OREGON 97760
(541) 548-5833 PH
(541) 585-4602 FX
www.APEandS.com



RENEWAL DATE: 12/31/2012

T 12468