


G. 1224

35867 -CW
75836
T8628

T.27S.R.17&18E.W.M.

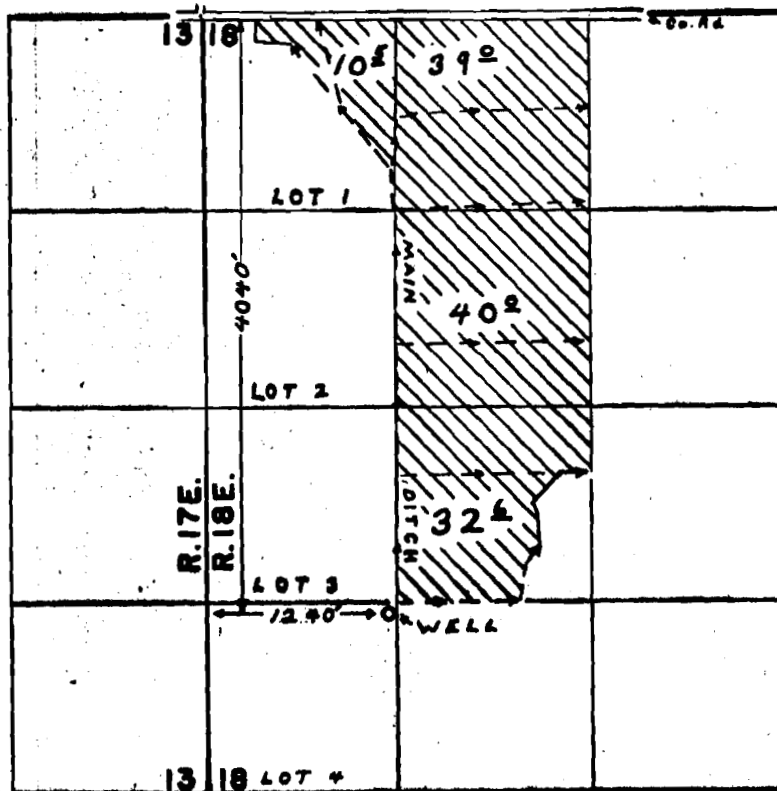

FINAL PROOF SURVEY
UNDER

Application No. 8-1326. Permit No. 8-1224.
IN NAME OF

JACK L. and E. CATHERINE GILLETTE

Surveyed AUG. 7. 1968, by L. E. SOULD


MAP TO ACCOMPANY APPLICATION TO CHANGE PLACE OF USE AND POINT OF APPROPRIATION FOR GILLETTE LIVING TRUST & SANDRA OVERTON

- LAKE 1135 G-1224, G-7191, & G-9311
- #1 WELL LOCATED IN THE SW 1/4 SW 1/4 AND 4040 FEET SOUTH AND 1240 FEET EAST FROM THE NORTHWEST CORNER OF SECTION 18.
- LAKE 1112 G-1224, G-6261, G-7191, & G-9311
- #2 WELL LOCATED IN THE NE 1/4 SW 1/4 AND 1320 FEET NORTH AND 1958 FEET EAST FROM THE SOUTHWEST CORNER OF SECTION 7.
- LAKE 1136 G-1224, G-7191, & G-9311
- #3 WELL LOCATED IN THE SW 1/4 NW 1/4 AND 2240 FEET SOUTH AND 1290 FEET EAST FROM THE NORTHWEST CORNER OF SECTION 18.
- LAKE 996 G-9311
- #4 WELL LOCATED IN THE SW 1/4 NE 1/4 AND 1350 FEET SOUTH AND 1350 FEET WEST FROM THE NORTHEAST CORNER OF SECTION 13.
- LAKE 990 G-8248
- #8 WELL LOCATED IN THE SW 1/4 SW 1/4 AND 1360 FEET SOUTH AND 1320 FEET EAST FROM THE WEST 1/4 CORNER OF SECTION 13.
- LAKE 52360 G-6261, G-7191, G-8248, & G-9311
- #9 WELL LOCATED IN THE SE 1/4 NE 1/4 AND 0 FEET SOUTH AND 1320 FEET WEST FROM THE EAST 1/4 CORNER OF SECTION 17.

TAX LOTS 2701 AND 2800
IN SECTION 7
AND
TAX LOTS 2801 AND 3801
IN SECTION 18
TOWNSHIP 27 SOUTH, RANGE 18 EAST, W.M.
LAKE COUNTY, OREGON

TAX LOTS 2400 AND 2600
IN SECTION 13, TOWNSHIP 27 SOUTH, RANGE 17 EAST, W.M.
LAKE COUNTY, OREGON

TAX LOTS 1900 AND 2400
IN SECTION 17
TOWNSHIP 27 SOUTH, RANGE 18 EAST, W.M.
LAKE COUNTY, OREGON

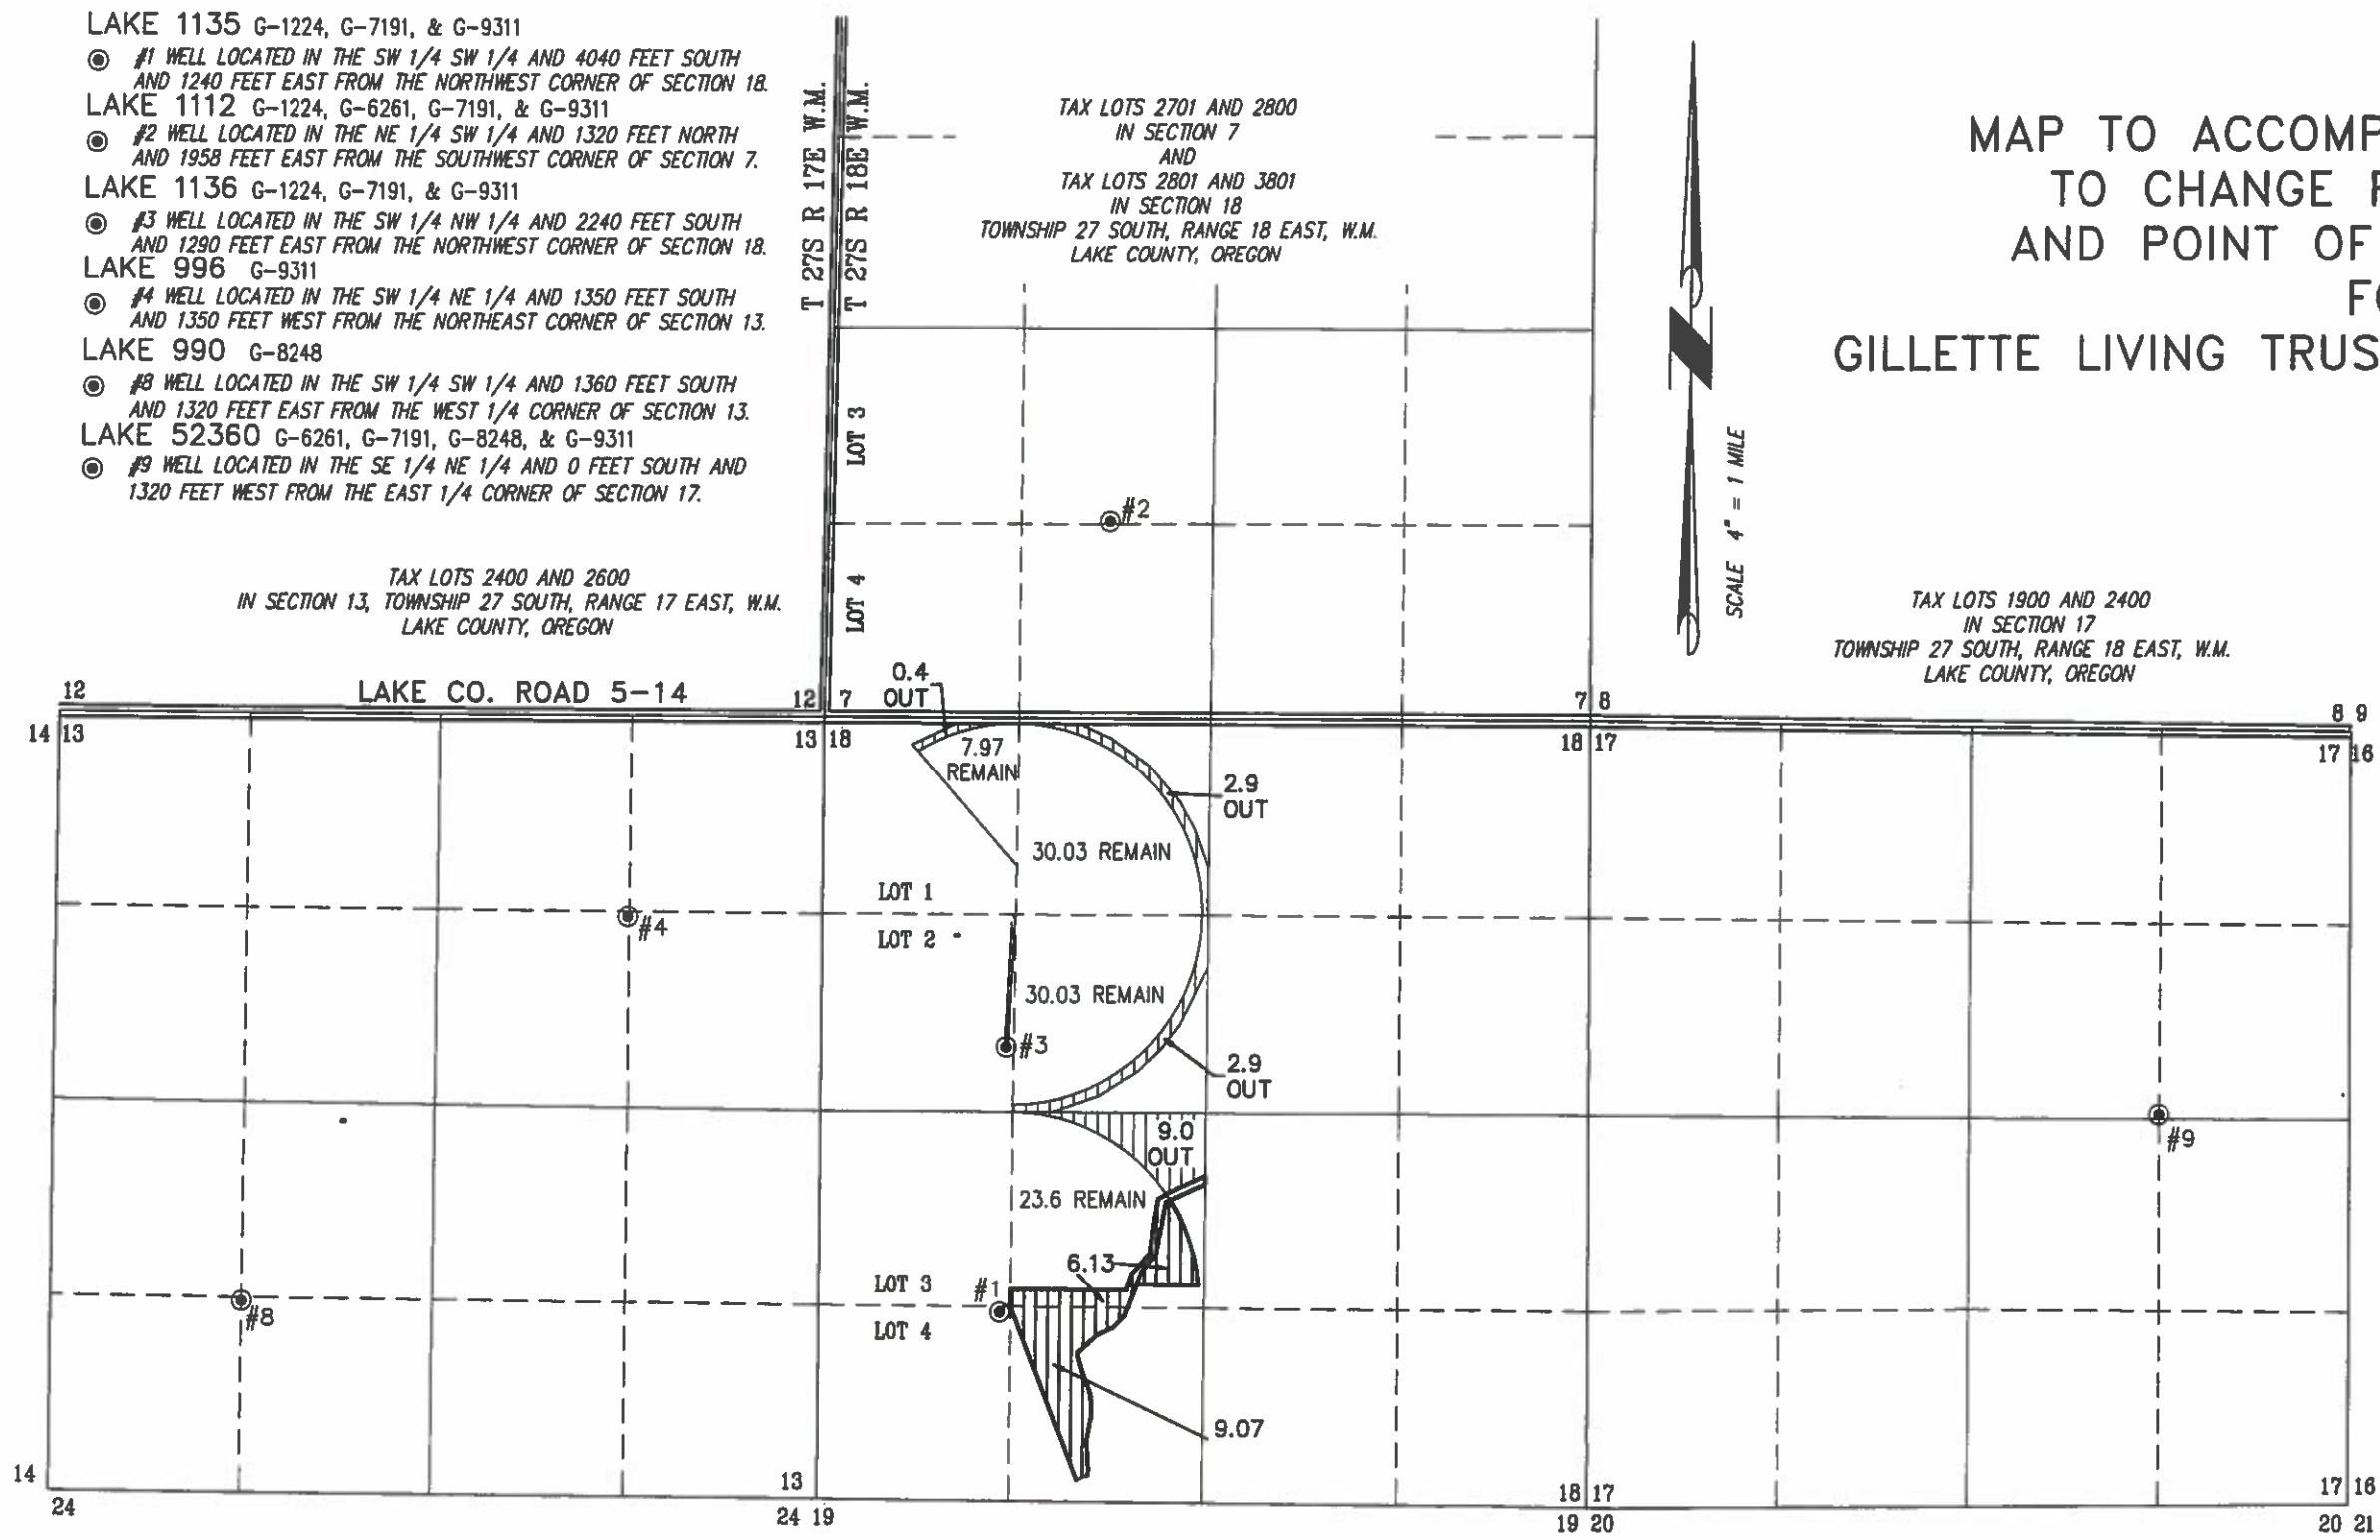

- 27.7 ACRES WATER RIGHTS FROM C #54692 (G-8248) TRANSFERRED, AS SHOWN.
- 61.07 ACRES WATER RIGHTS FROM C #75829 (G-9311) TRANSFERRED, AS SHOWN.
- 15.27 ACRES WATER RIGHTS FROM C #85938 (G-1224) TRANSFERRED, AS SHOWN.
- 15.2 ACRES WATER RIGHTS FROM C #75830 (G-1224) TRANSFERRED, AS SHOWN.
- 11.8 ACRES WATER RIGHTS FROM C #85939 (G-6261) TRANSFERRED, AS SHOWN.
- 16.5 ACRES WATER RIGHTS FROM C #75831 (G-6261) TRANSFERRED, AS SHOWN.
- 4.58 ACRES WATER RIGHTS FROM C #85940 (G-7191) TRANSFERRED, AS SHOWN.
- 15.3 ACRES WATER RIGHTS FROM C #75828 (G-7191) TRANSFERRED, AS SHOWN.

RECEIVED BY OWRD

SEP 08 2016

SALEM, OR

NOTE: REPLACED POU FROM G-9311
TO BE TRANSFERRED TO NEW PIVOT

THIS MAP IS FOR THE PURPOSE OF LOCATING A WATER RIGHT ONLY AND HAS NO
INTENT TO PROVIDE LEGAL DIMENSIONS OR THE LOCATION OF PROPERTY LINES.

PROJECT No. 15-129

PREPARED AT THE REQUEST OF:

SANDRA OVERTON
P.O. BOX 556
CHRISTMAS VALLEY, OR 97641

ALL POINTS ENGINEERING
& SURVEYING, INC.

P.O. BOX 767
TERREBONNE, OREGON 97760
(541) 548-5833 PH
Scott@APEandS.com
www.APEandS.com

Certified Water Right Examiner
#61324 WRE
Scott D. Montgomery
May 21, 2001
STATE OF OREGON
RENEWAL DATE: 12/31/2016

T-12468