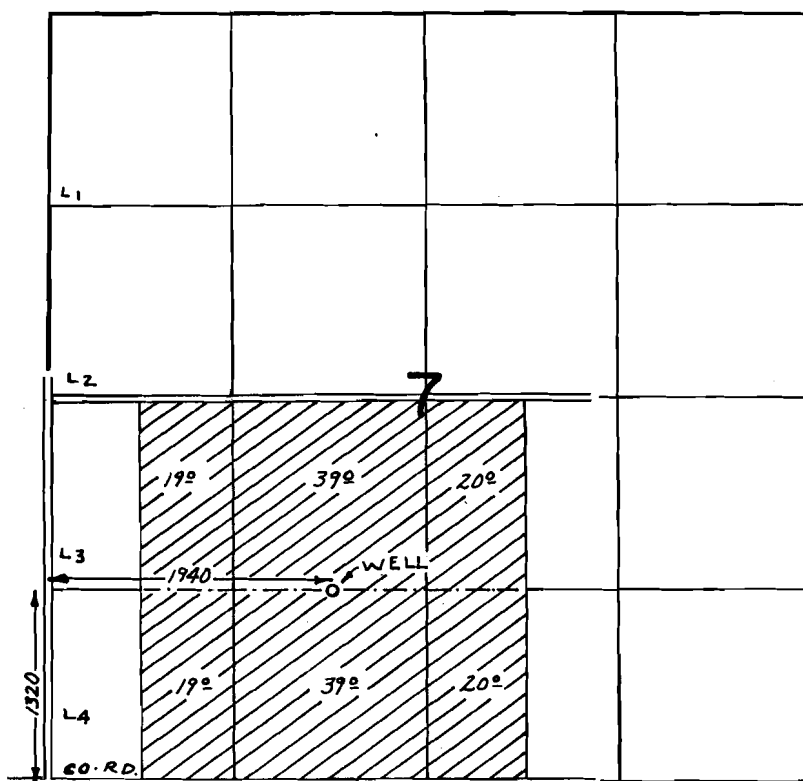


C7-6261
T8028
46679
75831
T8028

T.27S.R.18E.W.M.



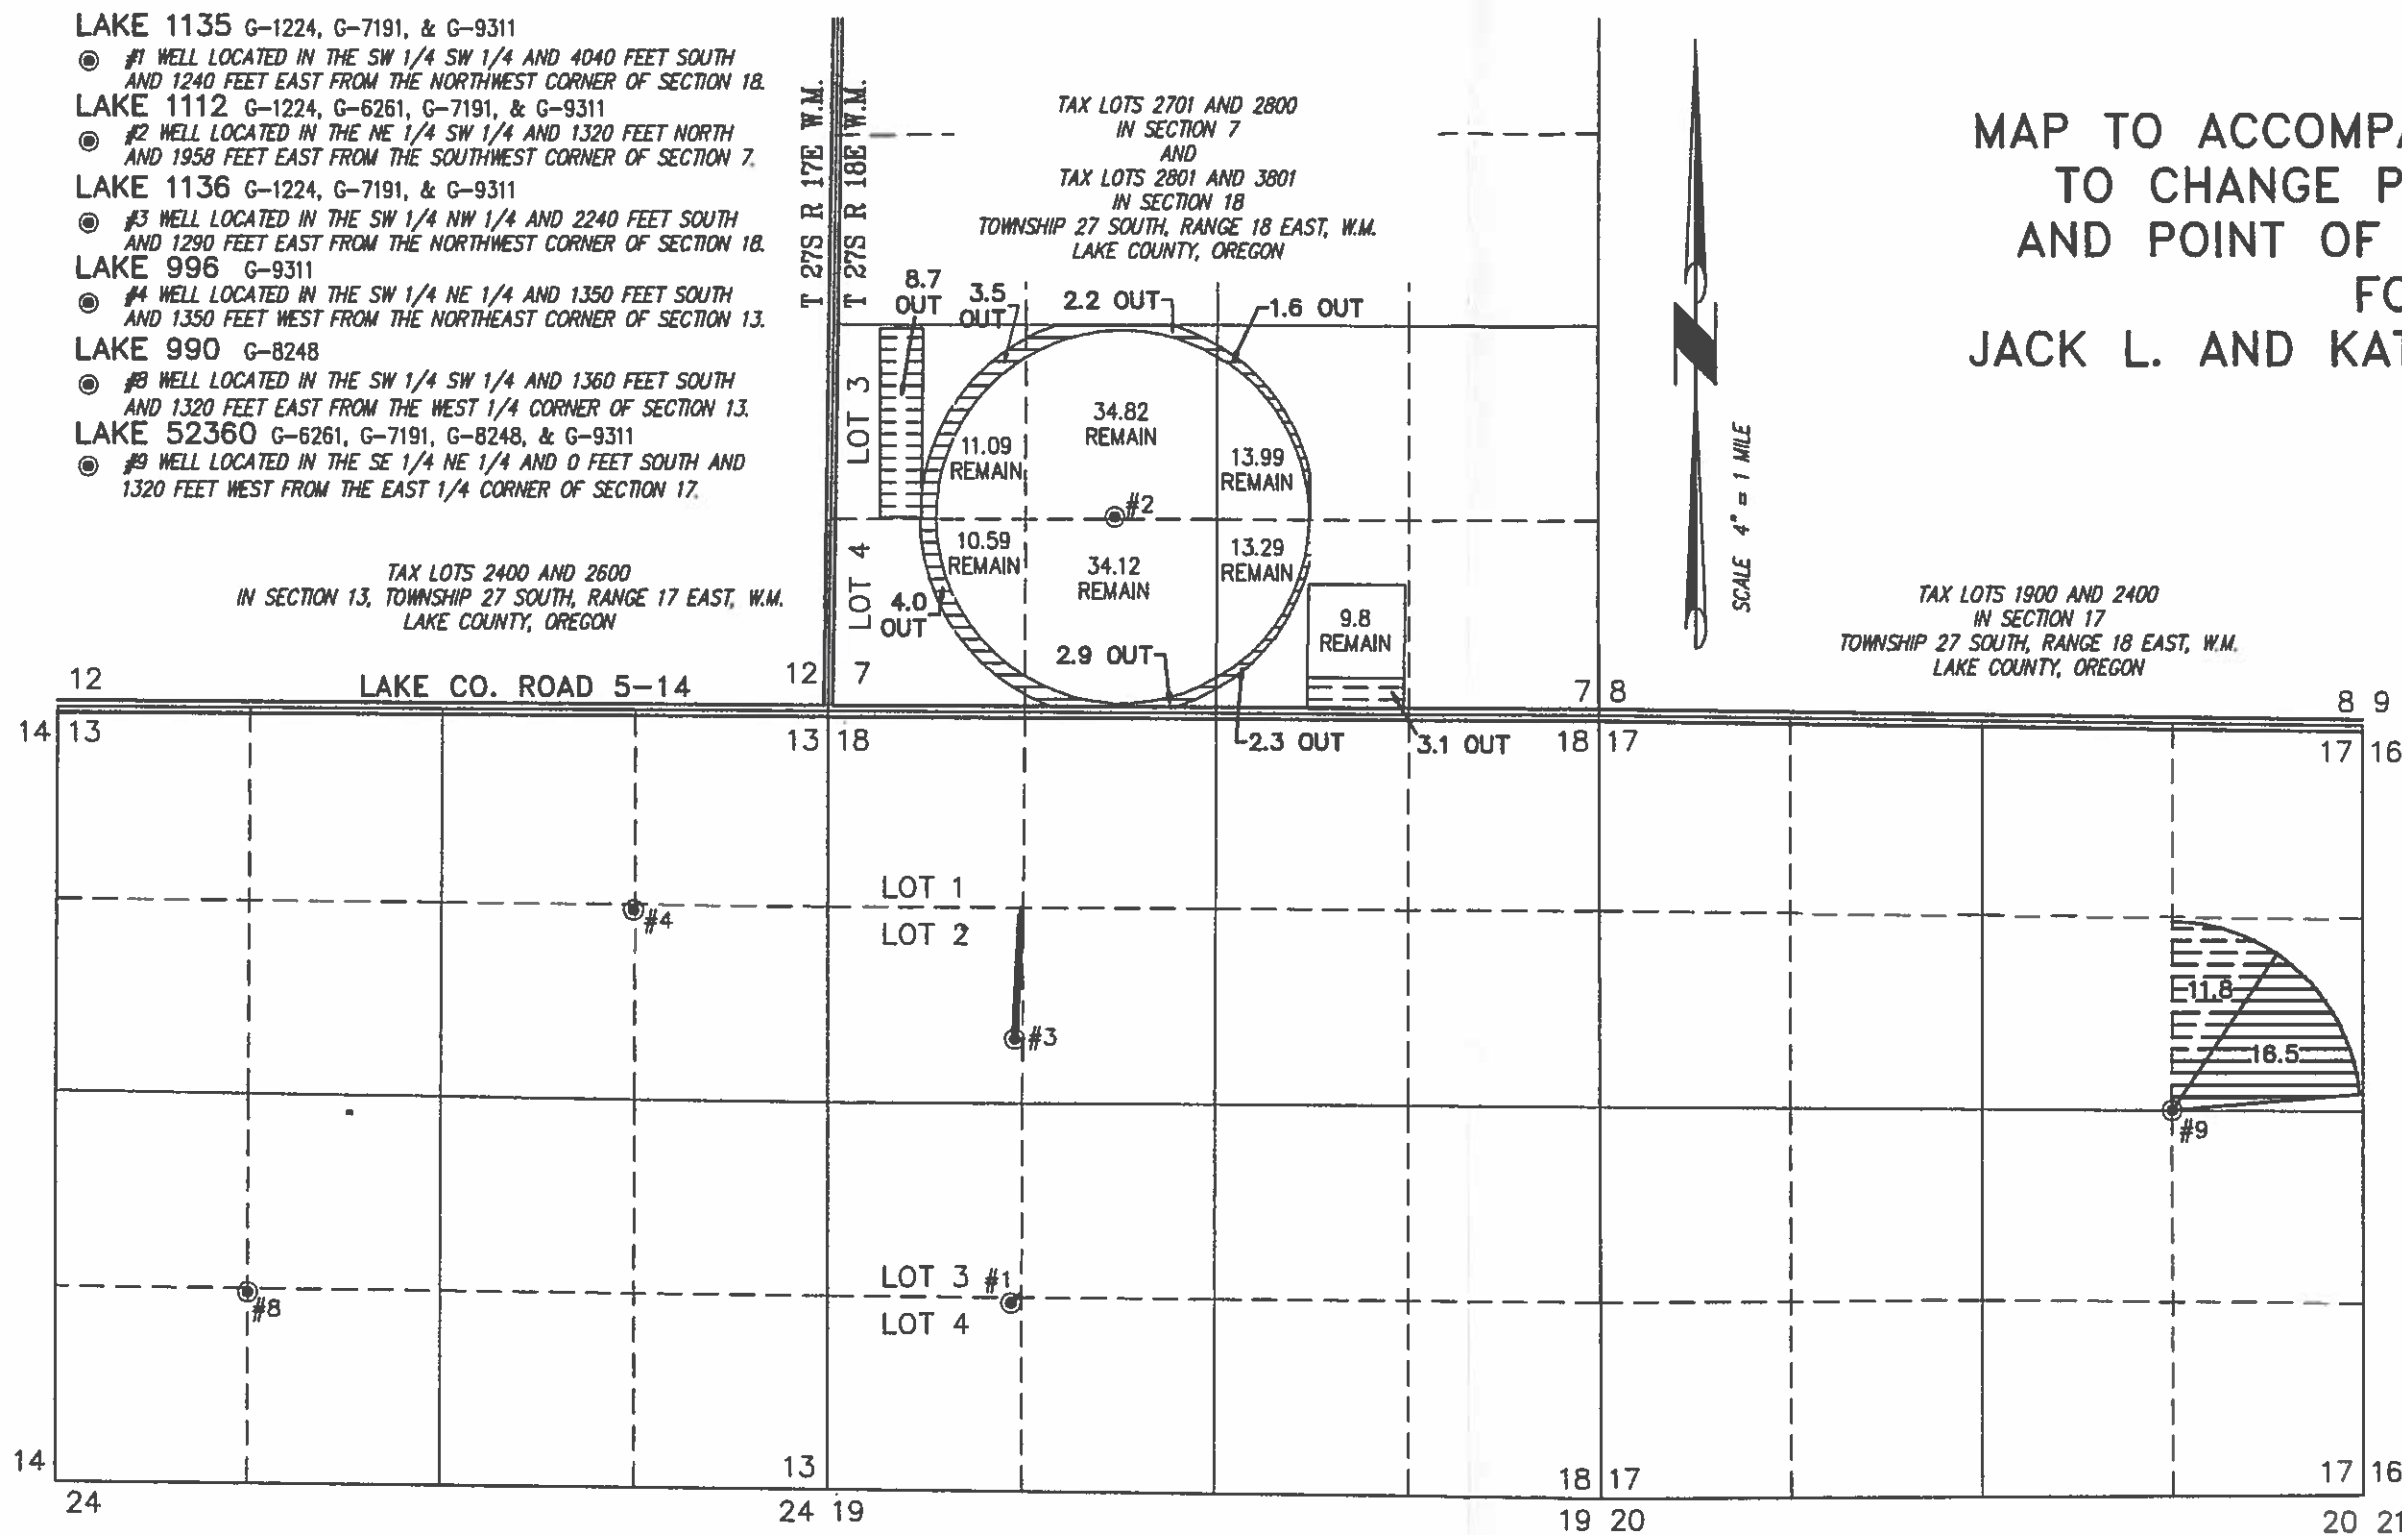
FINAL PROOF SURVEY
UNDER

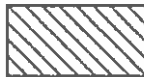
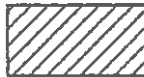
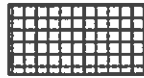
Application No. G-6731 Permit No. G-6261
IN NAME OF

JACK L. GILLETTE

Surveyed DEC. 26, 1976, by R. MUCKEN

MAP TO ACCOMPANY APPLICATION TO CHANGE PLACE OF USE AND POINT OF APPROPRIATION FOR JACK L. AND KATHERINE GILLETTE



-  27.7 ACRES WATER RIGHTS FROM C #54692 (G-8248) TRANSFERRED, AS SHOWN.
-  61.07 ACRES WATER RIGHTS FROM C #75829 (G-9311) TRANSFERRED, AS SHOWN.
-  15.27 ACRES WATER RIGHTS FROM C #85938 (G-1224) TRANSFERRED, AS SHOWN.
-  15.2 ACRES WATER RIGHTS FROM C #75830 (G-1224) TRANSFERRED, AS SHOWN.
-  11.8 ACRES WATER RIGHTS FROM C #85939 (G-6261) TRANSFERRED, AS SHOWN.
-  16.5 ACRES WATER RIGHTS FROM C #85931 (G-6261) TRANSFERRED, AS SHOWN.
-  4.58 ACRES WATER RIGHTS FROM C #85940 (G-7191) TRANSFERRED, AS SHOWN.
-  15.3 ACRES WATER RIGHTS FROM C #75828 (G-7191) TRANSFERRED, AS SHOWN.

RECEIVED BY OWRD

AUG 31 2013

SALEM, OR

THIS MAP IS FOR THE PURPOSE OF LOCATING A WATER RIGHT ONLY AND HAS NO INTENT TO PROVIDE LEGAL DIMENSIONS OR THE LOCATION OF PROPERTY LINES.

NOTE: REPLACED POU FROM G-9311
TO BE TRANSFERRED TO NEW PIVOT

PROJECT No. 12-002

PREPARED AT THE REQUEST OF:

GILLETTE RANCH
P.O. BOX 556
CHRISTMAS VALLEY, OR 97641

ALL POINTS ENGINEERING
& SURVEYING, INC.



P.O. BOX 767 (CRR)
TERREBONNE, OREGON 97760
(541) 548-5833 PH
(541) 585-4602 FX
www.APEandS.com



RENEWAL DATE: 12/31/2012

T 12468