


**Map of
Claim of Beneficial Use
Scott & Laura Lillie
Savannah Hills Reservoir
Application R-85986 & R-87436
Permit R-14027 & R-14990**

RECEIVED

NOV 26 2018

OWRD

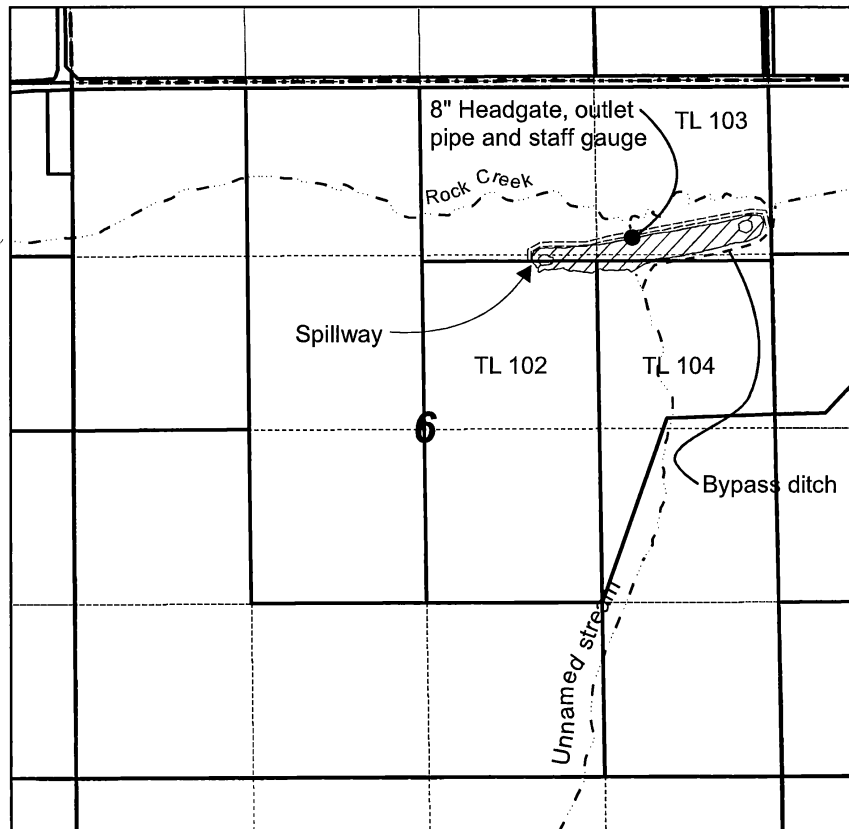

Point of Diversion is located
1102 ft south and 1078 ft West
From the NE Corner of Sec 6
T 36 S, R 2 W, WM



1 inch = 1,320 feet

Legend

- 8" Headgate and Staff Gauge
- Bypass ditch
-  Lillie Pond
- Outlet pipe
- ===== Dam

Note: This map is not intended to provide legal dimensions or locations of property ownership lines.

