



SCALE: 1"=1320'

# FINAL PROOF SURVEY

FOR APPLICATION G-12629


PERMIT NO. G-13118

PLACE OF USE OF WATER  
USED FOR IRRIGATION AND LOCATED







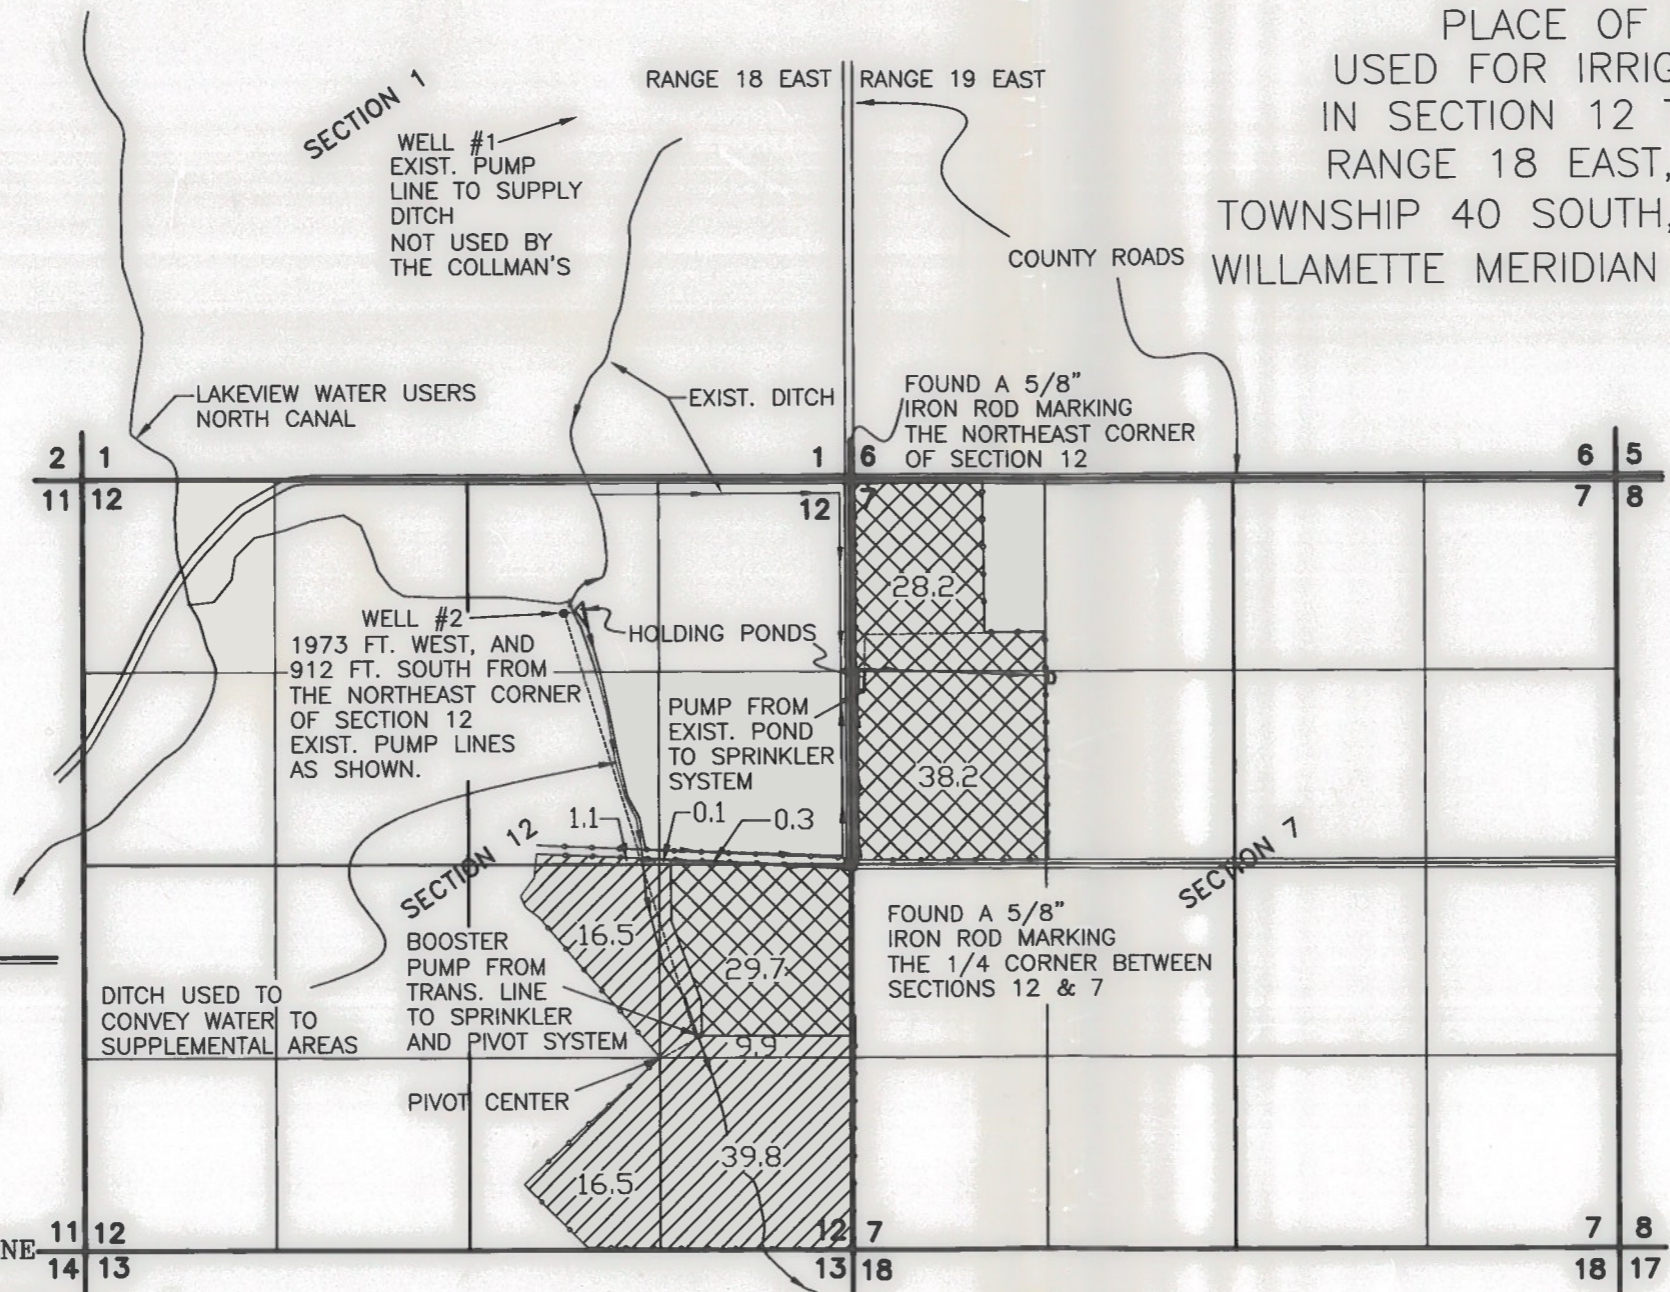




IN SECTION 12 TOWNSHIP 40 SOUTH,  
RANGE 18 EAST, AND IN SECTION 7,  
TOWNSHIP 40 SOUTH, RANGE 19 EAST, OF THE  
WILLAMETTE MERIDIAN IN LAKE COUNTY, OREGON

REVISION

ANDERSON ENGINEERING  
AND SURVEYING, INC.  
P.O. BOX 28  
LAKEVIEW, OREGON 97630  
(503) 647-1407  
P.O. BOX 419  
REDMOND, OREGON 97756  
(503) 753-4307

 

## LEGEND

-  PRIMARY WATER
-  SUPPLEMENTAL GROUND WATER WELL # 2
-  SECTION LINE
-  1/4 SECTION LINE
-  1/16 SECTION LINE
-  GOVERNMENT LOT LINES
-  EXISTING FENCE
-  WATER TRANSMISSION LINE
-  EXISTING DITCH
-  EXISTING WELL
-  FOUND LAND SURVEY MONUMENT AS NOTED.

SEE ACCOMPANYING  
SITE REPORT

NOTE: PREPARATION OF THIS MAP IS FOR IDENTIFYING PROPOSED WATER RIGHTS ONLY. IT HAS NO INTENT TO PROVIDE LOCATIONS OR DIMENSIONS OF PROPERTY BOUNDARIES.

**RECEIVED**

APR 20 2000



RENEWAL 12/31/2000

WATER RESOURCES DEPT.  
SALEM, OREGON

PREPARED FOR:  
RICHARD & LUCY COLLMAN  
HC 60 BOX 2900

DATE: 3/28/2000
SCALE: 1"=1320'
JOB: 2021
DWG. BY: M.J.B.
FILE: 2021FP
SHEET 1 OF 1