
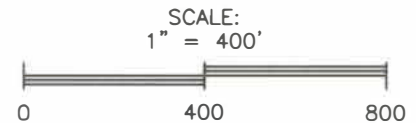


NE1/4NE1/4 of Section 30, T.35S., R.5W., W.M.

RECEIVED BY OWRD

AUG 31 2015

SALEM, OR

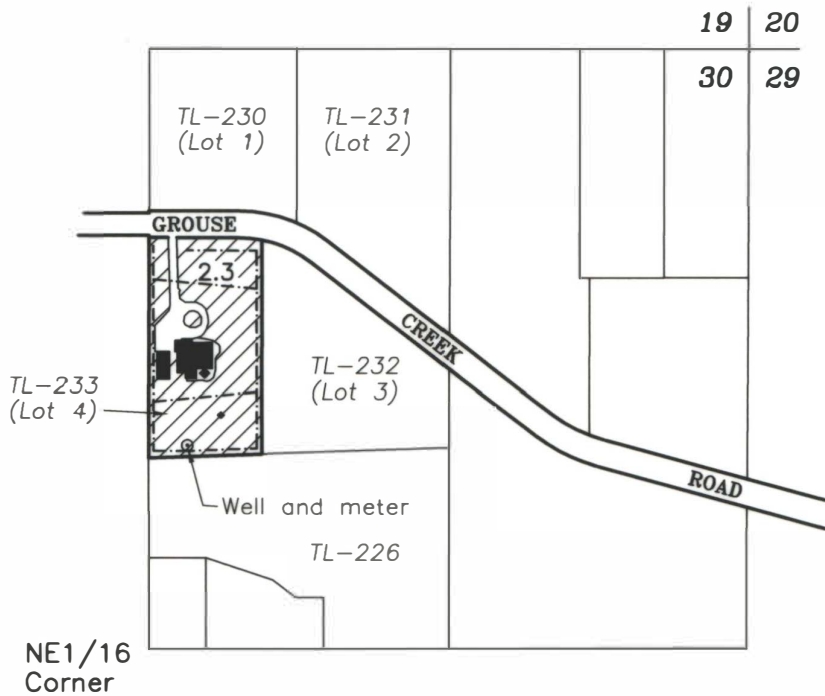

LEGEND:



Place of Use: 2.30 acres
Irrigation



Point of Appropriation: OWRD Well No. L-55028
875 feet South and 1240 feet West of the
NE Corner of Section 30



Building



Underground pipe line (approximate location)

Supporting Documents:

Application No. G-15709
Permit No. G-15346

Priority Date: February 19, 2002
Usage: Irrigation

Base Map - Britton Estates Subdivision
overlay with Oregon Map
aerial photo for assumed best fit

This map is not intended to provide
legal dimensions or locations of
property ownership lines

A nine page site report accompanies this plat.

OWRD\lottscoibu.dwg

SUBJECT PROPERTY: Tax Lot 233, Map No. 35-5-30
311 Grouse Creek Road, Grants Pass, OR 97526


PROJECT NO.
1224-15-484

DRAWING NO.
199-8.5.11

DATE:
July 30, 2015
n.e.d.

SCALE:
1" = 400'

SHEET NO.
1 of 1

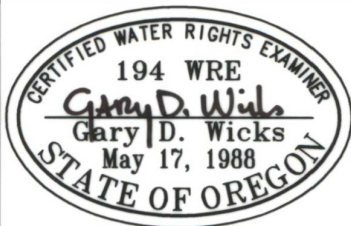

RENEWAL DATE: 6-30-16

PLAT FOR CLAIM OF BENEFICIAL USE

LOCATED IN:

NE1/4NE1/4 of Section 30
Township 35 South, Range 5 West, W.M.
Josephine County, Oregon

PREPARED FOR:

H. Willis and Janice L. Lotts
560-A NE "F" Street #415
Grants Pass, OR 97526

Tel: 541-226-9380

PREPARED BY:

WICKS ENGINEERING & SURVEYING
311 N.E. "D" Street
Grants Pass, OR 97526

Tel: 541-479-3436
Fax: 541-479-1014