


IN SECTIONS 16 AND 17, TWP.4 S. RANGE 12 E. W.M.
WASCO COUNTY, OREGON

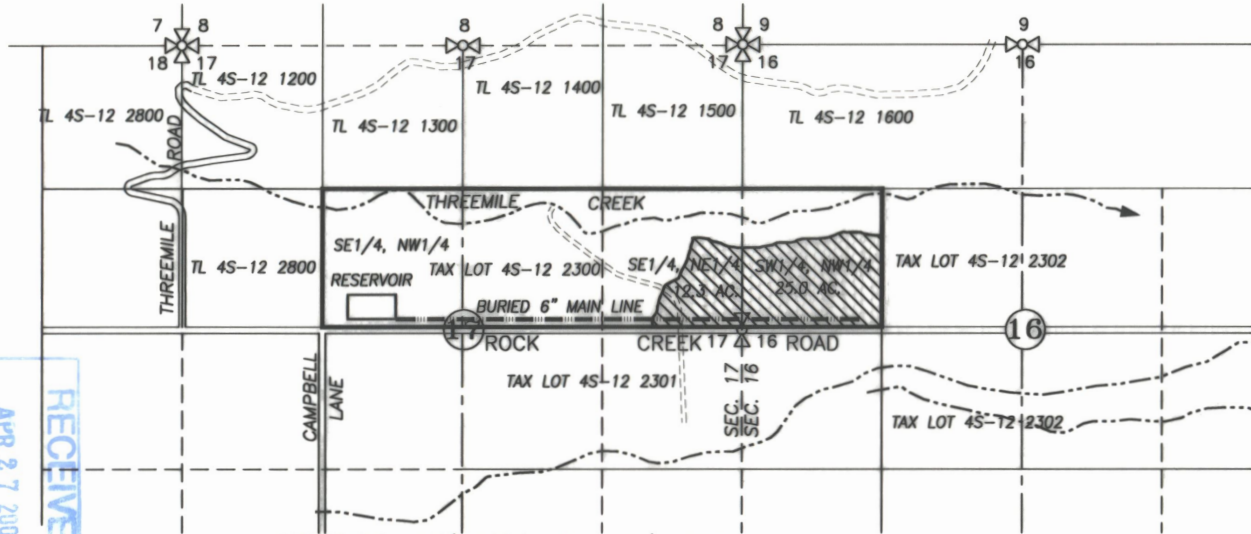

RECEIVED
 APR 27 2006
 WATER RESOURCES DEPT.
 SALES SECTION

RESERVOIR: 102' NORTH AND 629' WEST
OF THE C.1/4, SECTION 17

CLAIM OF BENEFICIAL USE MAP

SCALE: 1" = 1320'

NOTE:

"THIS MAP IS NOT INTENDED TO PROVIDE DIMENSIONS OR LOCATIONS OF PROPERTY OWNERSHIP LINES."

APPLICATION No. 80698, R-80699

PERMIT No. 52463, R-80699 ^{11877 pts/wr.d} ₅₅₋₁₅

IN THE NAME OF:

JACK STEVENS

DATE: MARCH 2, 2006



TOTAL APPLICATION
AREA = 37.3 ACRES



EXISTING 6" IRRIGATION MAIN


TENNESON ENGINEERING CORP.

CONSULTING ENGINEERS

409 LINCOLN STREET

THE DALLES, OREGON 97058

541-296-9177 FAX 541-296-6657

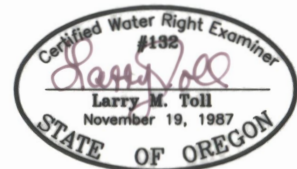

EXPIRES: 06/30/06

W.O. #12009wr