


Township 5 South, Range 2 West, W.M.

Portions of Sections 13, 14, 23 & 24


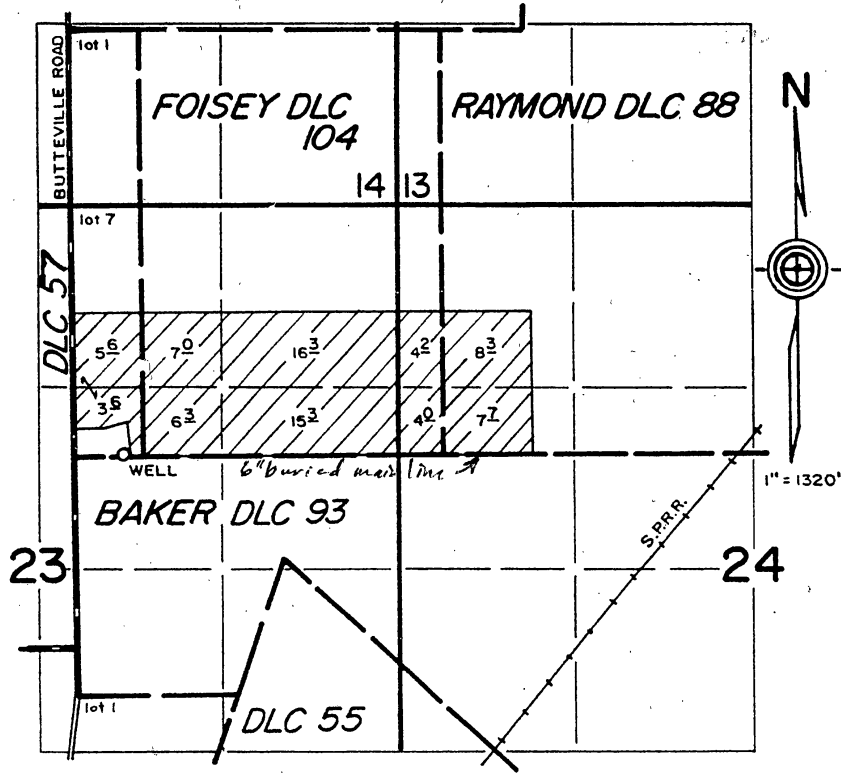


WELL LOCATED 10' N. & 360' E. FROM NW COR. DLC 93.

Surveyed Aug 26, 2000

Appl. No. G-13389
Per. No. G-12949

Claim of Beneficial Use Map
for
BLUE SKY FARMS

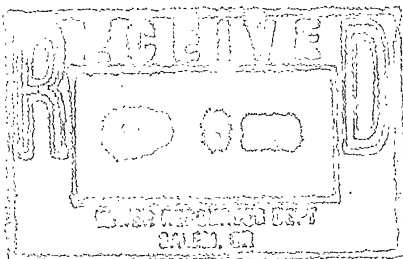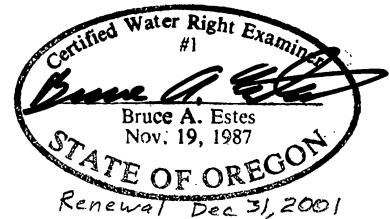

This map is for the purpose of locating a water right only and has no intent to provide legal dimensions or the location of property lines.

ESTES SURVEYS

PO Box 17519 60382 Arnold Rd
Salem, OR 97305-7519 Bend, OR 97702
(503) 585-7593 (541) 382-7391