



Township 5 South, Range 2 West, W. M.

Portions of Sections 15, 16, 21, & 22

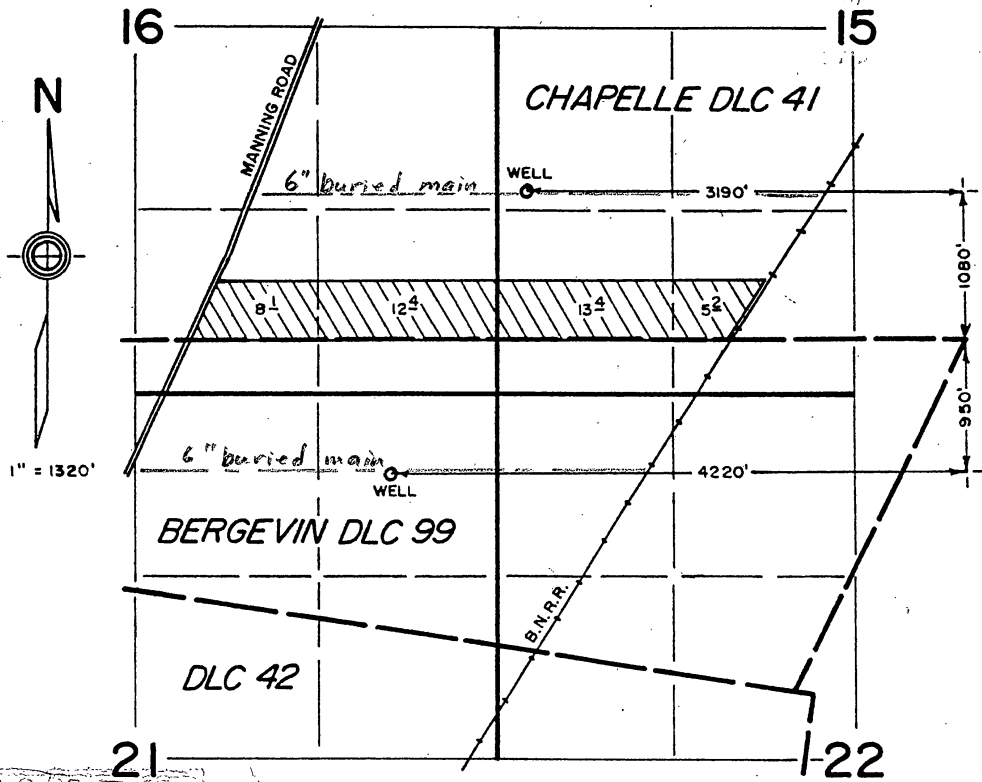


Surveyed Aug 26, 2000

Appl. No. G-13391
Per. No. G-12948

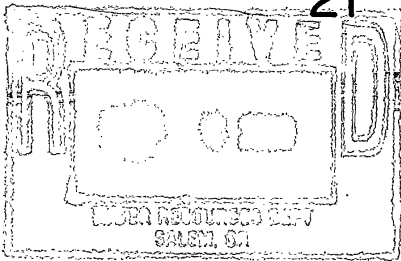

Claim of Beneficial Use Map
for
BLUE SKY FARMS

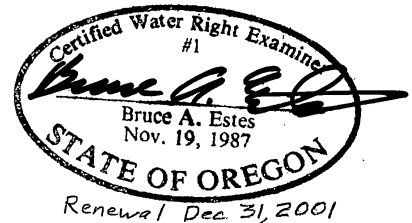

This map is for the purpose of locating a water right only and has no intent to provide legal dimensions or the location of property lines.

ESTES SURVEYS

PO Box 17519 60382 Arnold Rd
Salem, OR 97305-7519 Bend, OR 97702
(503) 585-7593 (541) 382-7391