


# CLAIM OF BENEFICIAL USE KAY TOOLSSEN RESIDENCE

SE 1/4, SE 1/4, T18S, R4W, SEC 6

TL 1800 & 1900

JUNE 24, 2016

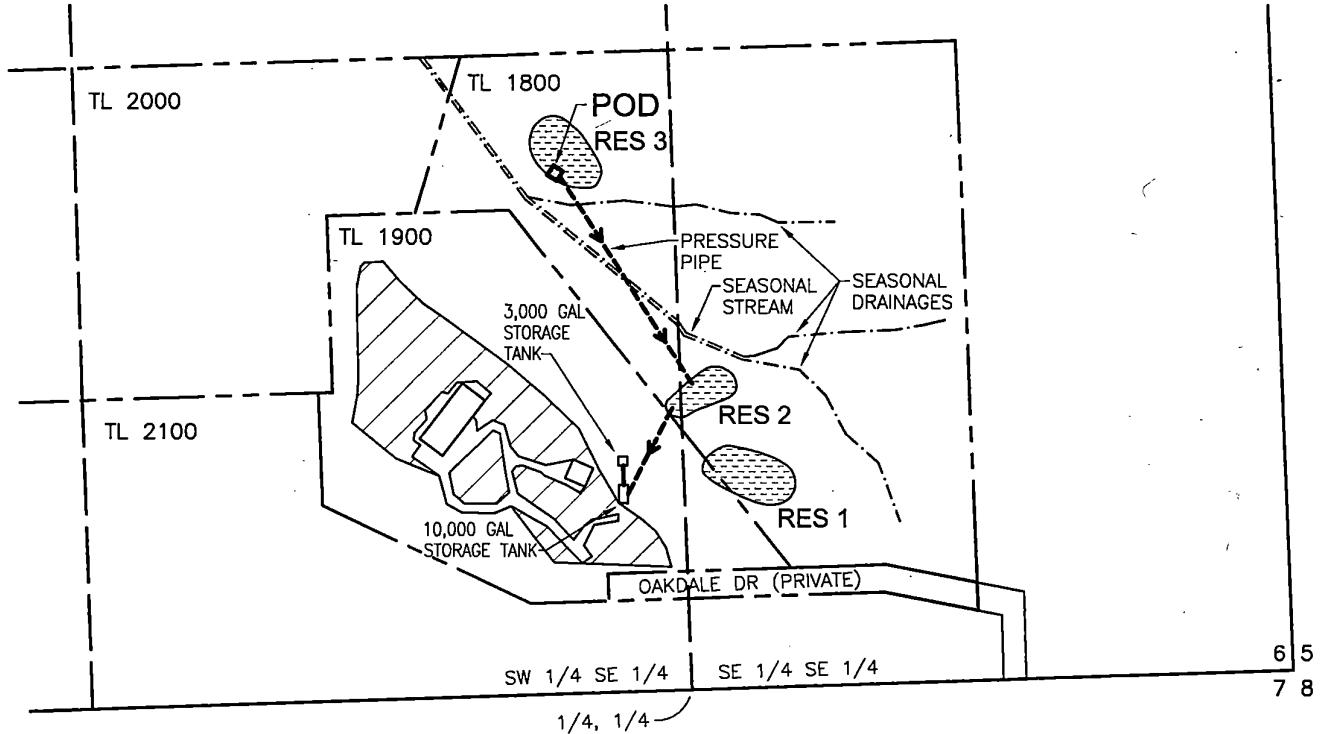


## LEGEND

- SECTION LINE
- - - - - 1/4 SECTION LINE
- - - - - TAX LOT LINE
- - - - -> 1-1/2" PVC PRESSURE PIPE
- ◆ POINT OF DIVERSION (POD)
- STRUCTURE
- ▨ IRRIGATED AREA ~ 3.72 AC

## POD

1,151' NORTH OF AND  
1,577' WEST OF SE SECTION CORNER 6.

PERMIT # S-53931  
APPLICATION # S-85345

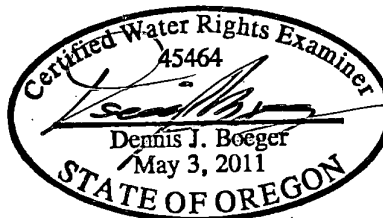

EXPIRES: 12/31/2017



SCALE: 1" = 400'

## DISCLAIMER

THIS MAP IS NOT INTENDED TO PROVIDE  
LEGAL DIMENSIONS OR LOCATIONS OF  
PROPERTY OWNERSHIP LINES.

**Boeger & Associates, LLC**  
1158 High Street, Suite #102  
Eugene, OR 97401  
Ph: 541.302.4996  
Fax: 541.302.4968  
dboeger@boegerassociates.com