



T. 19 & 20 S., R. 44 E., W. M.

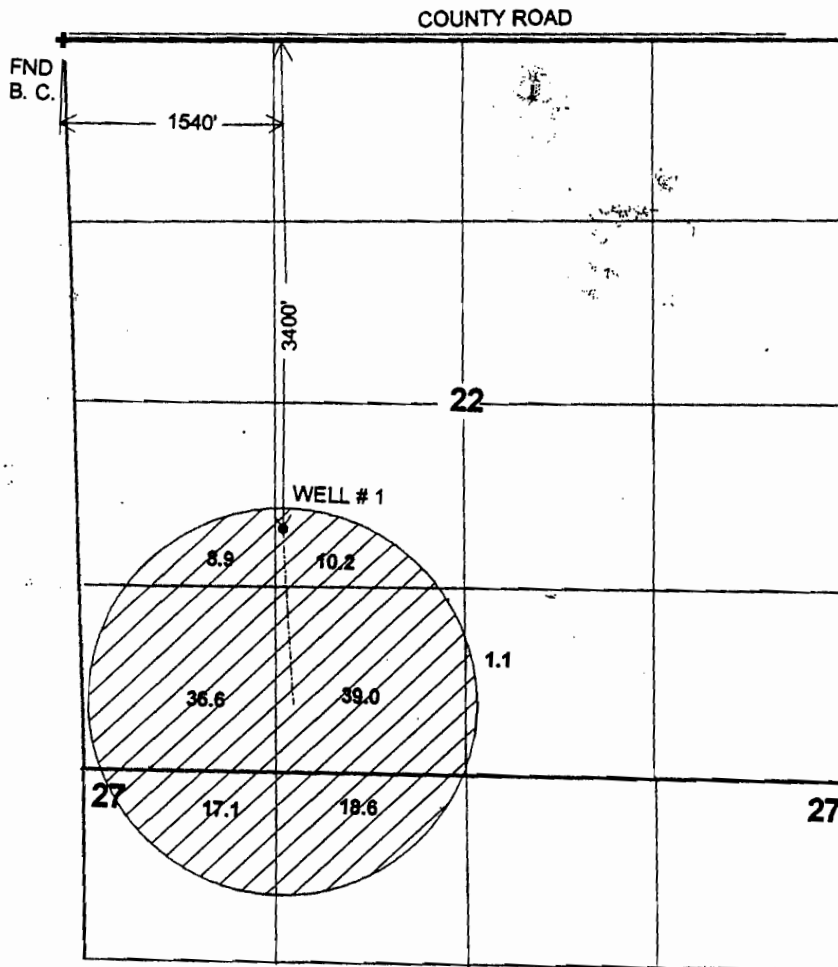

1" = 1320'

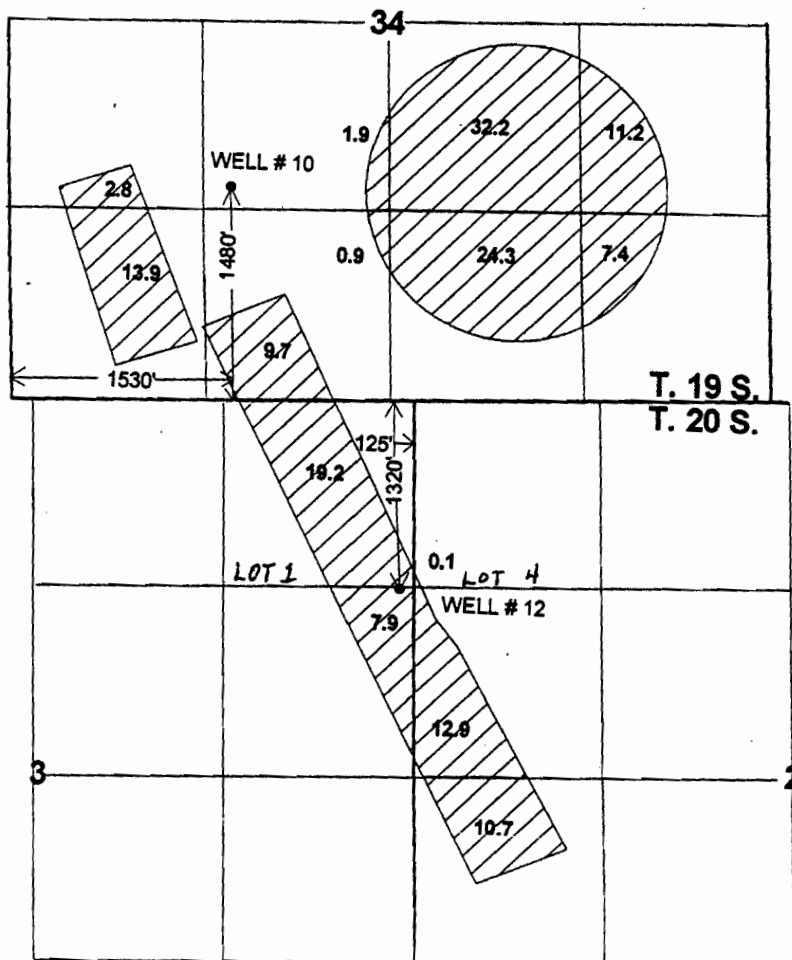

FINAL PROOF SURVEY UNDER

Application No. G-7664 Permit No. G-7152

IN THE NAME OF
CONNECTICUT GENERAL LIFE INSURANCE
AND
PROBERT FAMILY TRUST

Surveyed: April 9, 2003 by: J. Miller

RECEIVED

MAY 02 2003

WATER RESOURCES DEPT.
SALEM, OREGON

6/5/06 JWG


GPS & SID FILE 43117-G3 & H3 J M 4-23-2003

T19S, R44E, Sections 22 and 27, Willamette Meridian

RECEIVED

OCT 01 2018


OWRD

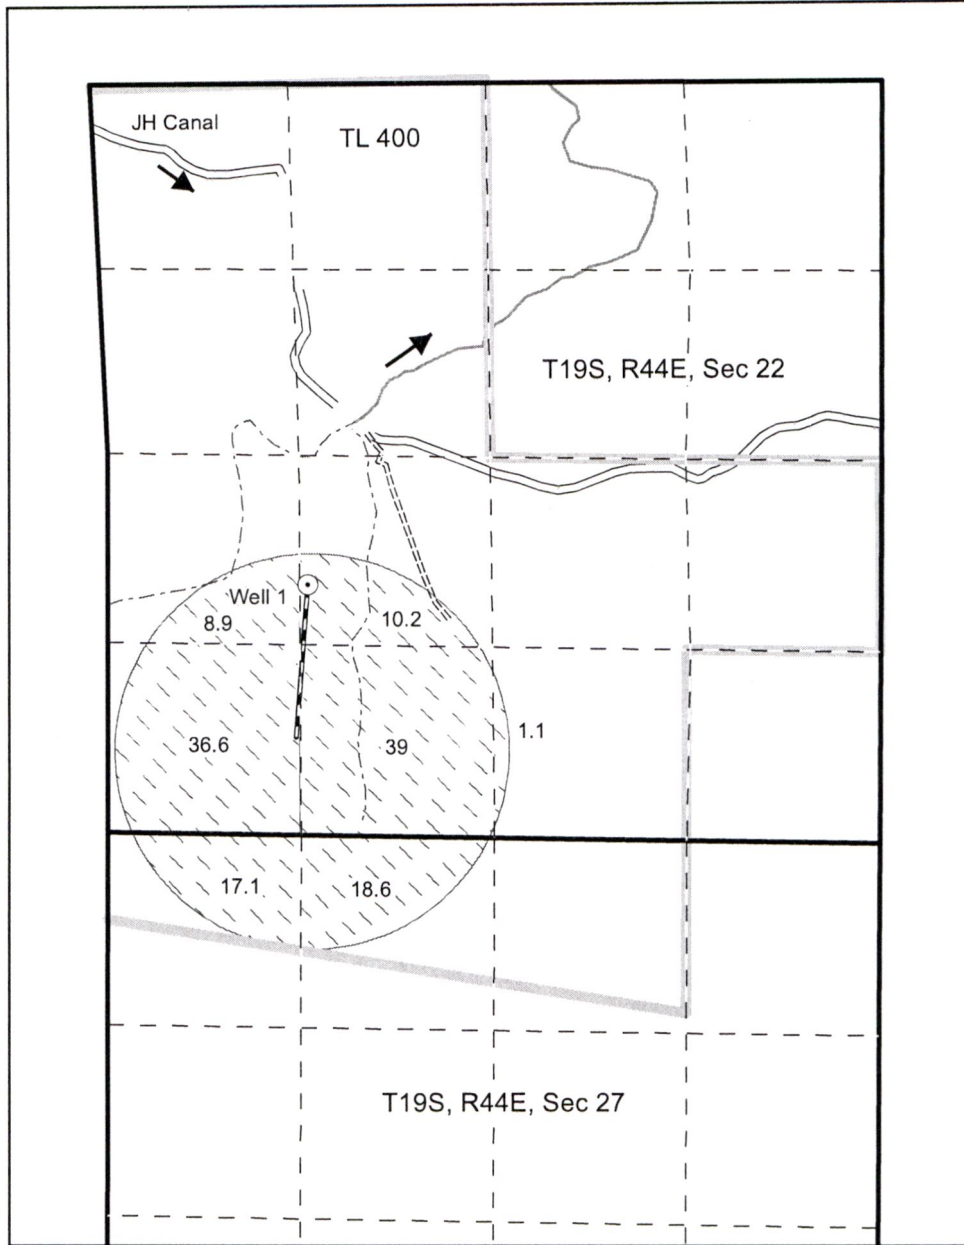

- Well
- - - Quarter quarter line
- Section line
- ==== Canal
- ===== Dirt road
- Pipeline
- - - Seasonal stream
- Stream
- Tax lot line
- Transfer from Certificate 82594
- ➔ Flow Direction



Well 1 (MALH 1844) is in T19S, R35E, Section 22, NE SW; 3400 feet south and 1540 feet east from the NW corner of Section 22.

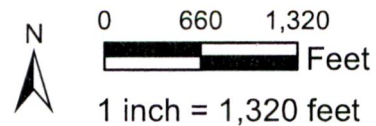

Transfer from Map
Application to Transfer Certificate 82594 (priority 1/26/1977)
prepared for Jonathon M. and Lacy A. Blake
Tax Lot 400


map prepared by Nancy Rorick Consulting

T19S, R44E, Sections 22 and 27, Willamette Meridian


RECEIVED

OCT 01 2018


OWRD

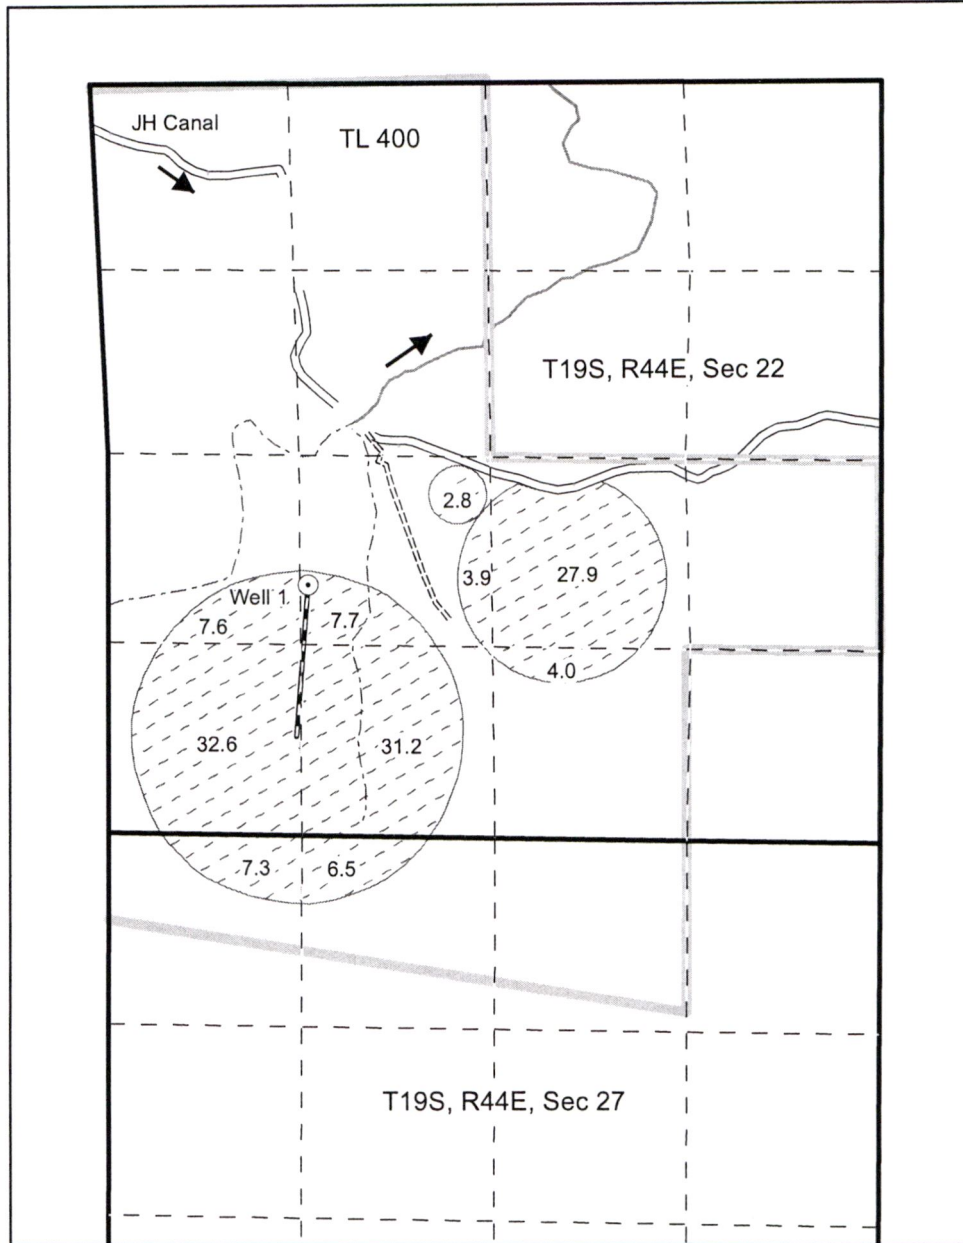

- Well
- - - Quarter quarter line
- Section line
- Canal
- ===== Dirt road
- Pipeline
- - - Seasonal stream
- Stream
- Tax lot line
- Transfer to Certificate 82594
- ➔ Flow Direction

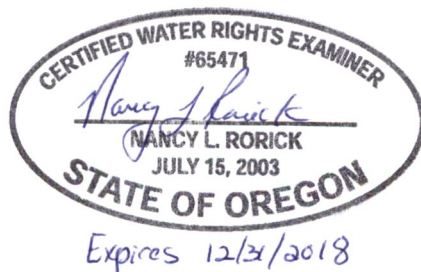

Well 1 (MALH 1844) is in T19S, R35E, Section 22, NE SW; 3400 feet south and 1540 feet east from the NW corner of Section 22.

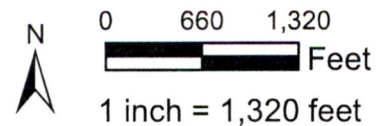

Transfer to Map
Application to Transfer Certificate 82594 (priority 1/26/1977)
prepared for Jonathon M. and Lacy A. Blake
Tax Lot 400

map prepared by Nancy Rorick Consulting