


Sec. _____
 Tp. 6S
 R. 20E

Per 8007
 9486

11561
 8607

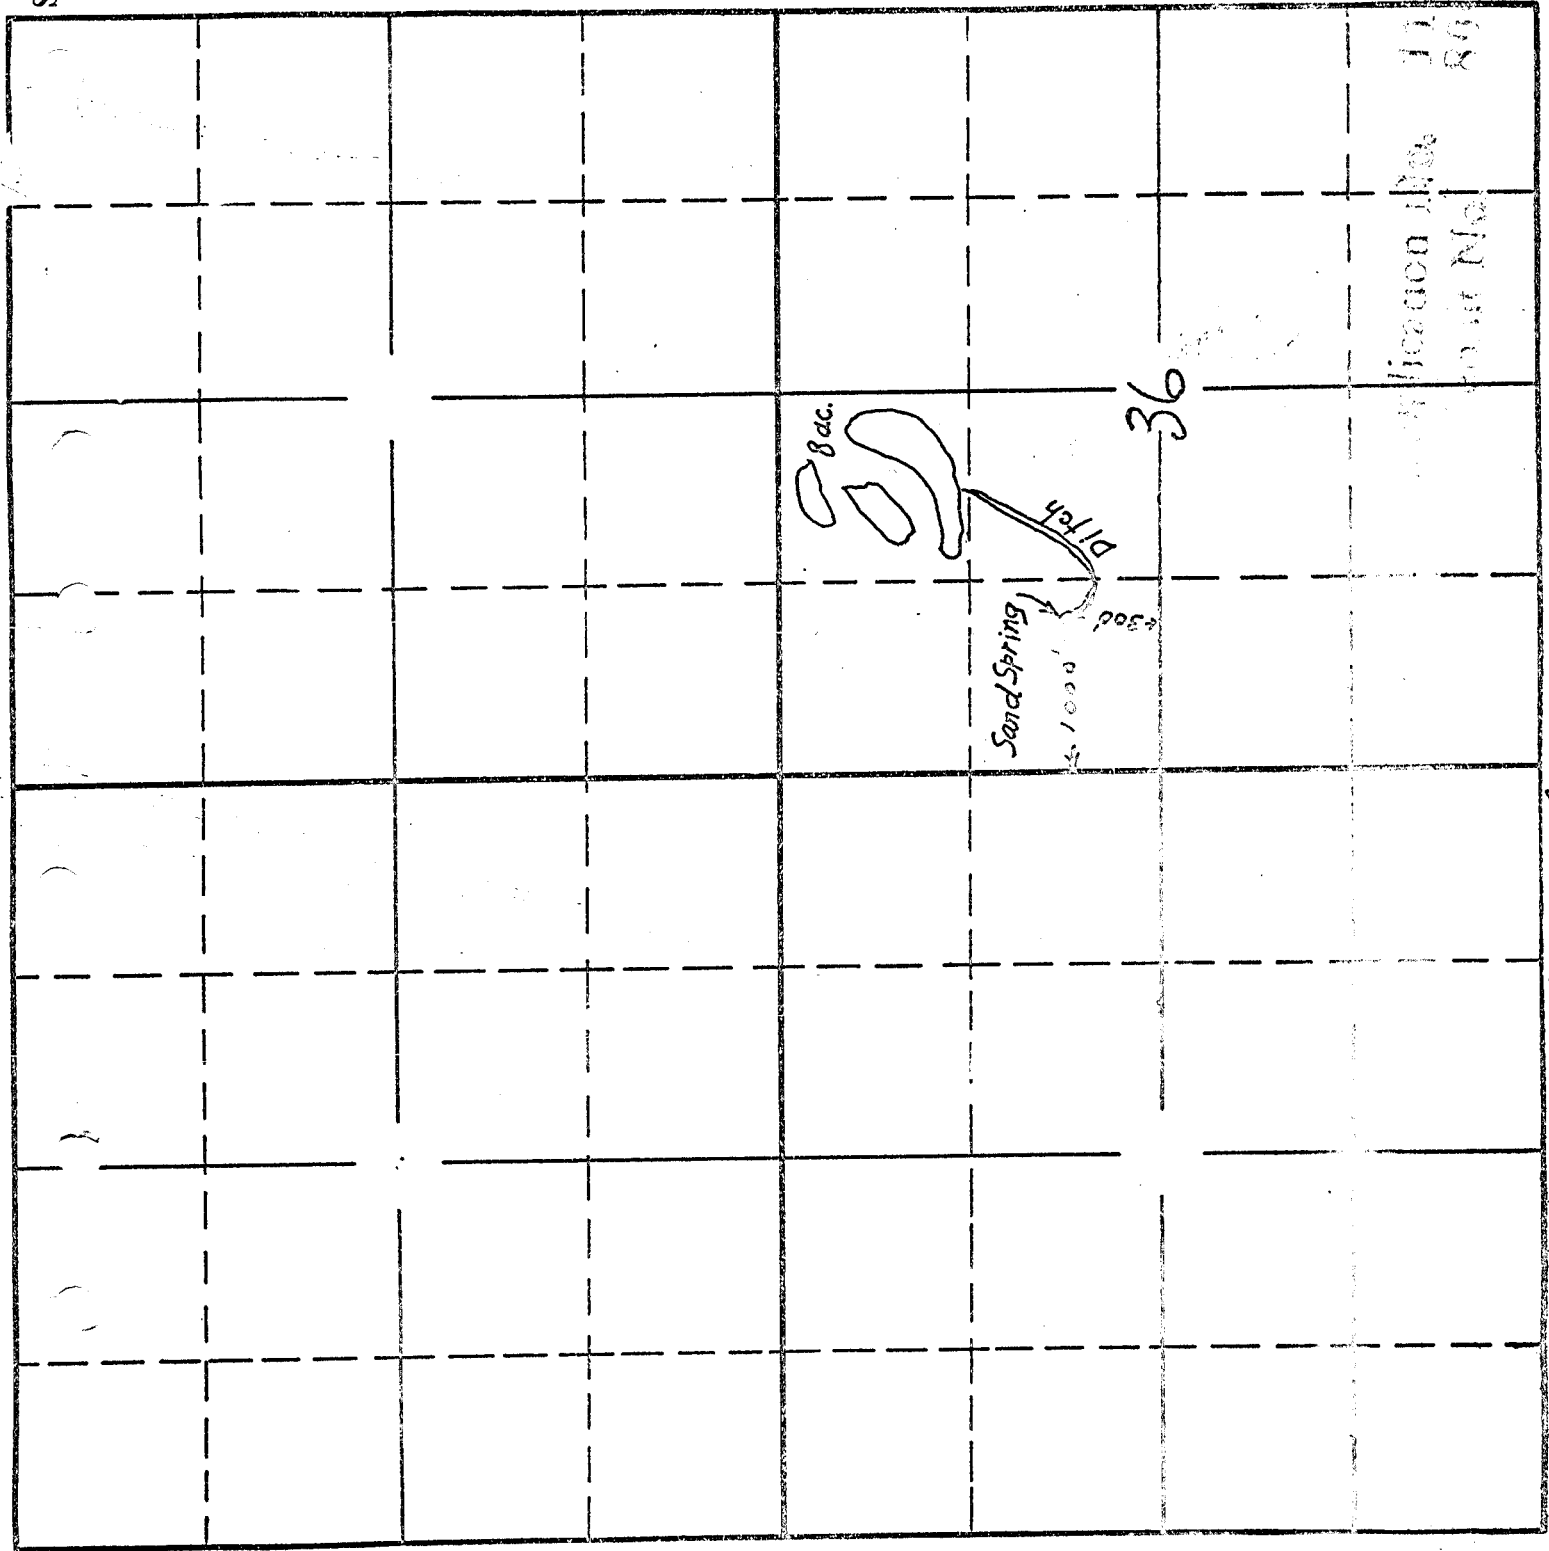

Application No. 11561
 Serial No. 8607

Sketched from Mr. King's description

11561
 8007