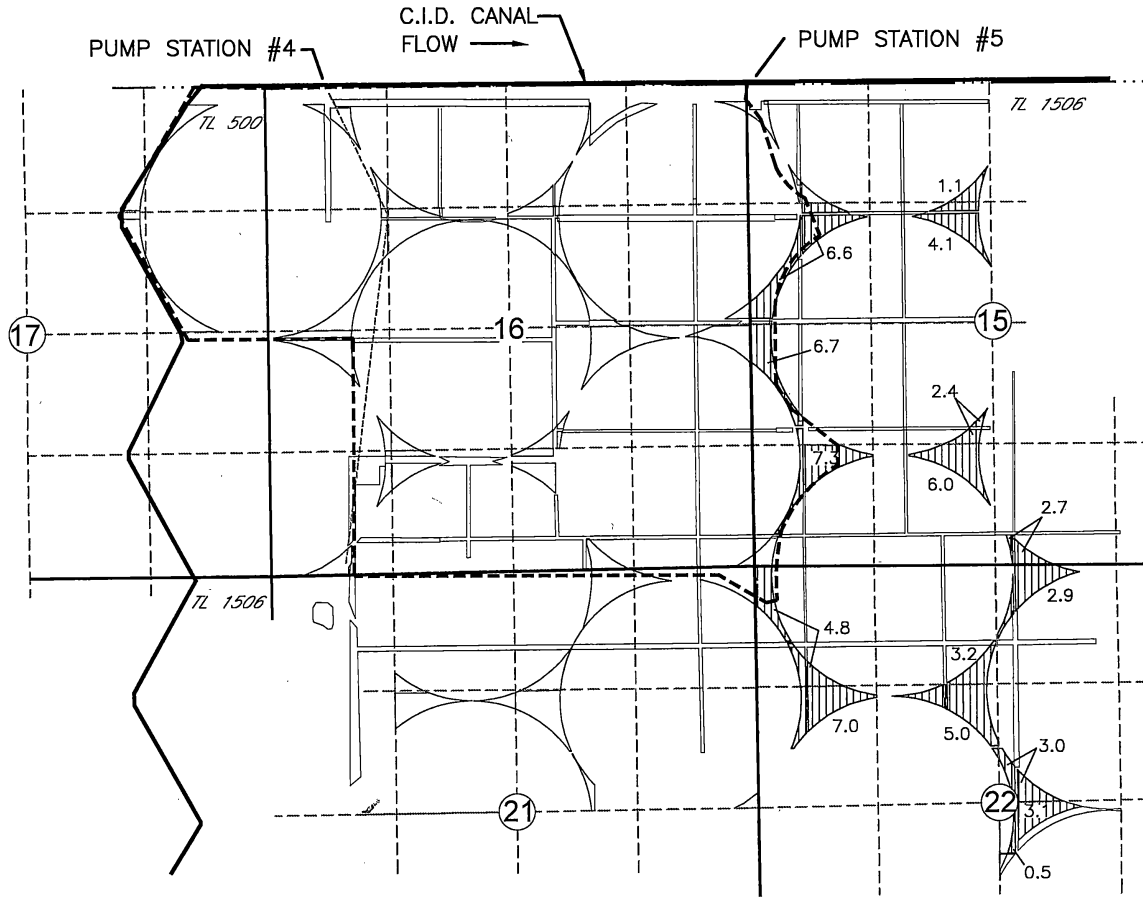

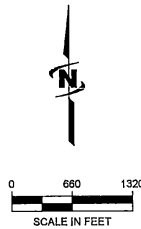


**TRANSFER APPLICATION MAP
CANYON FARM II, LLC TO CANYON FARM II, LLC
REMAINING RIGHTS FOR CERTIFICATE 86993
T3N, R26E, W.M., MORROW COUNTY**



LEGEND

 66.4 AC OF CERT 86993



Received by OWRD

JAN 14 2020

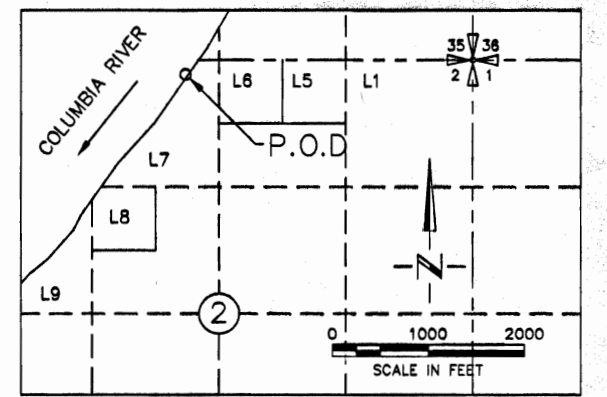
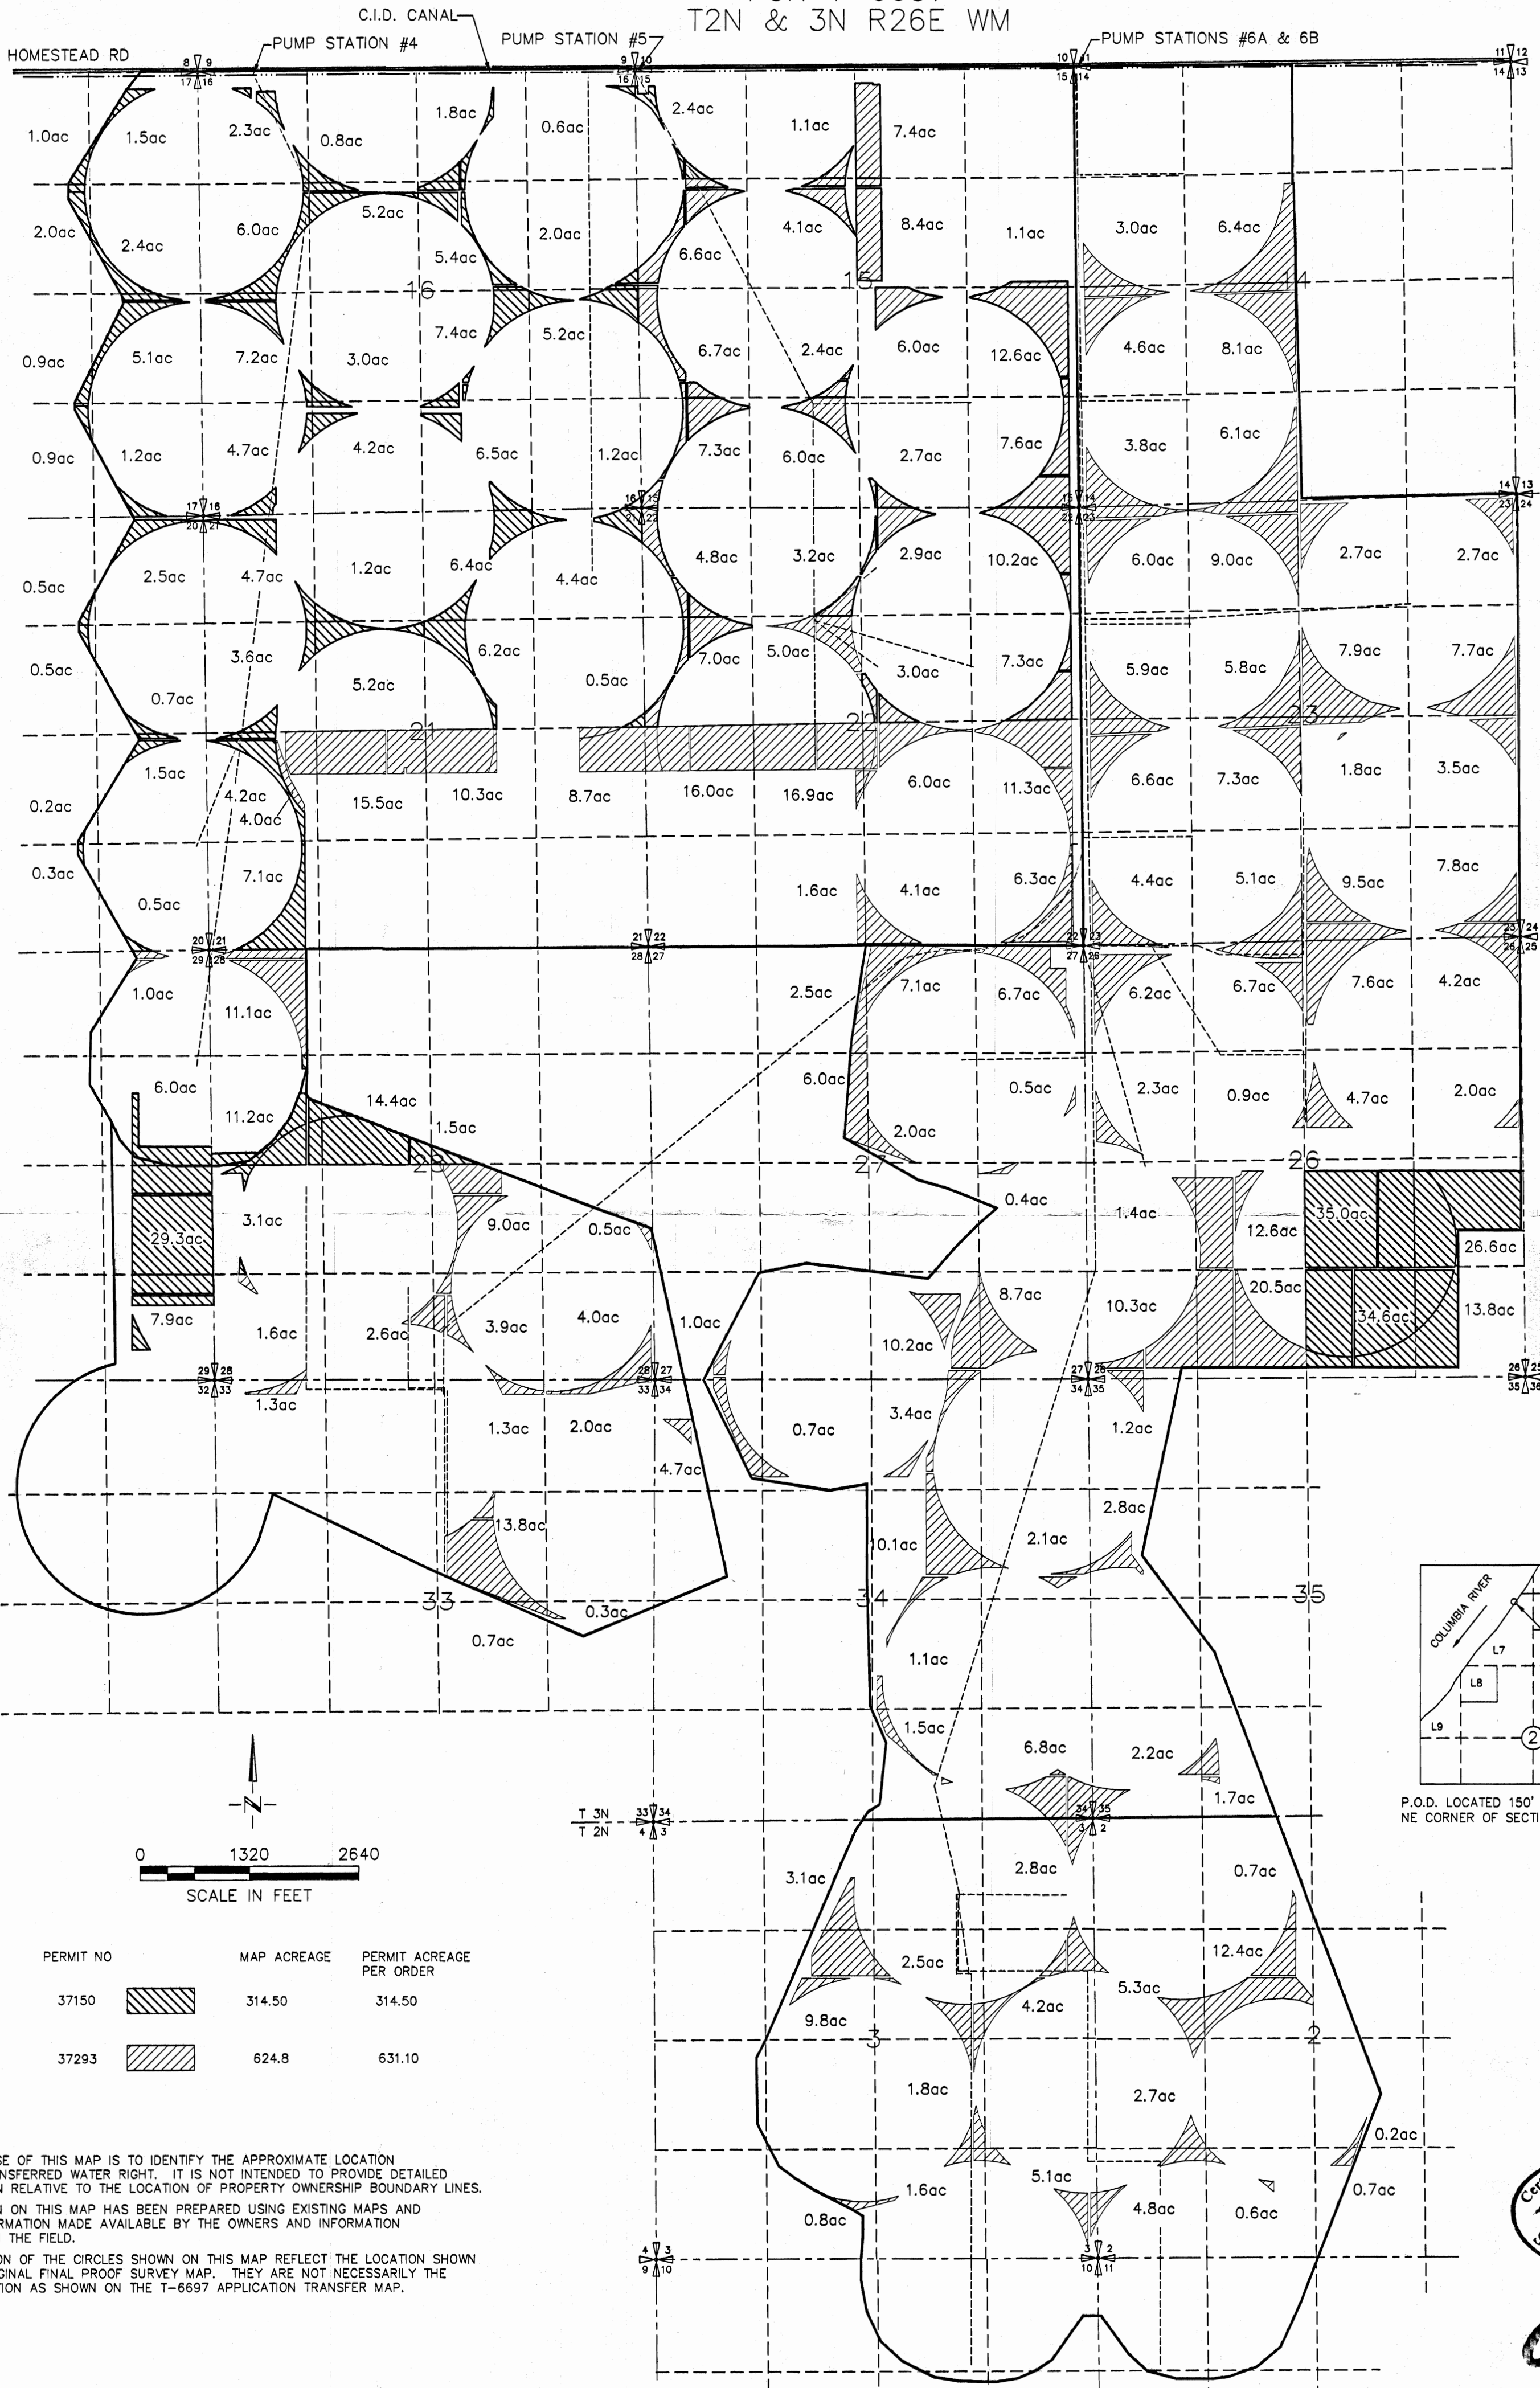
Salem, OR

NOTE:
THE PURPOSE OF THIS MAP IS TO IDENTIFY THE APPROXIMATE LOCATION OF THE WATER RIGHT. IT IS NOT INTENDED TO PROVIDE INFORMATION RELATIVE TO THE LOCATION OF PROPERTY OWNERSHIP BOUNDARY LINES. PIPE LOCATIONS AND SIZES WHERE SHOWN WERE PROVIDED BY FARM OPERATIONAL PERSONNEL AND ARE APPROXIMATE LOCATIONS AND SIZES.
DRAWN BY: \\SVP\IT\Projects\86993-18-075 - Fall Line East Valley Farm\CAD\DWG\86993-18-075 Remains w/0 0803.dwg
PRINTED BY: relland on 01/14/20 09:04 AM

FINAL PROOF SURVEY
FOR T-6697
T2N & 3N R26E WM

RECEIVED

MAR 9 1 2011
WATER RESOURCES DEPT
SALEM, OREGON



P.O.D. LOCATED 150' SOUTH AND 2990' WEST FROM THE NE CORNER OF SECTION 2, T4N, R25E WM

PERMIT NO	MAP ACREAGE	PERMIT ACREAGE PER ORDER
37150	314.50	314.50
37293	624.8	631.10

NOTE:
THE PURPOSE OF THIS MAP IS TO IDENTIFY THE APPROXIMATE LOCATION OF THE TRANSFERRED WATER RIGHT. IT IS NOT INTENDED TO PROVIDE DETAILED INFORMATION RELATIVE TO THE LOCATION OF PROPERTY OWNERSHIP BOUNDARY LINES. INFORMATION ON THIS MAP HAS BEEN PREPARED USING EXISTING MAPS AND OTHER INFORMATION MADE AVAILABLE BY THE OWNERS AND INFORMATION OBTAINED IN THE FIELD.
THE LOCATION OF THE CIRCLES SHOWN ON THIS MAP REFLECT THE LOCATION SHOWN ON THE ORIGINAL FINAL PROOF SURVEY MAP. THEY ARE NOT NECESSARILY THE SAME LOCATION AS SHOWN ON THE T-6697 APPLICATION TRANSFER MAP.

Certified Water Right Examiner
#333 WRE
Dale G. VanSchoeck
Dale G. VanSchoeck
May 19, 1992
3/26/11
STATE OF OREGON
Renewal 6/30/12

0003