

**T23S R32 1/2E, WM
HARNEY COUNTY, OR**



0 1,320 Feet

1" = 1,320'

● Well


----- Pipeline

POU IR

Section

----- Quarter Quarter

Taxlot

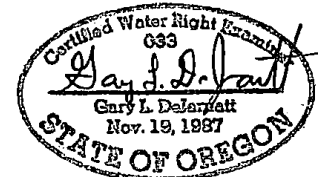

RECEIVED RENEWAL DATE 12/31/2019

JUL 08 2019

OWRD



**CLAIM OF BENEFICIAL USE MAP
Nicholas and Ladell Schott**

This map is not intended to provide legal dimensions or locations of property ownership lines.

WATER RIGHT SERVICES, LLC
PO BOX 1830, BEND, OR 97709
WWW.OREGONWATER.US CCB # 197121
johnshort@usa.com 541-389-2837

Date: 6/4/2019

Ap G-17704/T-12867

Permit G-18170

Project #19014

