


T. 5 S. R. 1 E. W. M.

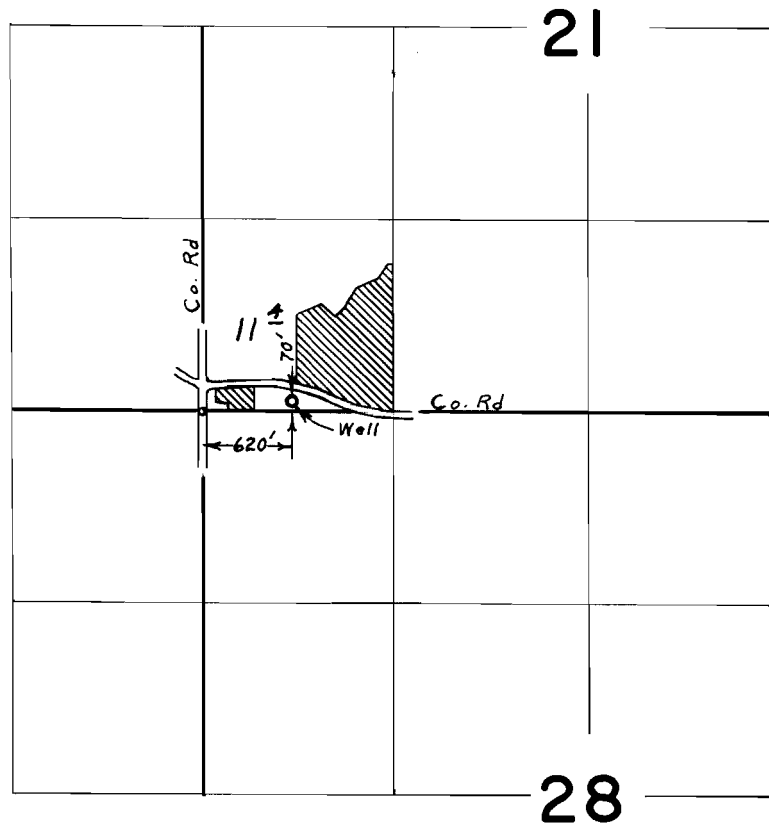


FINAL PROOF SURVEY
UNDER


Application No. G-3646 Permit No. G-3425
IN NAME OF
ERNEST KIMLINGER

Surveyed Oct. 17, 1967, by L. E. Gould

T.5S. R.1E. Section 21, W.M.

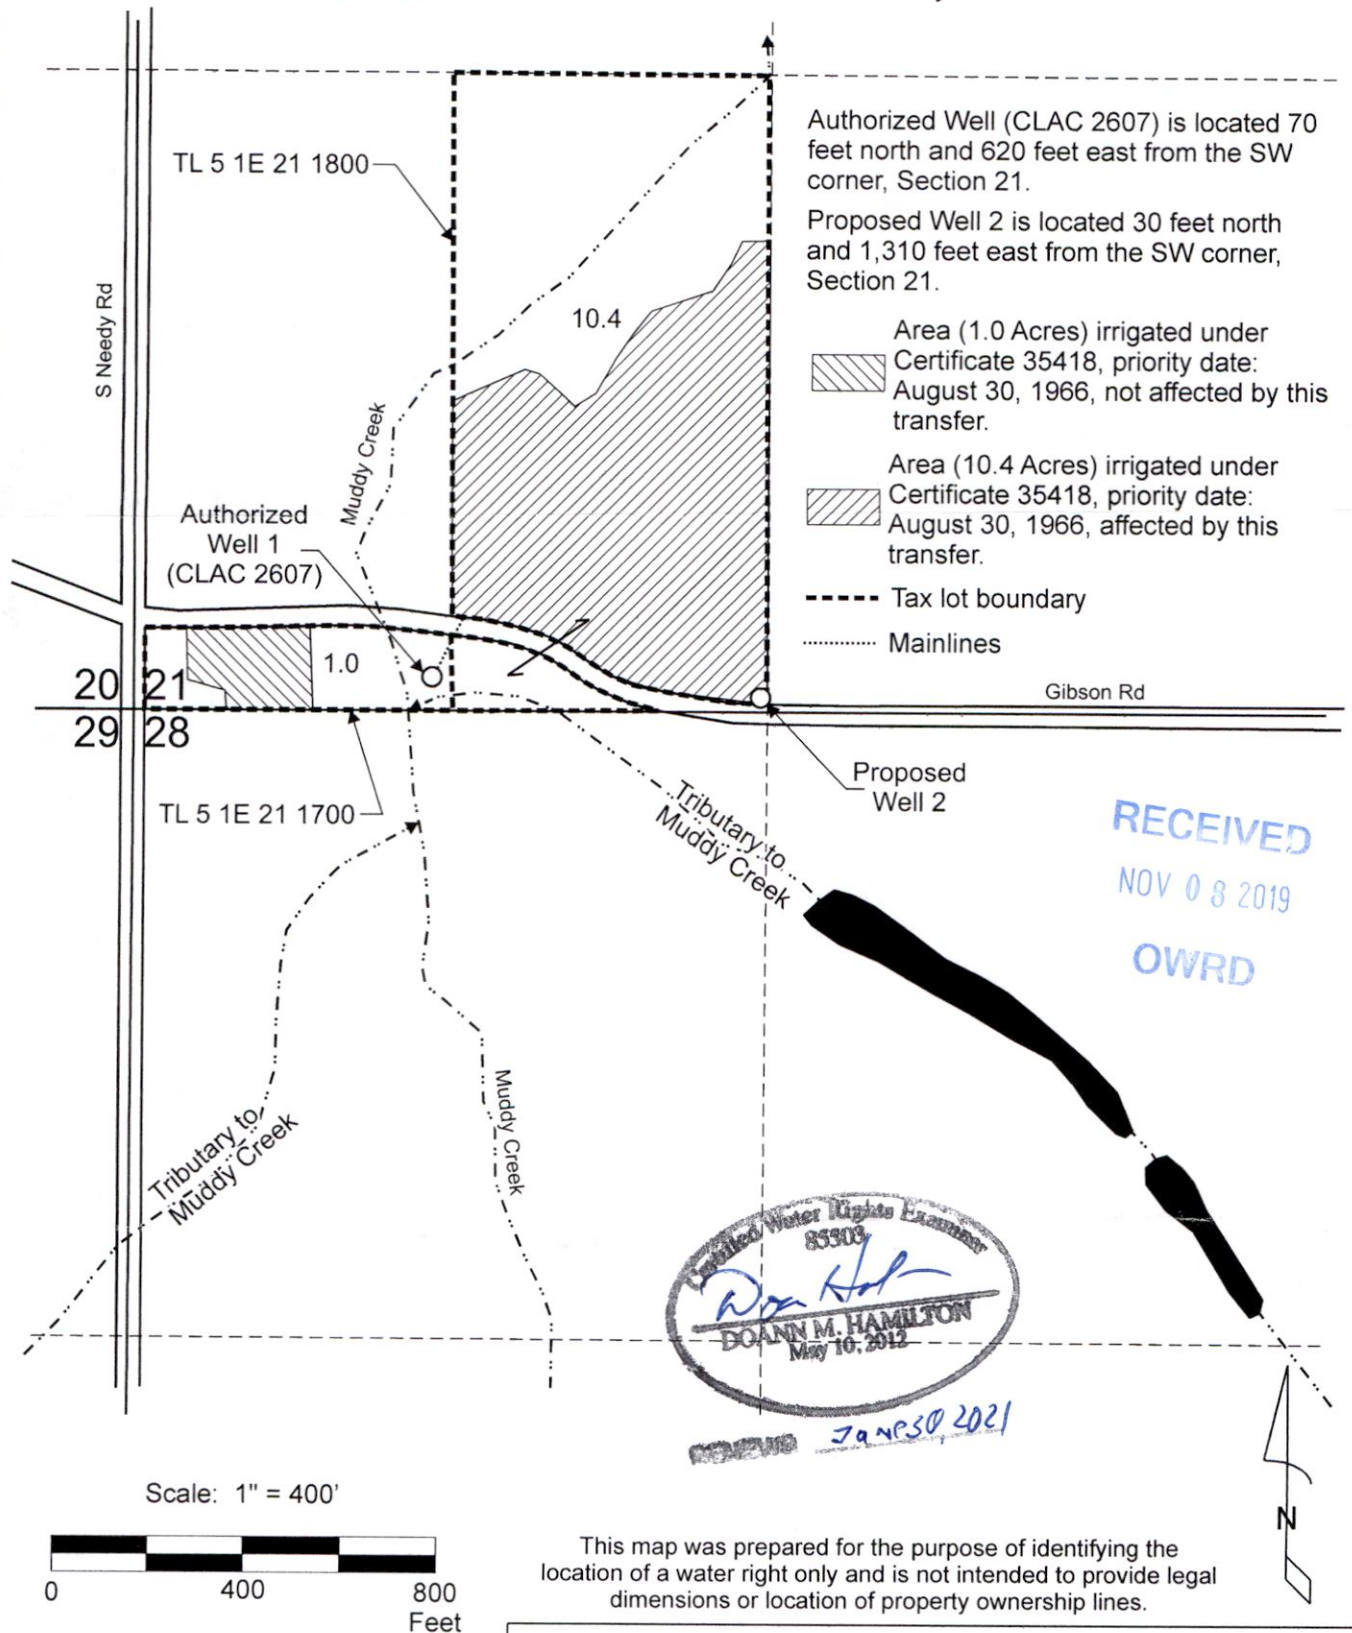

RECEIVED
NOV 08 2019
OWRD

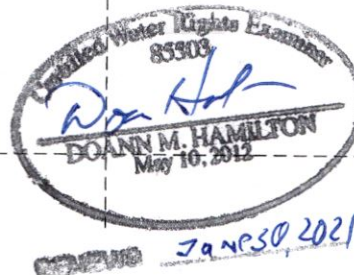

Transfer Application Map
Certificate 35418

Ivan Snegirev
T.5S. R.1E. Section 21, W.M.

Pacific Hydro-Geology Inc.

10/2019