
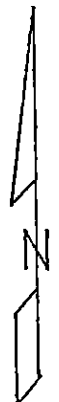


TOWNSHIP 2 SOUTH, RANGE 3 EAST, W.M.

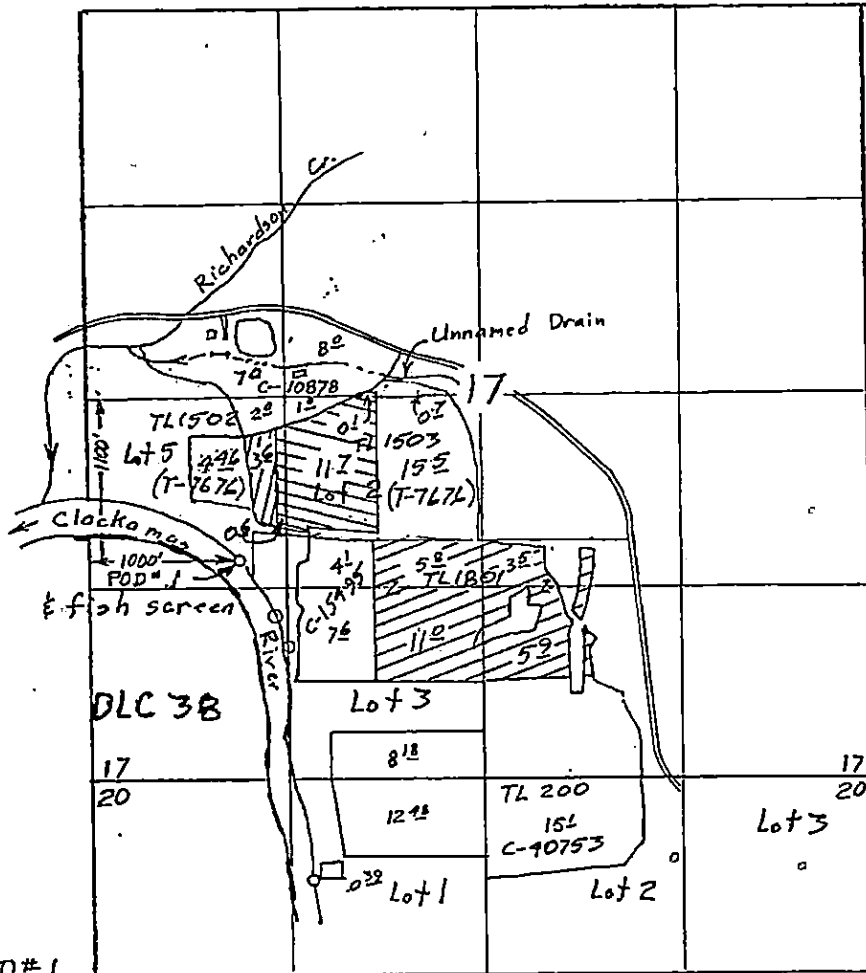

Scale 1" = 1320'
(4" = 1 mile)

TO: POD#1

Surveyed Sep 18, 2000

- ⊖ C-40753 12⁴ acres (POU & POD)
- ⊖ C-67377 3⁴ acres (POU & POD)
- ⊖ C-67377 26³ acres (POD)


T-8053

RECEIVED

JAN 18 2023

OWRD

Claim of Beneficial Use Map
for
JIM CALCAGNO

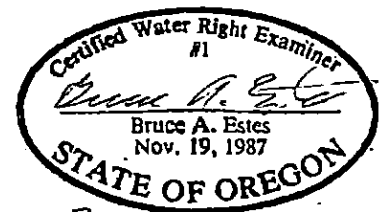

Renewed Dec 31, 2013

This map is for the purpose of locating a water right only and has no intent to provide legal dimensions or the location of property lines.

ESTES SURVEYS, LLC

6293 Sunnyview Rd. NE 60382 Arnold Rd.
Salem, OR 97305 Bend, OR 97702
(503) 585-7593 (503) 382-7391