
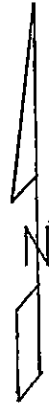


TOWNSHIP 2 SOUTH, RANGE 3 EAST, W.M.

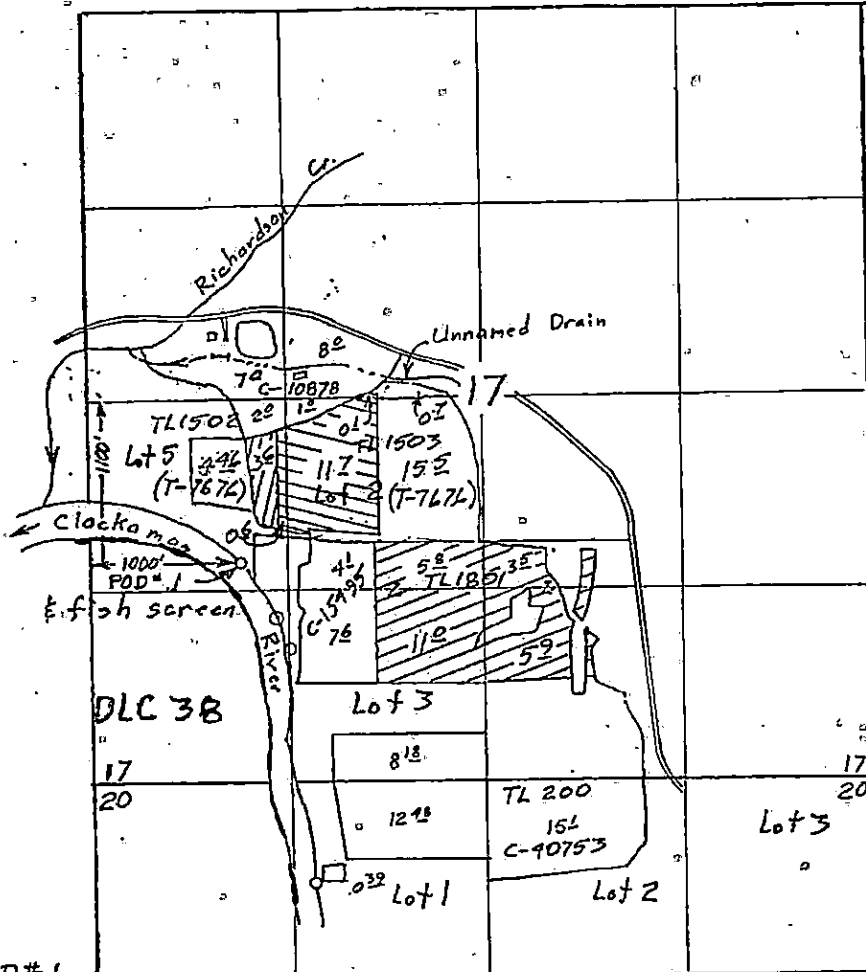

Scale 1" = 1320'
(4" = 1 mile)

TO: POD#1

Surveyed Sep 18, 2000

- ⊗ C-40753 12 $\frac{1}{2}$ acres (POU & POD)
- ⊗ C-67377 3 $\frac{1}{2}$ acres (POU & POD)
- ⊗ C-67377 26 $\frac{2}{3}$ acres (POD)


T-8053

RECEIVED

JAN 18 2020

OWRD

Claim of Beneficial Use Map
for
JIM CALCAGNO

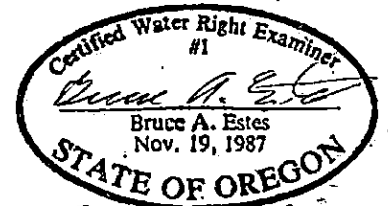

Received Dec 31, 2013

This map is for the purpose of locating a water right only and has no intent to provide legal dimensions or the location of property lines.

ESTES SURVEYS, LLC
 6293 Sunnyview Rd. NE Salem, OR 97905 (503) 586-7593
 60382 Arnold Rd. Bend, OR 97702 (503) 382-7391