



T15S R15E, WM
CROOK COUNTY, OREGON

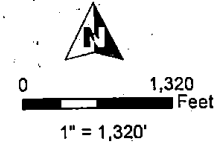


- Well
- ⊙ Meter
- Pipeline
- Bulge in System
- POU IR
- Township
- Section
- Quarter Quarter
- Tax Lot

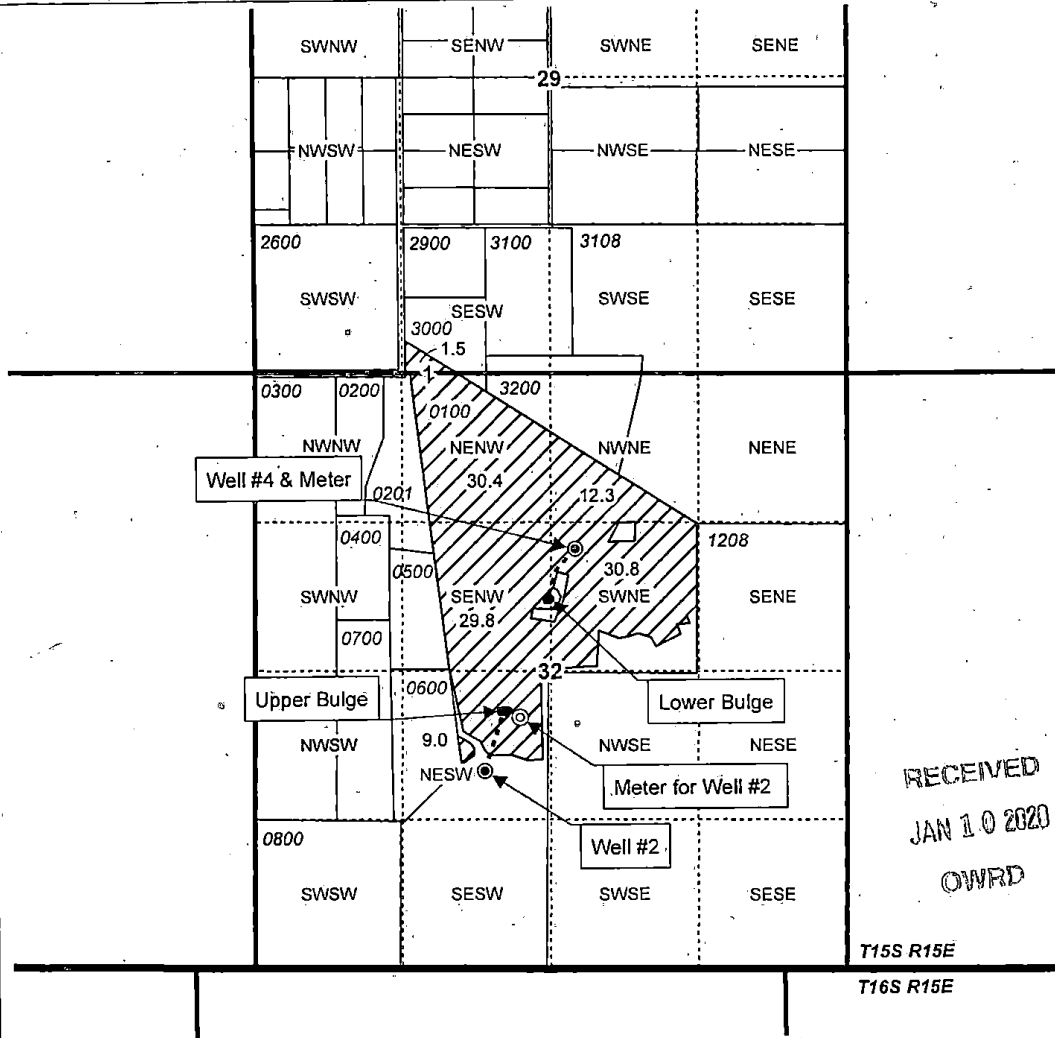

Well Locations:
 #2 (CROO 1999): 1750' N, 2050' E OF SW COR SEC 32
 #4 (L-121059): 3690' N, 2870' E OF SW COR SEC 32

RECEIVED
 JAN 10 2020
 OWRD

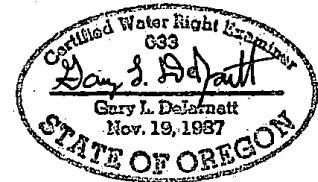

RENEWAL DATE 12/31/2021

CLAIM OF BENEFICIAL USE MAP
Stillman Ranch

NOTE: THIS MAP IS NOT INTENDED TO
 PROVIDE LEGAL DIMENSIONS OR LOCATIONS
 OF PROPERTY OWNERSHIP LINES.

WATER RIGHT SERVICES, LLC
 PO BOX 1830, BEND, OR 97709
 CCB# 197121 www.oregonwater.us
 541-389-2837 JOHNSHORT@USA.COM

AP G-14494/T-12580

PERMIT G-18016

Project #19016

January 2, 2020