


T27S, R31E, WM

RECEIVED


MAY 15 2009

WATER RESOURCES DEPT
SALEM, OREGON

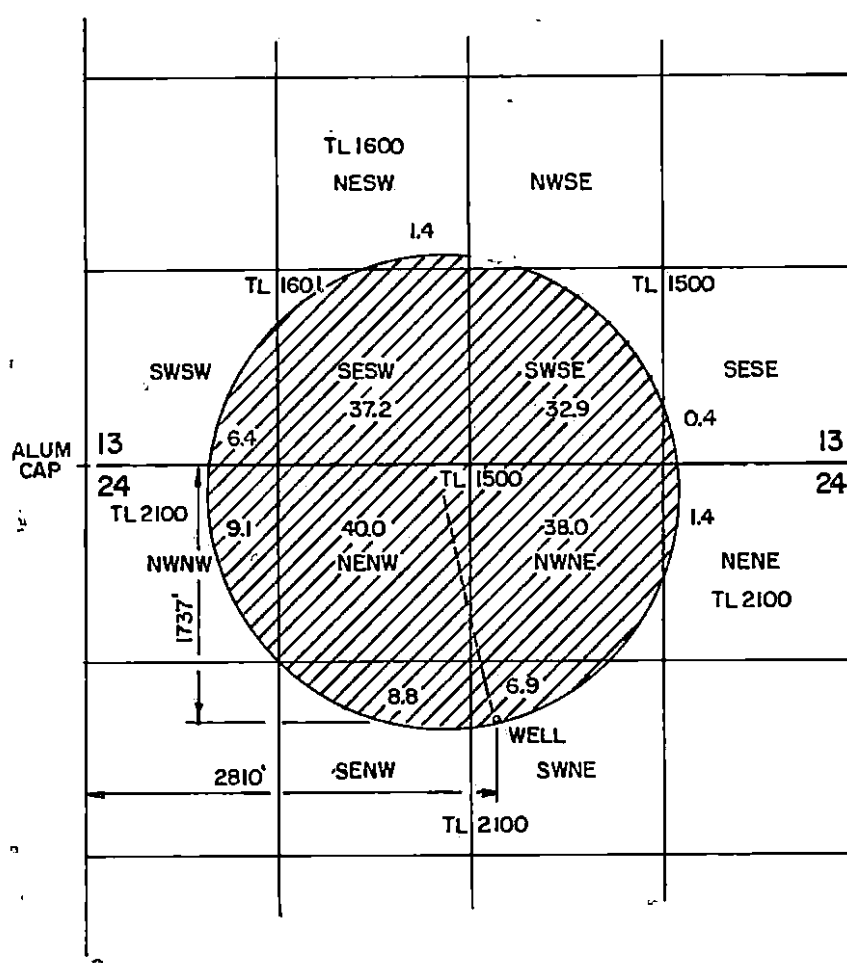

THE FLOW METER IS 4'S OF PIVOT CENTER

THE PURPOSE OF THIS MAP IS TO
IDENTIFY THE LOCATION OF THE
WATER RIGHT. IT IS NOT INTENDED
TO PROVIDE INFORMATION RELATIVE
TO THE LOCATION OF PROPERTY
OWNERSHIP.

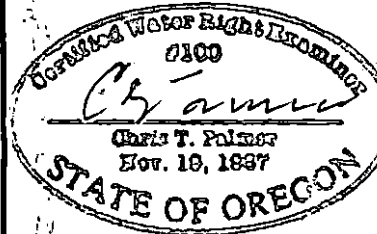 Chris T. Palmer Nov. 10, 1897 RENEW 1-1-2011	FINAL PROOF SURVEY			IN THE NAME OF THOMAS R. DAVIS	
	UNDER APPLICATION G-16953 PERMIT G-16315				
	Scale: 4" = 1 MILE	Date: AUG. 2008		Job: 2515C	
	Dsn:	 M.A. PALMER & SONS, INC. ENGINEERING & SURVEYING 711 Ponderosa Village • Box 61 Burns, Oregon 97720		Sht. No.	
Drm: CHRIS	of 1				
Ckd:					