


T.27S., R.35E., W.M.

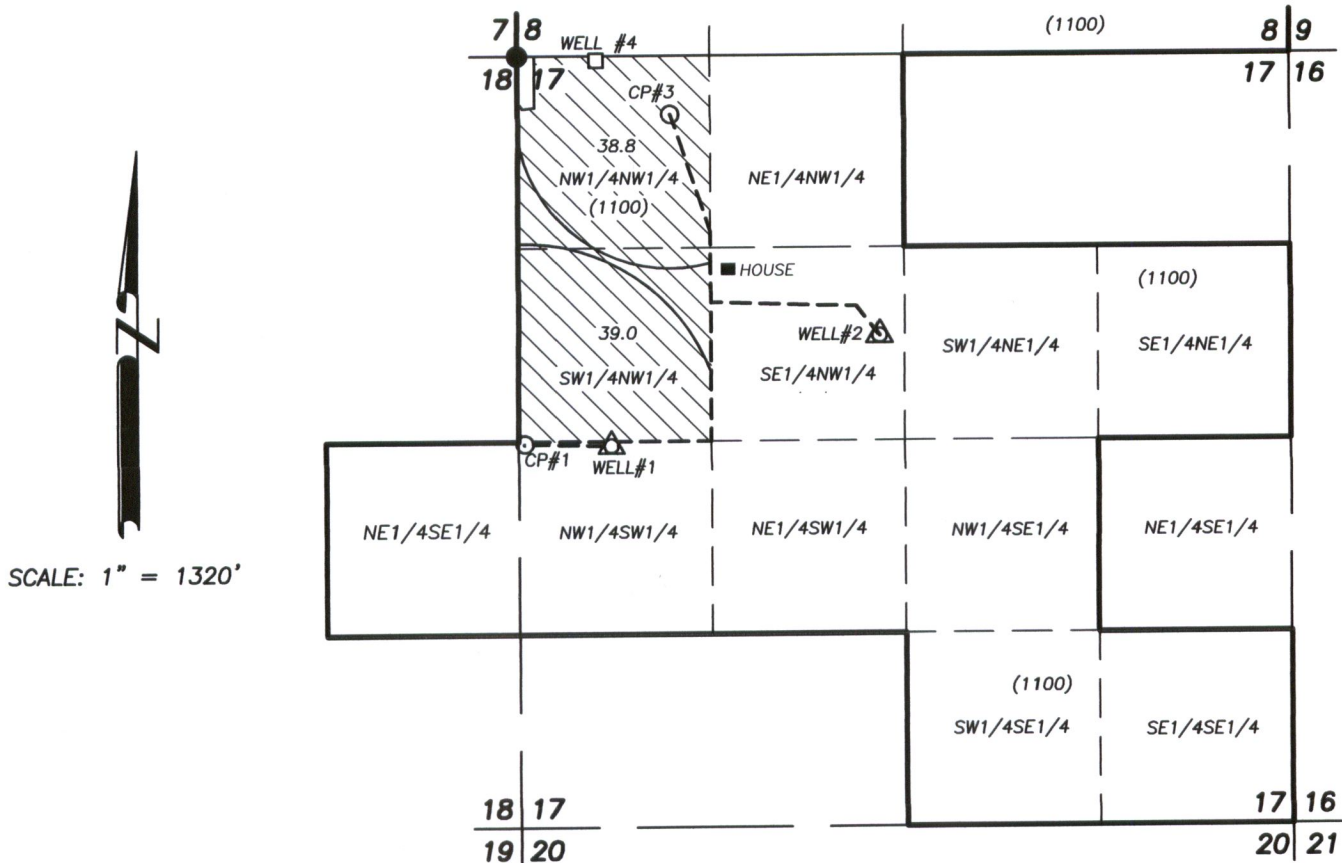

TRANSFER APPLICATION MAP CHANGE IN POINTS OF APPROPRIATION

IN NAME OF

M. MARTIN AND ANDREA DAVIES
UNDER CERTIFICATE 52037

□ AUTHORIZED POA - WELL #4
30 FT. SOUTH & 540 FT. EAST FROM THE
NW COR. SEC. 17

△ PROPOSED POA - WELL #1
2670 FT. SOUTH & 630 FT. EAST FROM
THE NW COR. SECTION 17

△ PROPOSED POA - WELL #2
1920 FT. SOUTH & 2470 FT. EAST FROM
THE NW COR. SEC. 17

▨ PLACE OF USE C-52037
PRIORITY DATE MARCH 14, 1977

--- BURIED MAINLINE

() TAX LOT

● FOUND SECTION COR. MONUMENT

CP#
○ CENTER PIVOT

PREPARED BY:

ROBERT D. BAGETT, PLS, CWRE
217 N. CANYON BLVD.
JOHN DAY, OREGON 97845
(541) 575-1251

FEBRUARY 15, 2018

RECEIVED

MAR 12 2018


OWRD



RENEWES: 12/31/2019

THIS MAP IS NOT INTENDED TO PROVIDE LEGAL
DIMENSIONS OR LOCATIONS OF PROPERTY OWNERSHIP
LINES

T.27S.,R.35E.,W.M.

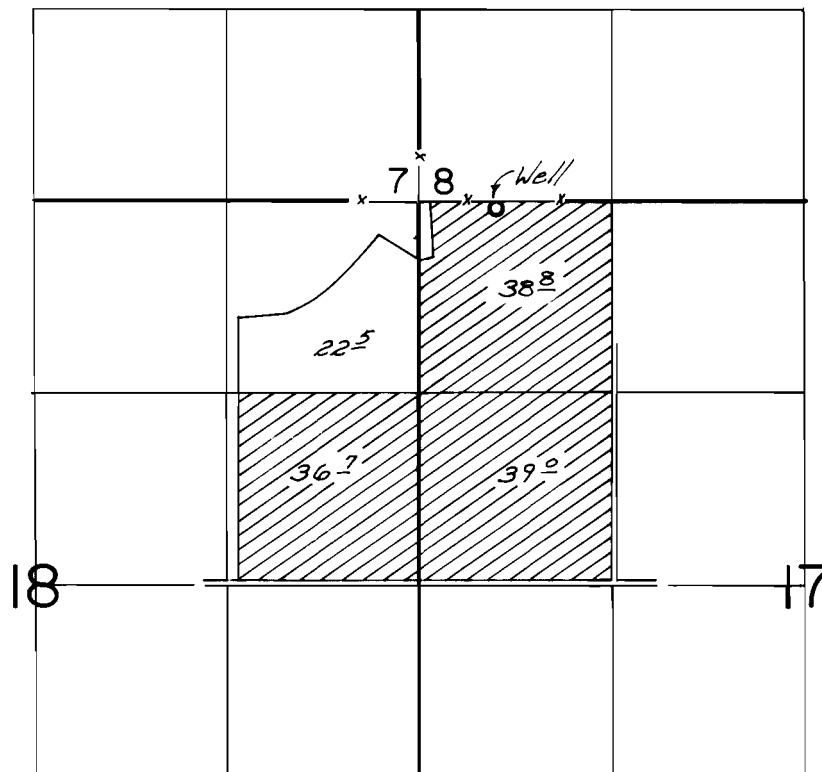

Well Loc: 30' S. & 540' E. from the NW Corner Section 17

FINAL PROOF SURVEY
UNDER

Application No. G-7921 Permit No. G-7312
IN NAME OF

M. M. DAVIES

Surveyed AUG. 26, 1979, by R. G. MUCKEN