


T 24 S, R 30 E, WM

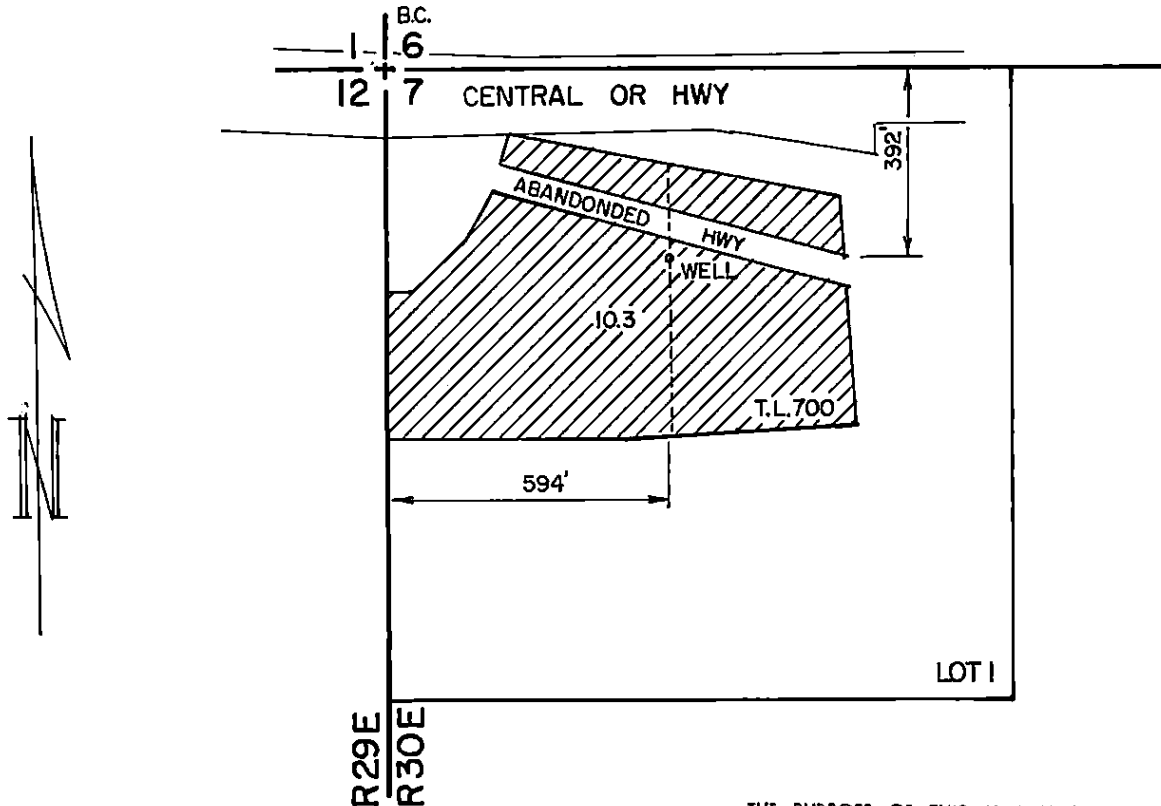

RECEIVED

JUN 20 2002

**WATER RESOURCES DEPT.
SALEM, OREGON**

THE PURPOSE OF THIS MAP IS TO
IDENTIFY THE LOCATION OF THE
WATER RIGHT IT IS NOT INTENDED
TO PROVIDE INFORMATION RELATIVE
TO THE LOCATION OF PROPERTY
OWNERSHIP.

FINAL PROOF SURVEY

UNDER
APPLICATION NO. G-12111
PERMIT NO. G-12283

IN THE NAME OF
WILLIAM & KAY HART

Scale: 1" = 400'

Date: 06-12-2002

Job: 1217-02

Dsn:

Drm: CHRIS


Ckd:

M.A.P's

M.A. PALMER & SONS, INC.
ENGINEERING & SURVEYING
711 Ponderosa Village • Box 61
Burns, Oregon 97720

Sht. No.

of 1

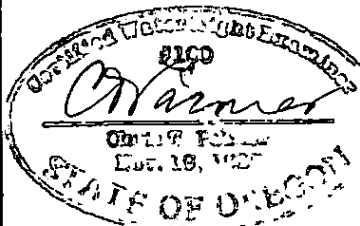

RENEW 1-1-2003