

RECEIVED BY OWRD




FINAL PROOF MAP

MAY 25 2016

TO ADD PLACE OF USE AND
A POINT OF APPROPRIATION
FOR APPLICATION G-16306
WILLIAM DUNBAR

SALEM, OR

TOWNSHIP 22 SOUTH, RANGE 30 EAST, SECTION 9, W.M.
TAX LOT: 800 HARNEY COUNTY, OREGON

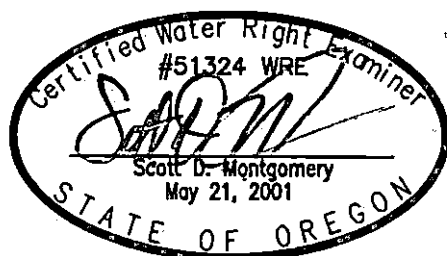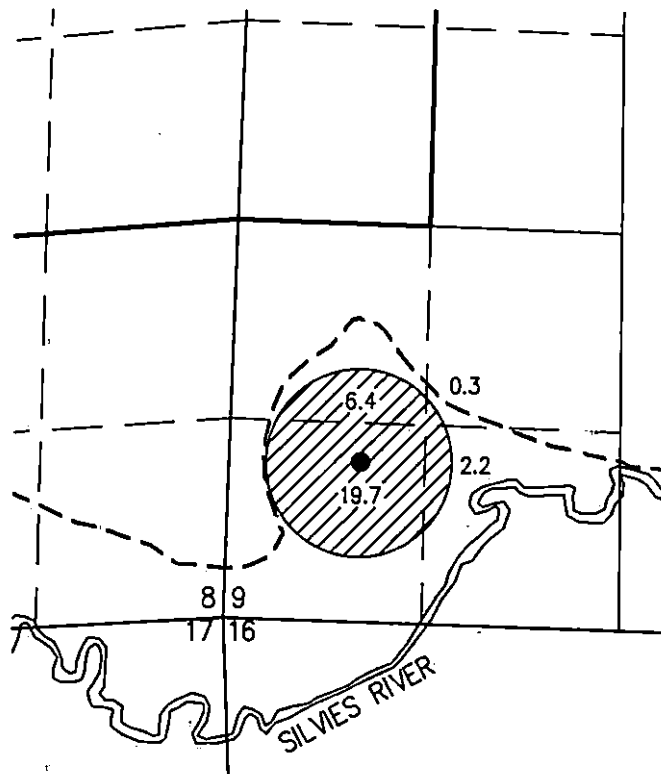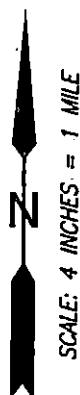

RENEWAL DATE: 12/31/2016

THIS MAP IS FOR THE PURPOSE OF LOCATING A WATER
RIGHT ONLY AND HAS NO INTENT TO PROVIDE LEGAL
DIMENSIONS OR THE LOCATION OF PROPERTY LINES



28.6 ACRES FROM G-15928,
AS SHOWN

- POA
EXISTING WELL (HARN 50973)
1270' NORTH 880' EAST FROM THE SW CORNER
SECTION 8

FLOWMETER IS LOCATED ON THE DELIVERY PIPE
7 FEET SW OF THE WELL

PREPARED FOR:

WILLIAM DUNBAR
9622 VICTOR ROAD
ANCHORAGE, AK 99515

PREPARED BY:



ALL POINTS ENGINEERING AND SURVEYING, INC.
P.O. BOX 767
(541) 548-5833
TERREBONNE, OR 97760
www.APEandS.com