


9611

RECEIVED
SEP 09 2018
OWRD
1196 A-7

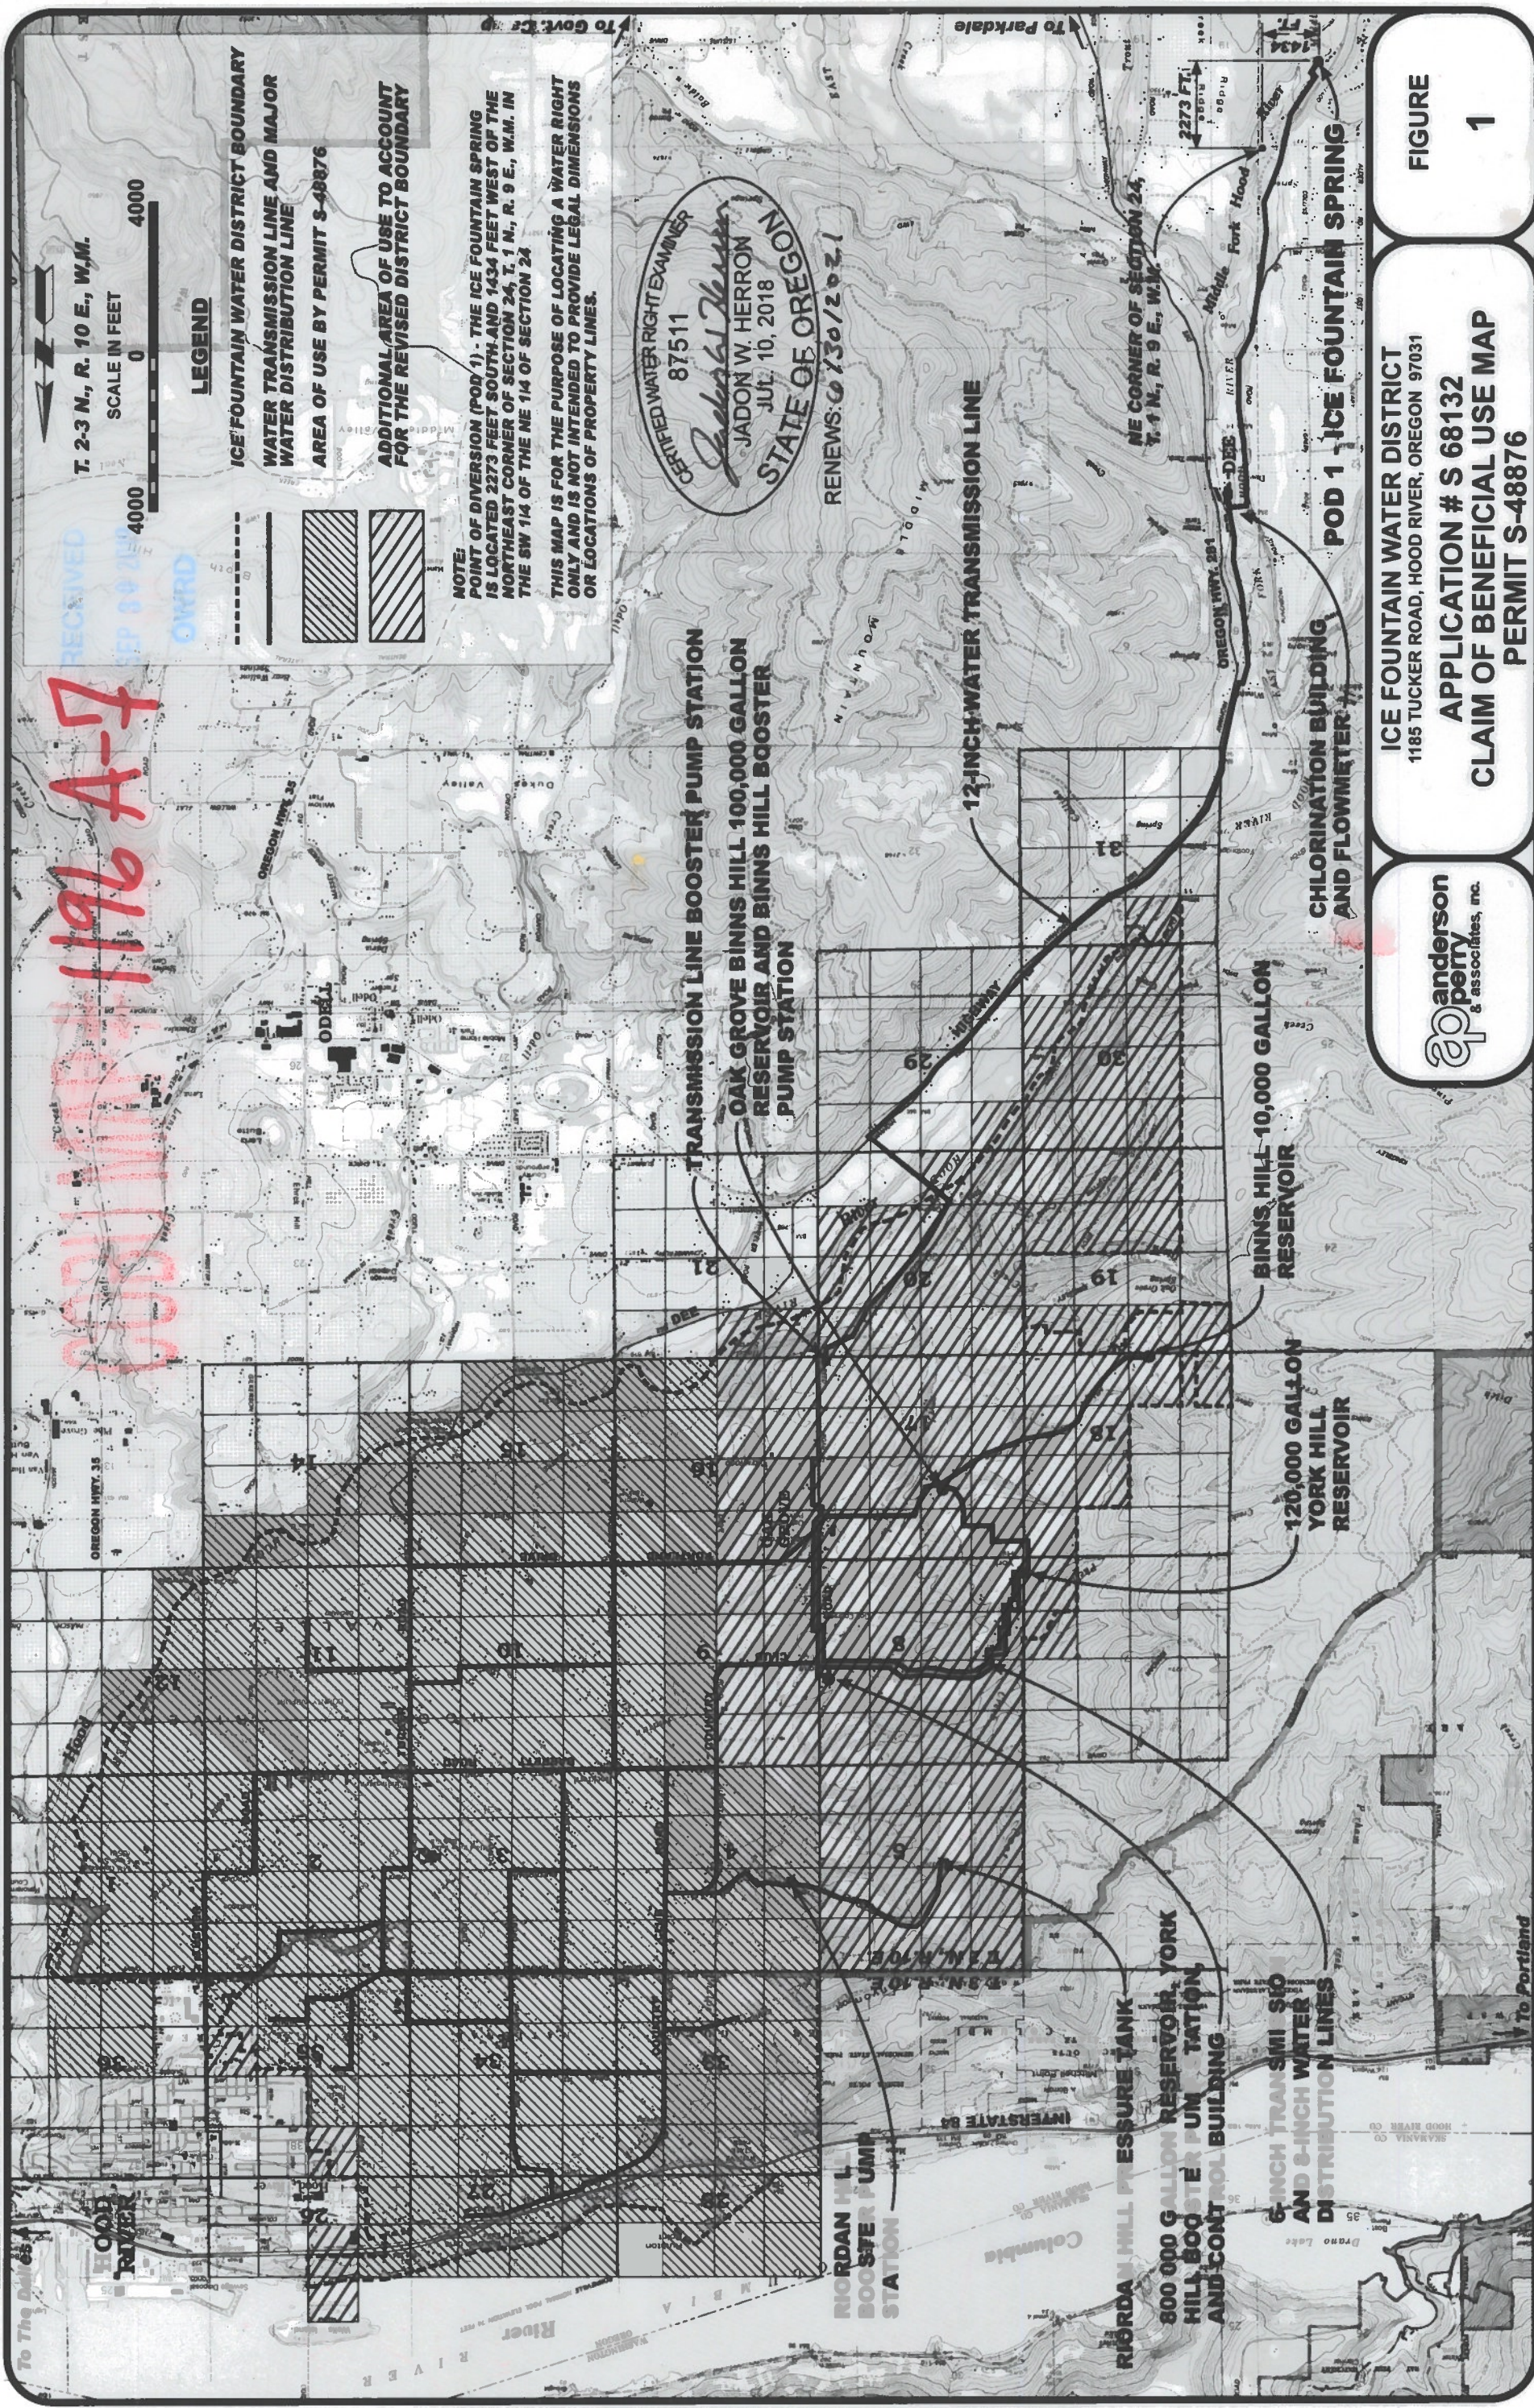

T. 2-3 N., R. 10 E., W.M.
SCALE IN FEET
0 4000

LEGEND

- ICE FOUNTAIN WATER DISTRICT BOUNDARY
- WATER TRANSMISSION LINE AND MAJOR WATER DISTRIBUTION LINE
- ▨ AREA OF USE BY PERMIT S-48876
- ▨ ADDITIONAL AREA OF USE TO ACCOUNT FOR THE REVISED DISTRICT BOUNDARY

NOTE:
POINT OF DIVERSION (POD 1) - THE ICE FOUNTAIN SPRING IS LOCATED 2273 FEET SOUTH AND 1434 FEET WEST OF THE NORTHEAST CORNER OF SECTION 24, T. 1 N., R. 9 E., W.M. IN THE SW 1/4 OF THE NE 1/4 OF SECTION 24

THIS MAP IS FOR THE PURPOSE OF LOCATING A WATER RIGHT ONLY AND IS NOT INTENDED TO PROVIDE LEGAL DIMENSIONS OR LOCATIONS OF PROPERTY LINES.

CERTIFIED WATER RIGHT EXAMINER
87511
Jadon W. Herron
JADON W. HERRON
JUL. 10, 2018
STATE OF OREGON
RENEWS: 6/30/2021

TRANSMISSION LINE BOOSTER PUMP STATION
OAK GROVE BINNS HILL 100,000 GALLON RESERVOIR AND BINNS HILL BOOSTER PUMP STATION

RIOGDAN HILL BOOSTER PUMP STATION

RIOGDAN HILL PRESSURE TANK
800,000 GALLON RESERVOIR, YORK HILL BOOSTER PUMP STATION AND CONTROL BUILDING

6-INCH TRANSMISSION AND 8-INCH WATER DISTRIBUTION LINES

120,000 GALLON YORK HILL RESERVOIR

BINNS HILL - 10,000 GALLON RESERVOIR

12-INCH WATER TRANSMISSION LINE

CHLORINATION BUILDING AND FLOWMETER

POD 1 ICE FOUNTAIN SPRING

ICE FOUNTAIN WATER DISTRICT
1185 TUCKER ROAD, HOOD RIVER, OREGON 97031
APPLICATION # S 68132
CLAIM OF BENEFICIAL USE MAP
PERMIT S-48876



FIGURE
1