
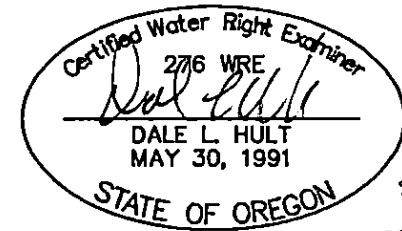


FINAL PROOF MAP

LOCATED IN THE N.E. 1/4 OF THE S.E. 1/4 OF SECTION 6
TOWNSHIP 1 SOUTH, RANGE 4 EAST, W.M.
MULTNOMAH COUNTY, OREGON

APPLICATION NO. G-13580 PERMIT NO. G-12360

CLIENT: KENNETH KERSLAKE

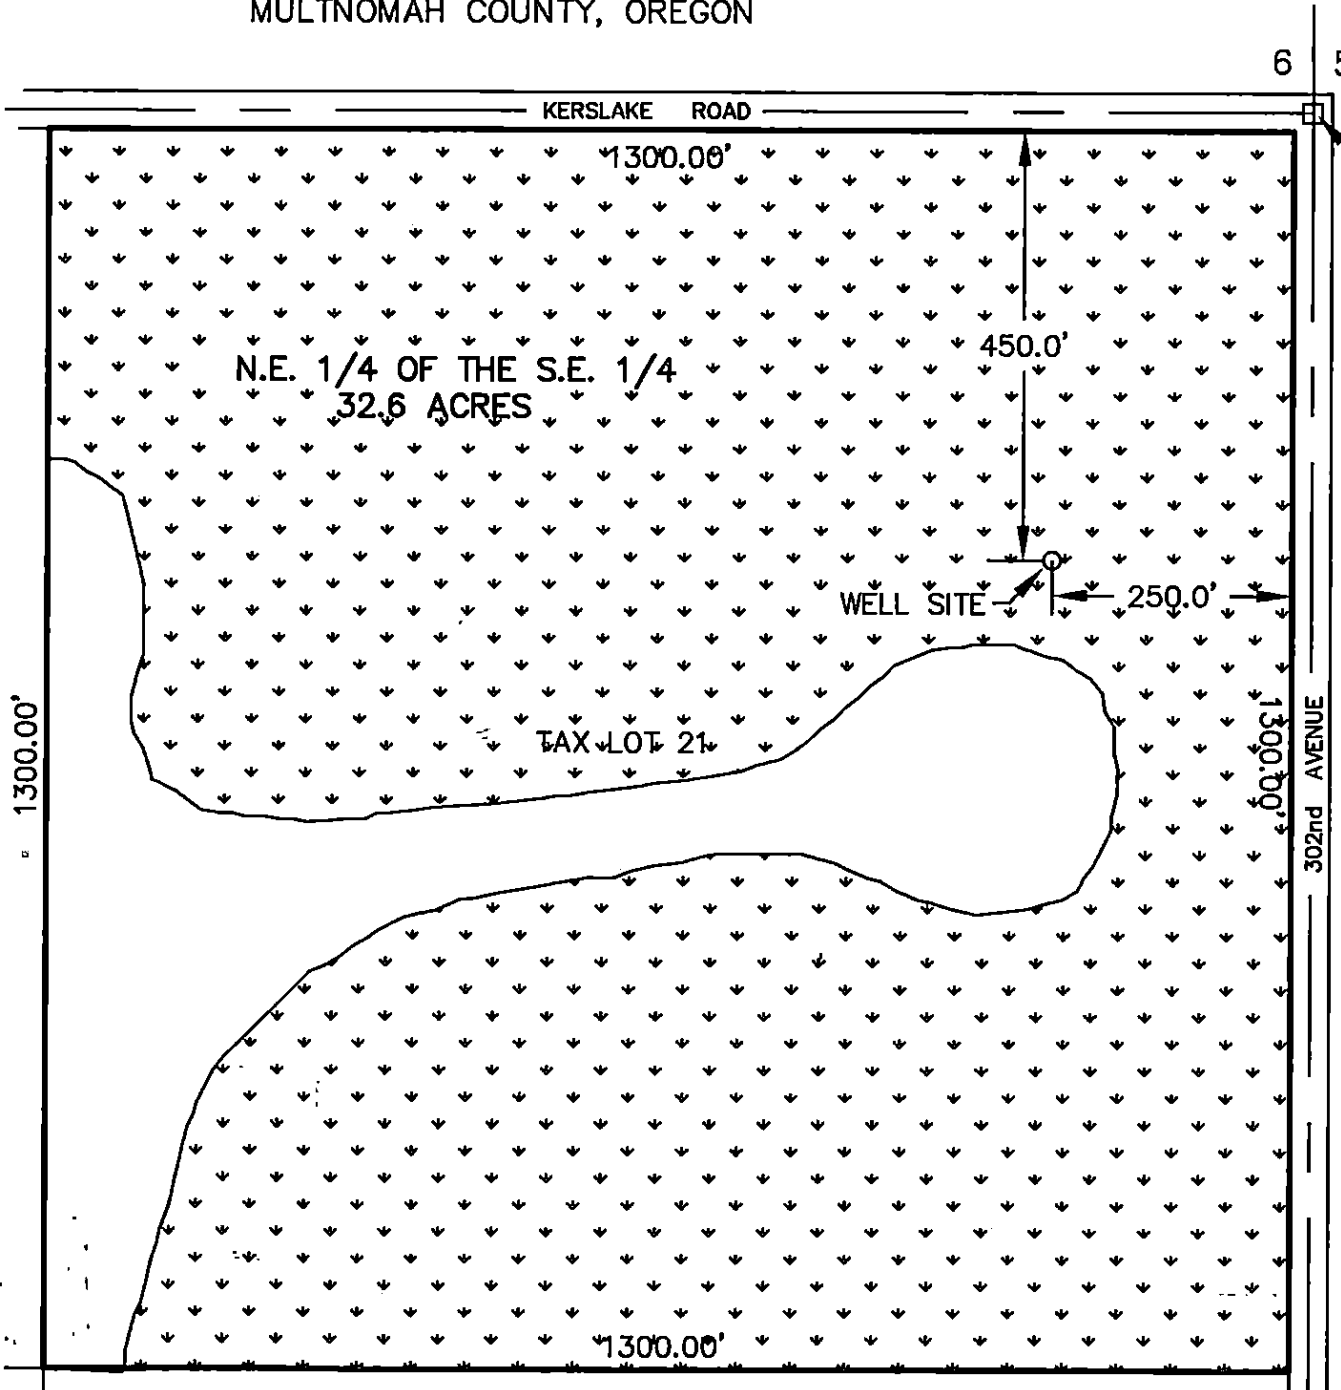

WATER RESOURCES DEPT.
SALEM, OREGON

SEP 15 1999

RECEIVED

SCALE: 1" = 200'
Sept 1, 1999



CULTIVATED AREA = 32.60 ACRES

THIS DRAWING IS NOT A LAND SURVEY.
PROPERTY LINES AND/OR OTHER LINES OF
OCCUPATION SHOWN HEREON ARE NOT
REPRESENTED BY THE UNDERSIGNED TO
MEET ACURACY STANDARDS OF LAND
SURVEYS.



all COUNTY SURVEYORS
& PLANNERS, INC.
P.O. BOX 955
SANDY, OREGON 97055
(503) 668-3151

JOB #93-213