


T.I4S.R.II&I2E.W.M.

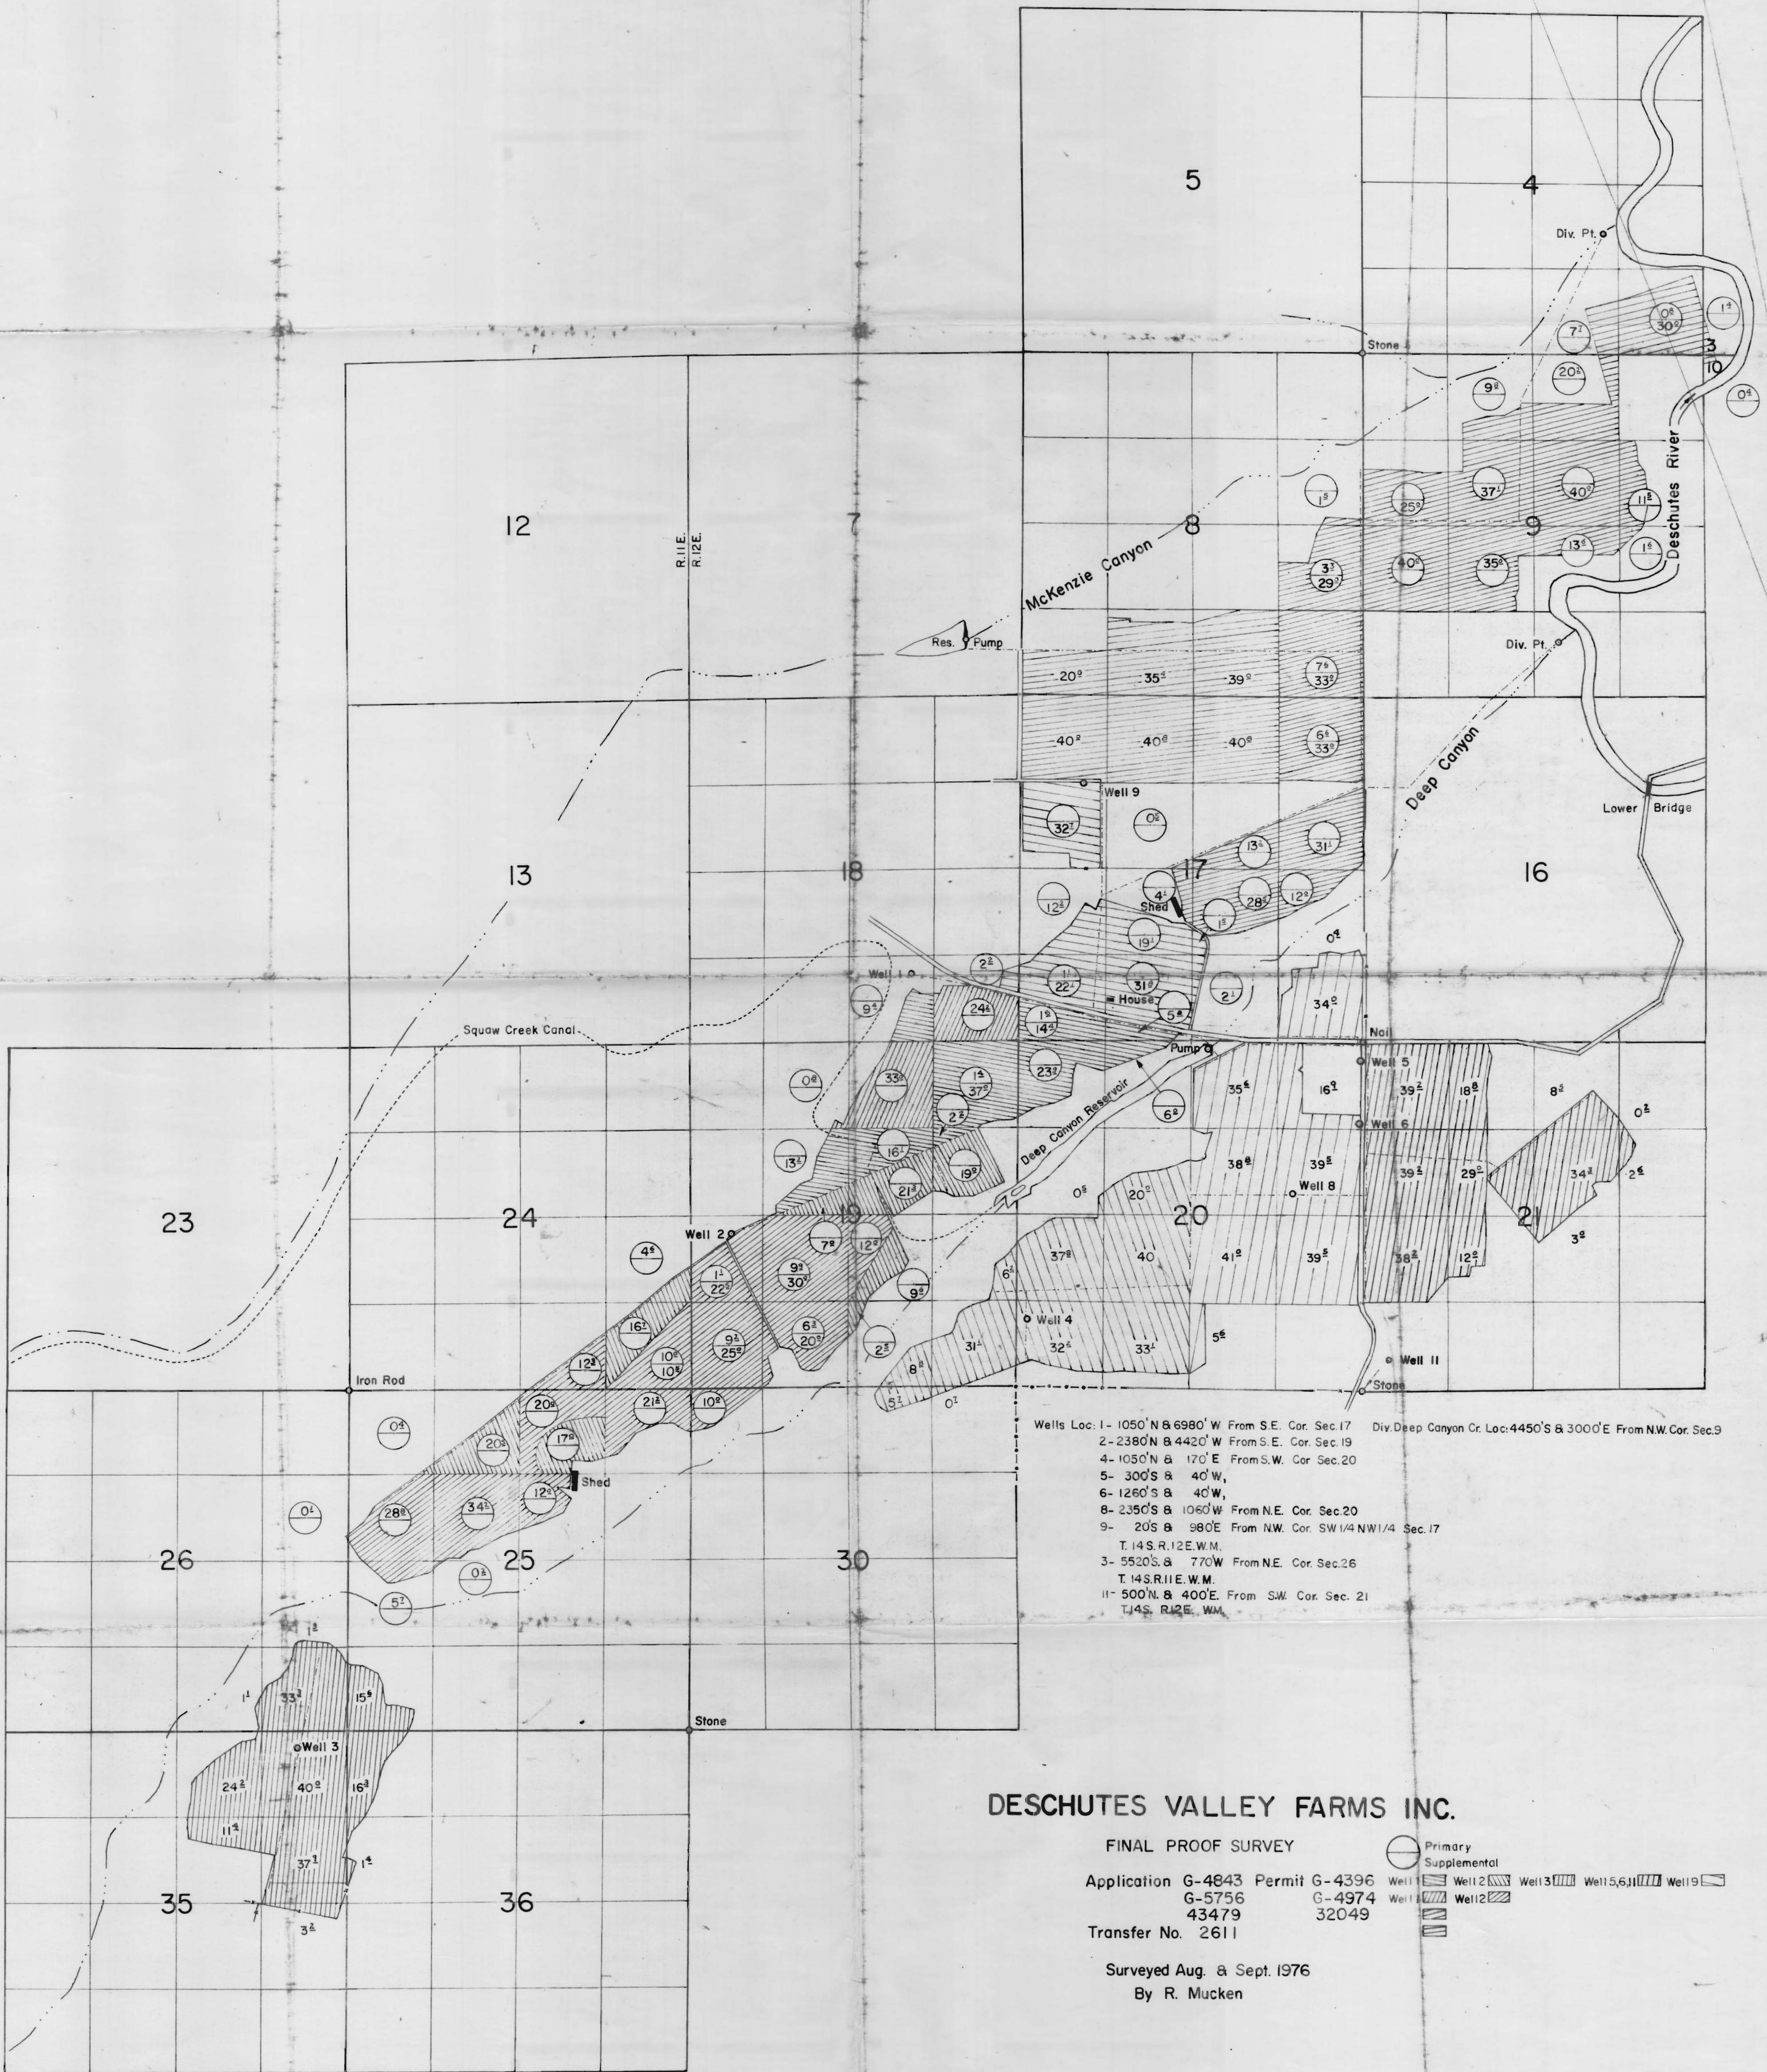

DESCHUTES VALLEY FARMS INC.


FINAL PROOF SURVEY

Application G-4843 Permit

Application G-4843 Permit G-4396 Well
G-5756 G-4974 Well
43479 32049


Surveyed Aug. & Sept. 1976
By R. Mucken

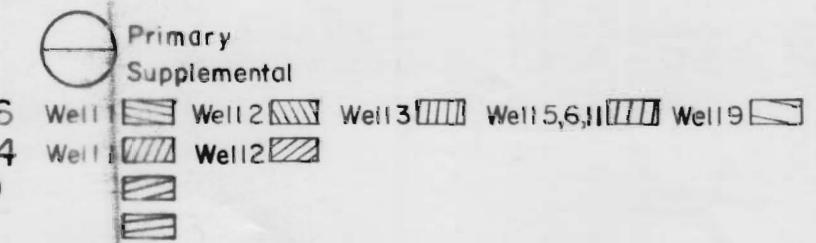

T-12909

Application Map


Water Rights Transfer

"Off" Map


RECEIVED

APR 20 2018

OWRD

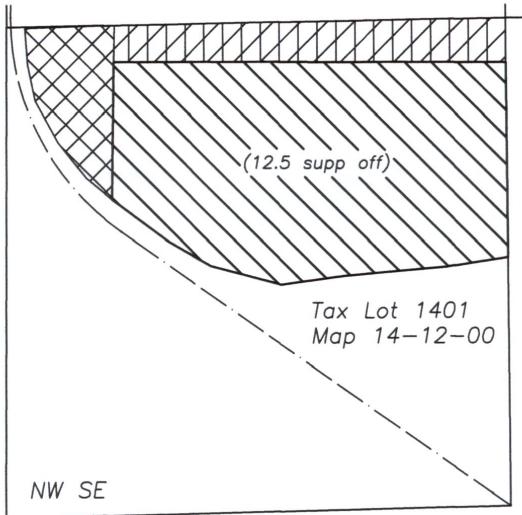


Section 18
T14S R12E
Deschutes Co. OR

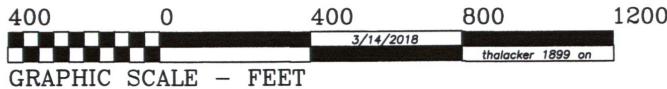

GRAPHIC SCALE - FEET

This map is for the purpose of identifying the location of the water right. It is not intended to provide legal dimensions or locations of property ownership lines.

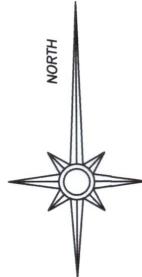

Renewal date: 6/30/2018



12.5 acres supplemental water to transfer off
(Cert. 74196, priority date 4/15/1969)



Water remaining (Certificate 74196)



Primary water remaining
(Certificate 74135 1895)



Primary water remaining
(Certificate 74135 1904)

Sheet 2 of 4

Off Map

14-12-18

N
↑

1401

Marc & Pamela
Thalacker

28.5

40.5

37.0

32.5

12.5

12.5

T : 0:36

NW SE

Acres to be transferred
OFF

RECEIVED
JUN 10 2009
WATER RESOURCES DEPT
SALEM, OREGON

