

PREPARED FOR:
 TUALATIN VALLEY IRRIGATION DISTRICT
 2330 ELM STREET
 FOREST GROVE, OR 97116

PREPARED FOR:
 KEVIN & CARRIE DUYCK TRUST
 37995 NW HARRINGTON RD
 CORNELIUS, OR 97113

T-12840 Claim of Beneficial Use Map

SECTION 11, T1N, R4W, WM
 TAX MAP 1N 4W 11
 WITHIN THE LOUSIGNOUT DLC #52
 WASHINGTON COUNTY, OREGON

CERTIFICATE 53836

18 ACRES IN THE NW OF SE AND
 12 ACRES IN THE NE OF THE SE QTR

CERTIFICATE 88122 (P)

22 ACRES IN THE SW OF
 NW AND 8 ACRES IN THE SE OF THE
 NW FOR REMAINING RIGHT SEE
 TUALATIN VALLEY IRRIGATION DISTRICT

CERTIFICATE 81270(S)C

22 ACRES IN THE SW
 OF THE NW QTR AND 8.0 ACRES IN
 THE SE OF THE NW

CERTIFICATE 88122 PRIME
 Remaining Right


CERTIFICATE 53836(P)-CF
 VANDEHAY

RECEIVED
 FEB 01 2018
 Received by OWRD

FEB 14 2020 OWRD

Salem, OR **Stuntzner**
 Engineering & Forestry, LLC

Project: 315-067
 By: JEFFREY KEE
 Date: JAN 26, 2018

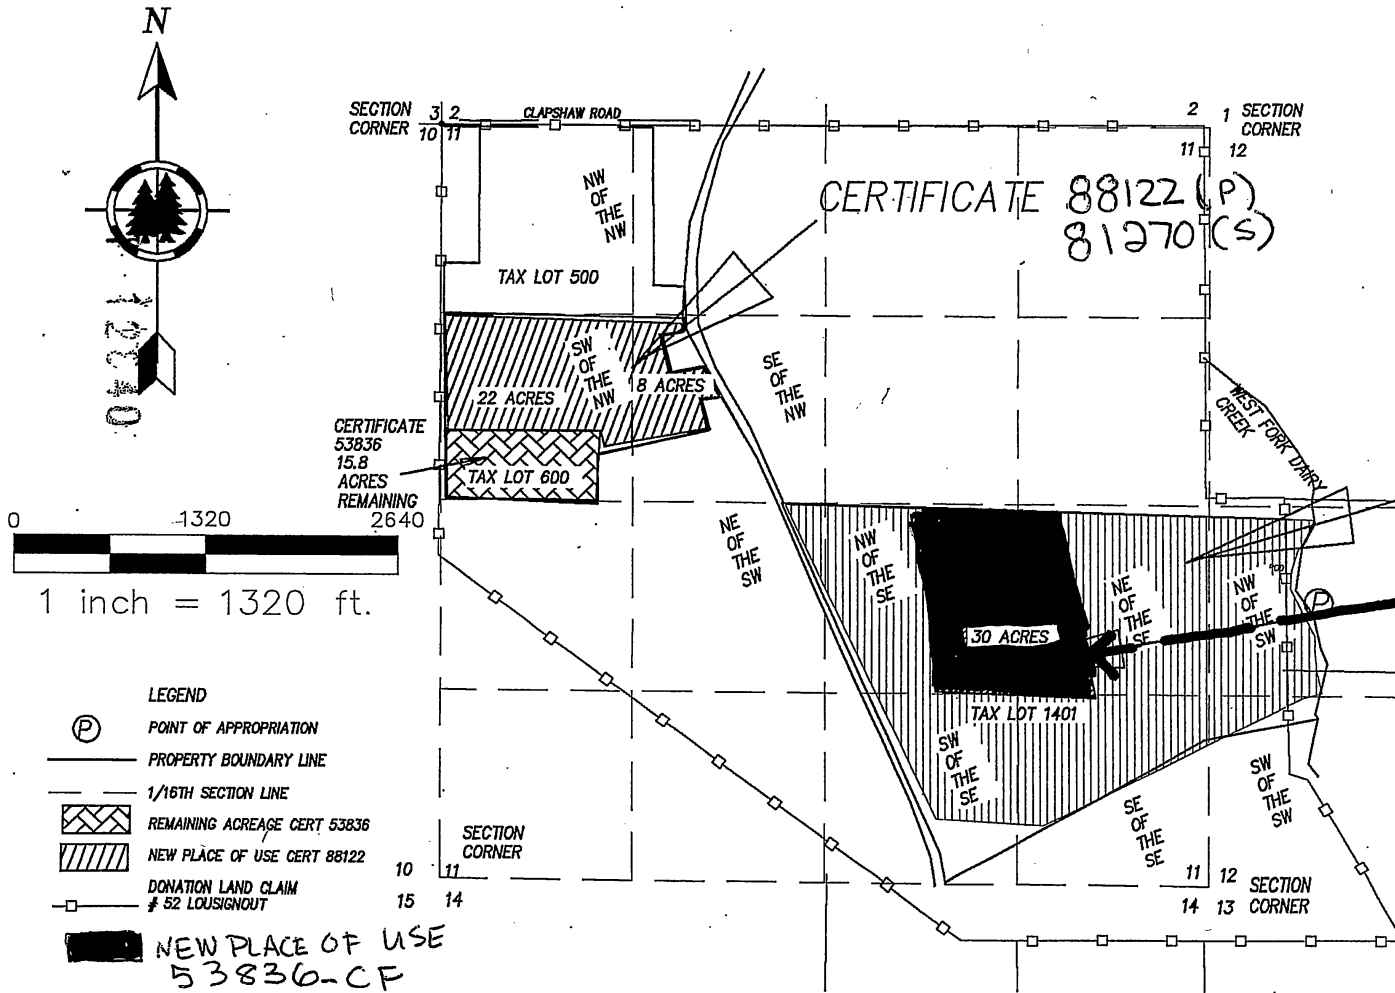

THIS DRAWING IS INTENDED TO PROVIDE AN APPROXIMATE LOCATION FOR WATER RIGHTS.
 IT IS NOT INTENDED, NOR DOES IT DEPICT PROPERTY BOUNDARIES.

T-12840