

RECEIVED

FEB 20 2020


OWRD

T.4S. R.4W. Section 32 and T.5S. R.4W. Sec. 5, 6, 7, & 8, W.M.

Reed POD is located in T.5S. R.4W. Section 6, SE SE, DLC 37. Certificate 89239 (7.2 acres)
Robinson POD is located 375 south and 1,880 feet west from the easterly SE corner, DLC 37. Certificate 89239. (7.2 acres)
Tresham POD is located 378 feet north and 620 feet east from the easterly SE corner, DLC 37. Cert 76822, 76824, and 89239.
(6.53, 18.7, and 7.2 acres, respectively)

- Area (6.53 acres, formerly of Certificate 76822), irrigated under T-12561, priority date: May 15, 1939.
- Area (18.7 acres, formerly of Certificate 76824), irrigated under T-12561, priority date: April 30, 1965.
- Area (7.2 acres, formerly of Certificate 89239), irrigated under T-12561, priority date: September 14, 1949.

- Tax lot boundary
- Donation Land Claim boundary
- Water main line

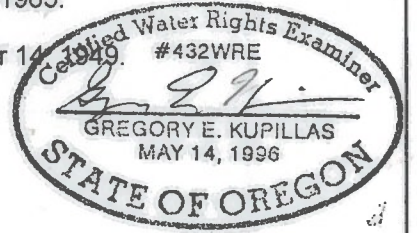

EXPIRATION DATE: 6/30/2021

Scale: 1" = 1,320'
1,320 Feet



This map was prepared for the purpose of identifying the location of a water right only and is not intended to provide legal dimensions or location of property ownership lines.

Pacific Hydro-Geology Inc.

09/2019

Robinson Nursery
T.4S. R.4W. Section 32 and
T.5S. R.4W. Sec. 5, 6, 7, & 8, W.M.

Claim of Beneficial Use Map
T-12561

