


Yamhill River

T.5S. R.4W. Sec. 6 & 7, W.M.

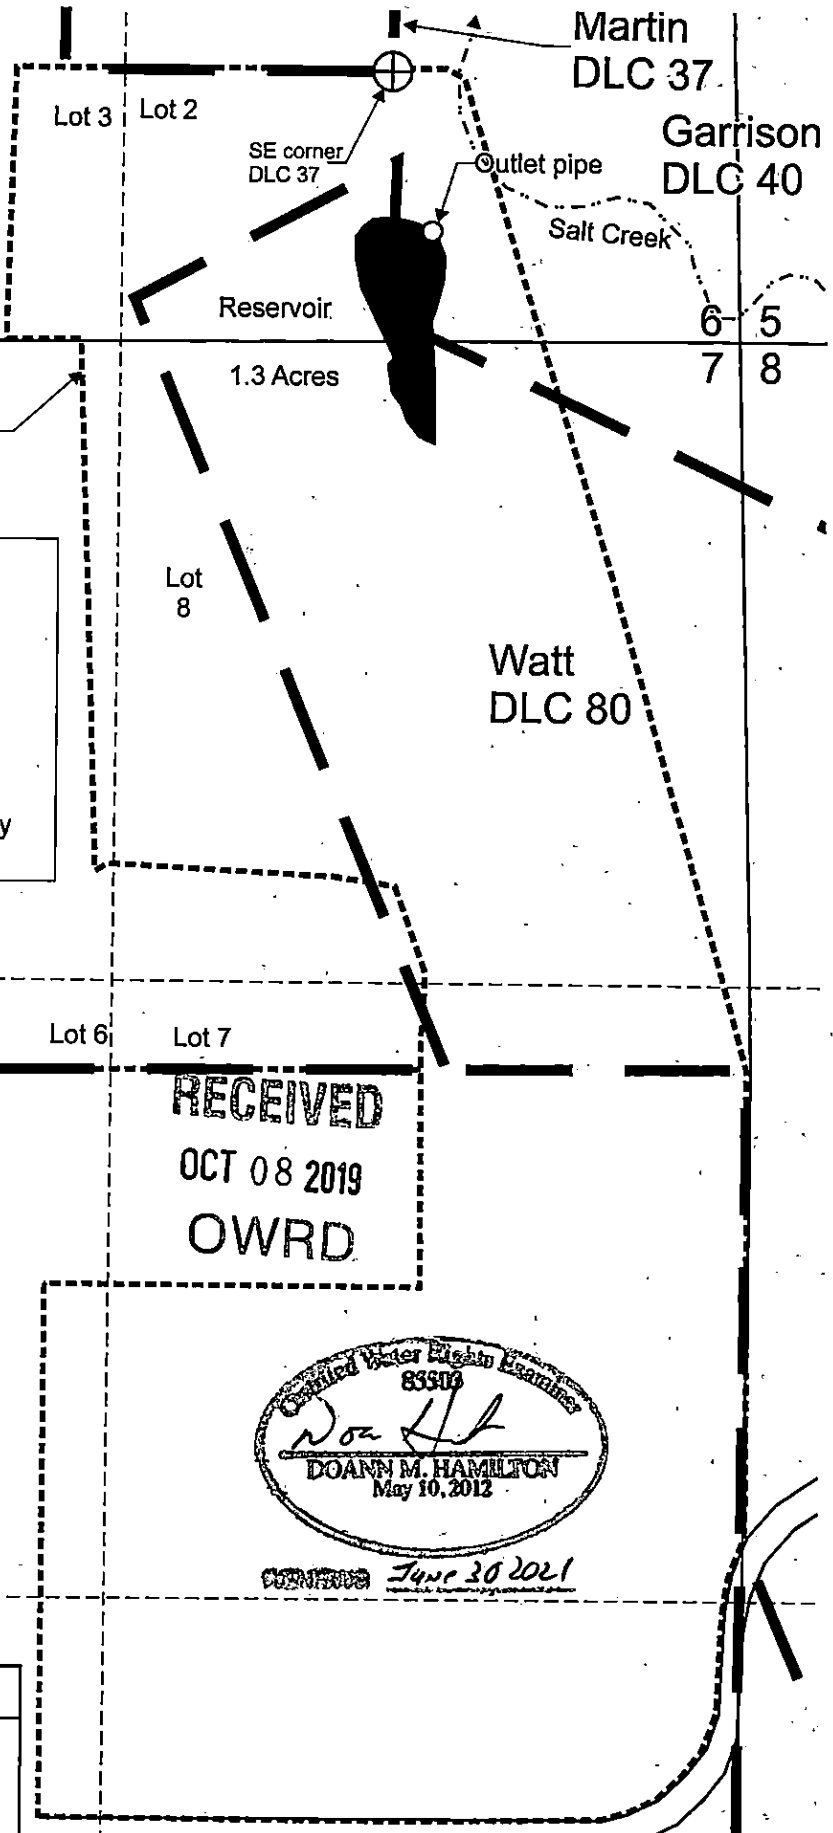

TL 5 4 07 100

Dam / POD is located 330 feet south and 85 feet east from the SE corner, DLC 37.


7.4 AF under Application R-87919, Permit R-15071.

Tax lot boundary

Donation Land Claim boundary



Scale: 1" = 400'

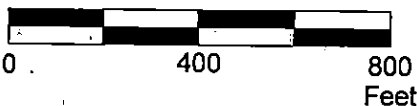


This map was prepared for the purpose of identifying the location of a water right only and is not intended to provide legal dimensions or location of property ownership lines.

Pacific Hydro-Geology Inc.

Claim of Beneficial Use Map
Application R-87919, Permit R-15071

Robinson Nursery
T.4S. R.4W. Section 32 and
T.5S. R.4W. Sec. 6 & 7, W.M.

RECEIVED
OCT 08 2019
OWRD

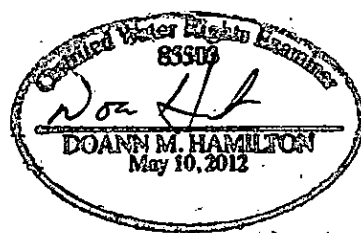

June 30 2021

RobinsonR-87919COBUMap.cdr

SW River Bend Road