

T.1S. R.4E. Section 20, W.M.

Well is located 600 feet north and 200 feet west from the SE corner, SW 1/4 SE 1/4, Section 20.

 Area (1.6 Acres) irrigated under Application G-16118, Permit G-15754.



----- Tax lot boundary

..... Irrigation mainline


RECEIVED

APR 12 2016

WATER RESOURCES DEPT
SALEM, OREGON

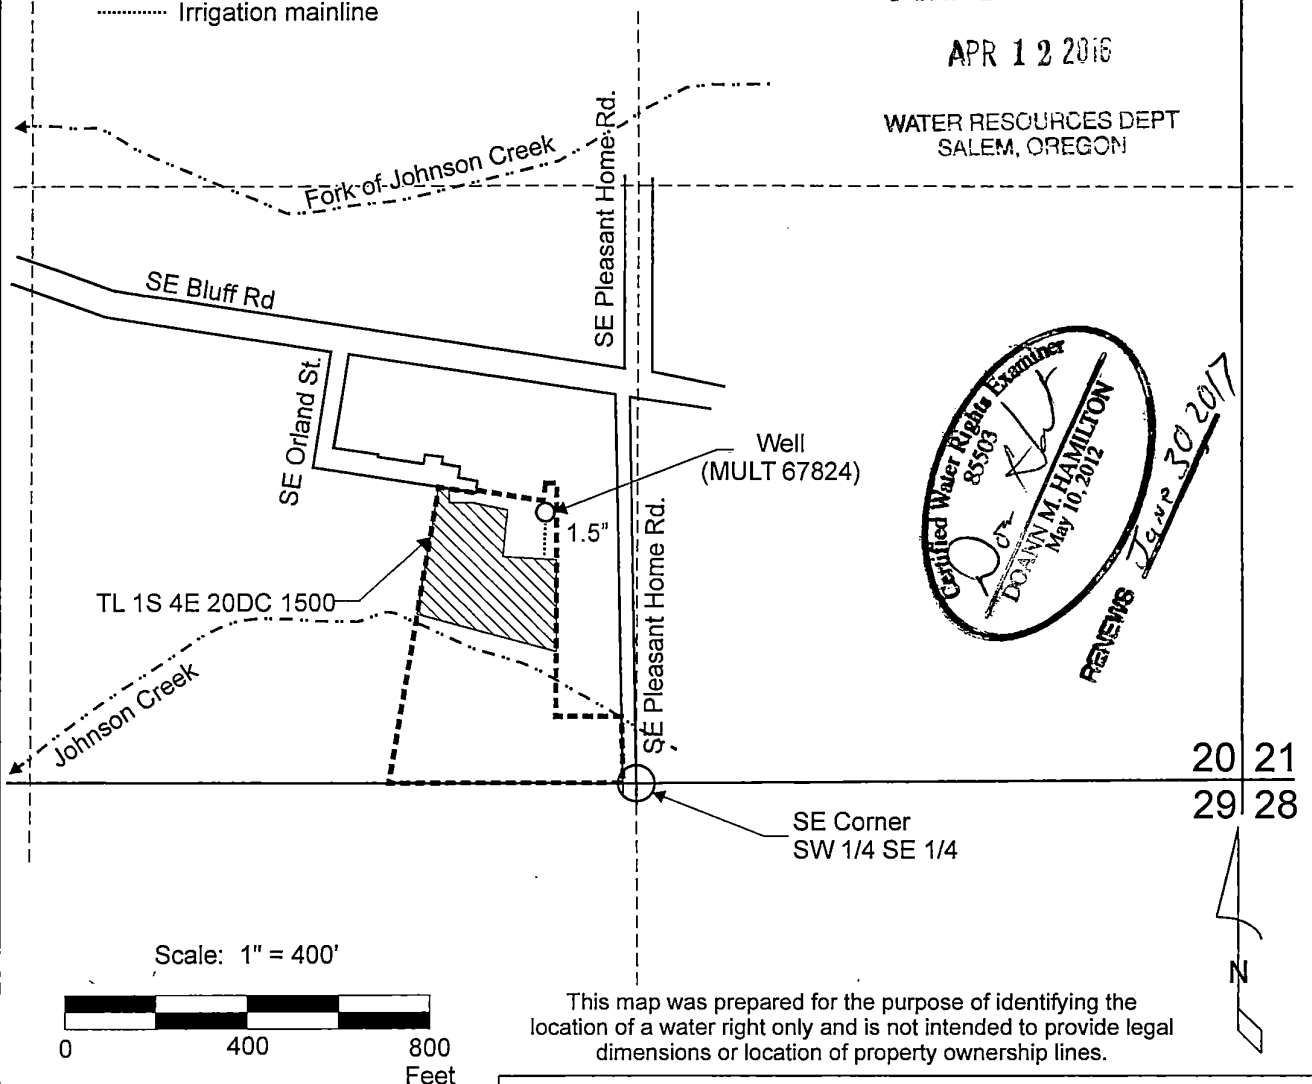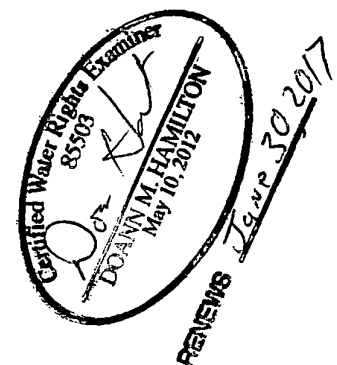

Scale: 1" = 400'

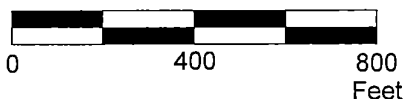

This map was prepared for the purpose of identifying the location of a water right only and is not intended to provide legal dimensions or location of property ownership lines.

Claim of Beneficial Use Map
Application G-16118, Permit G-15754

Jeff Hardin and Deborah Carpenter
T.1S. R.4E. Section 20, W.M.

Pacific Hydro-Geology Inc.

03/2016