



T24 S, R 29 E, WM

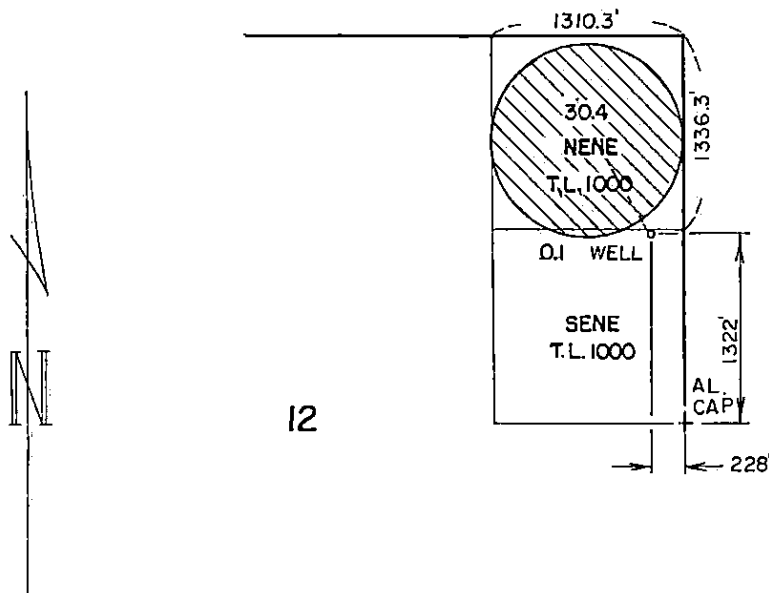

THE PURPOSE OF THIS MAP IS TO IDENTIFY THE LOCATION OF THE WATER RIGHT. IT IS NOT INTENDED TO PROVIDE INFORMATION RELATIVE TO THE LOCATION OF PROPERTY OWNERSHIP.

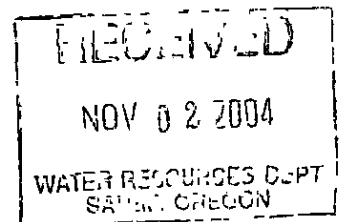

	FINAL PROOF SURVEY			IN THE NAME OF FAIRVIEW ACRES DAIRY FARMS, INC
	UNDER APPLICATION G-14183 PERMIT G-12714			
	Scale: 4" = 1 MILE	Date: SEPT. 2004	Job: 1587-04	
	Dsn:	M. A. PALMER & SONS, INC. ENGINEERING & SURVEYING 254 N. Alder - Box 61 Burns, Oregon 97720	Sht. No.	
	Drn: CHRIS		of 1	
Ckd:				