

RECEIVED

DEC 08 2015

T.9S. & 10S., R.5W., W.M.

WATER RESOURCES DEPT
SALEM, OREGON

Final Proof Survey


In the Name of

Gylan & Gwendolyn Mulkey Revocable Living Trust


Application #: S-87004 Permit #: S-54465

Surveyed on September 30, 2015 by JM Schuette

Soap Creek POD is located 50' N & 1200' E;
Gylan Mulkey Reservoir POD is located 2940' N & 510' W;
both from the SW corner of Section 1.

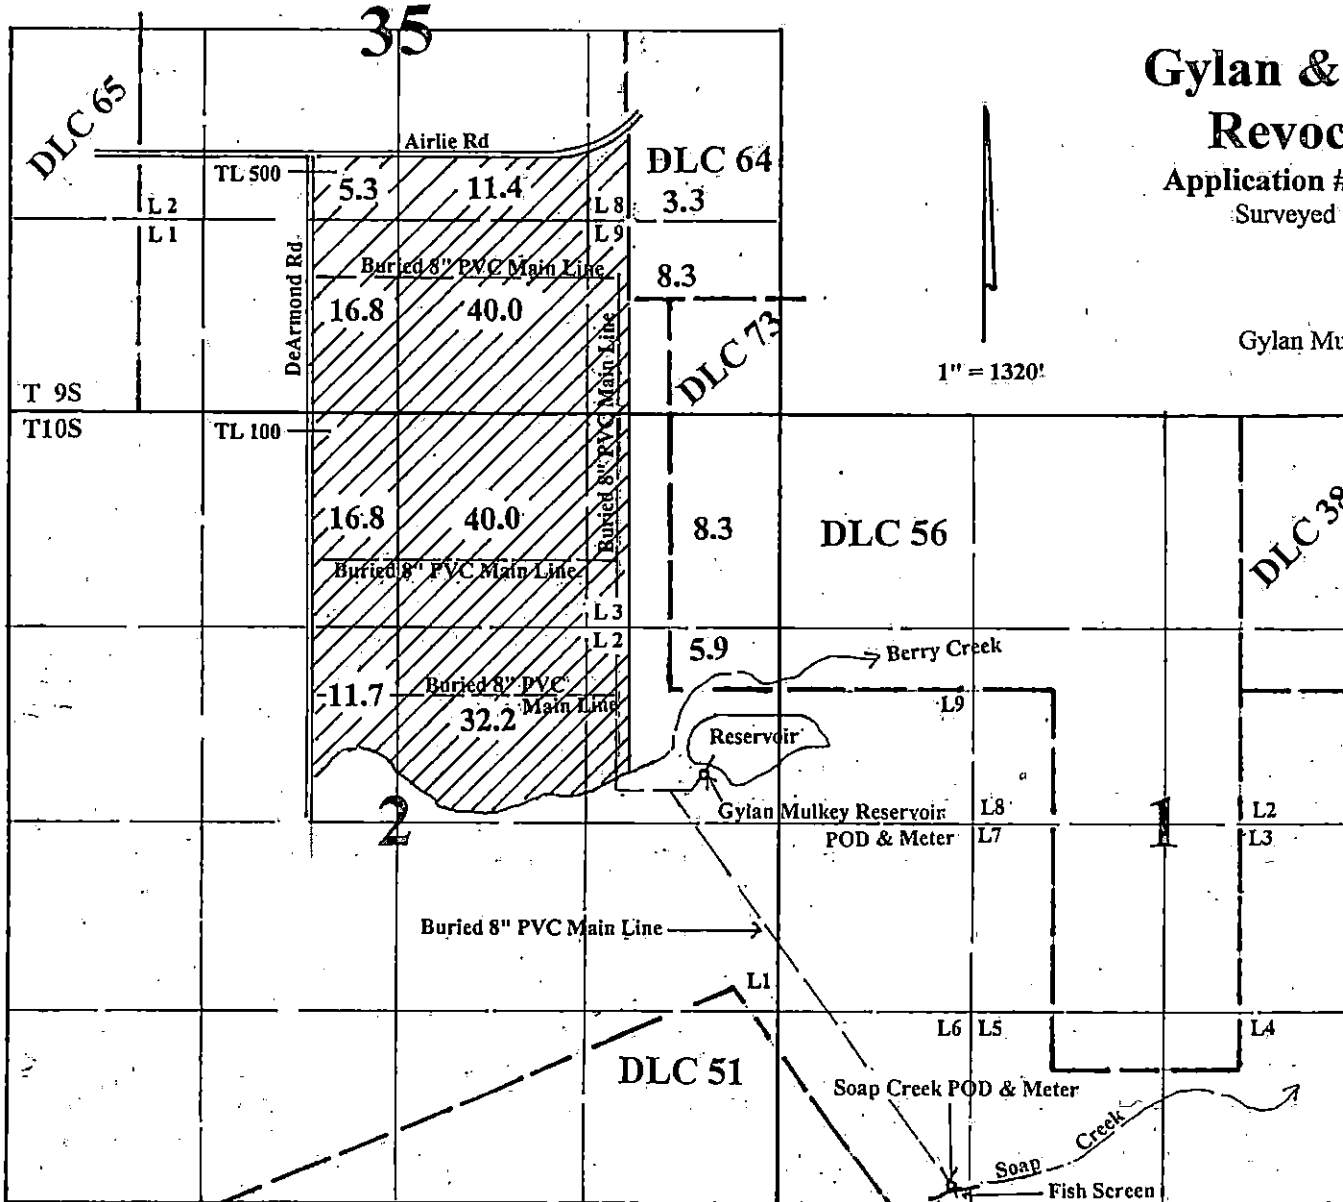

1" = 1320'

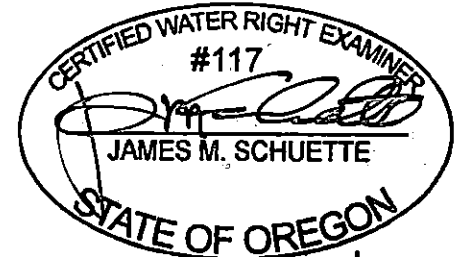

EXPIRES: 6/30/2016



This Map was Prepared for the Purpose of Identifying the Location of a Water Right Only and is Not Intended to Provide Legal Dimensions or Location of Property Ownership Lines.