

ALSEA VENEER
CLAIM OF BENEFICIAL USE
EXHIBIT MAP 2 OF 2
SEPTEMBER 10, 2019

TAX MAP110904

located in


SECTION 4, TOWNSHIP 11 SOUTH,
RANGE 9 WEST, WILLAMETTE MERIDIAN
LINCOLN COUNTY, OREGON

TRANSFER T-10878


LEGEND

- WATERWAYS
- - - SECTION LINE
- - - QTR-SECTION LINE
- - - TAX LOT LINES
- +++++ W & P RAILROAD
- XXXXX PLACE OF USE 1 (MULTI-PURPOSE)
- ////// PLACE OF USE 2 (INDUSTRIAL)

MAP BASE: COUNTY GIS & TAX ASSESSOR MAP

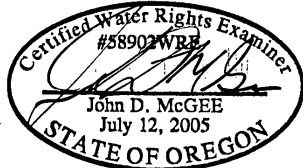

RENEWAL DATE: 12/31/2020

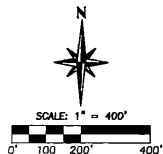


JDMcGee, Inc.

Engineering & Surveying
Land Use Planning
Wastewater Design
"Solving Problems for You"

1215 Main Street
PO Box 1472
Prineville, OR 97370
CSD: 929-4225
CSD: 929-4227 Fax

DRAWN BY: KP
JDM PROJECT #: 19-37

CHECKED BY: JDM
DATE: 10-7-19

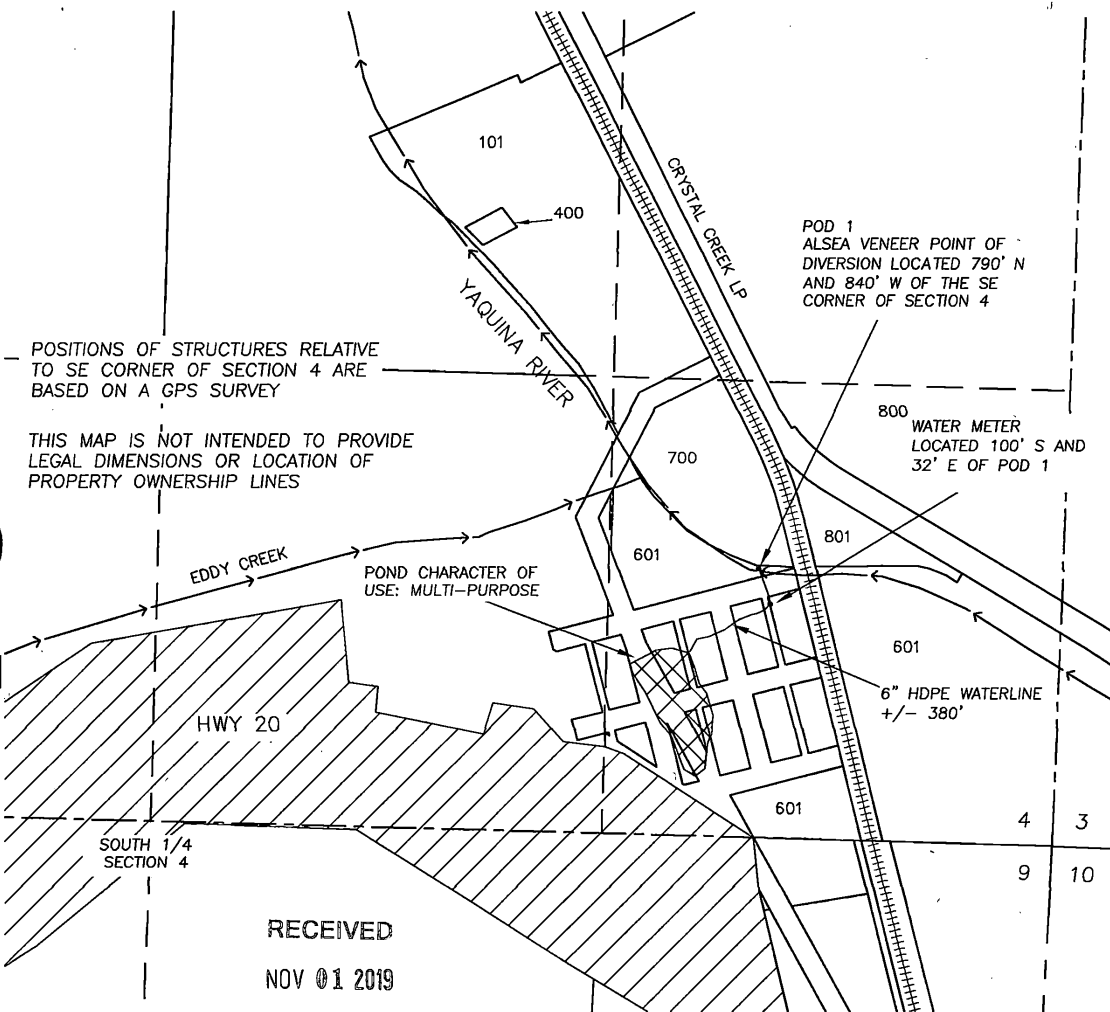

RECEIVED

NOV 01 2019

OWRD