

ALSEA VENEER
CLAIM OF BENEFICIAL USE
EXHIBIT MAP 1 OF 2
SEPTEMBER 10, 2019


TAX MAPS 11 09, 11 10, 10 09

located in

SECTION 36, T10S, R10W,
SECTION 1, T11S, R10W,
SECTION 31, T10S, R9W, AND
SECTIONS 4, 5, 6, 8, 9, 10, AND 11, T11S, R9W,
WILLAMETTE MERIDIAN
LINCOLN COUNTY, OREGON

TRANSFER T-10878

COBU MAP#1218

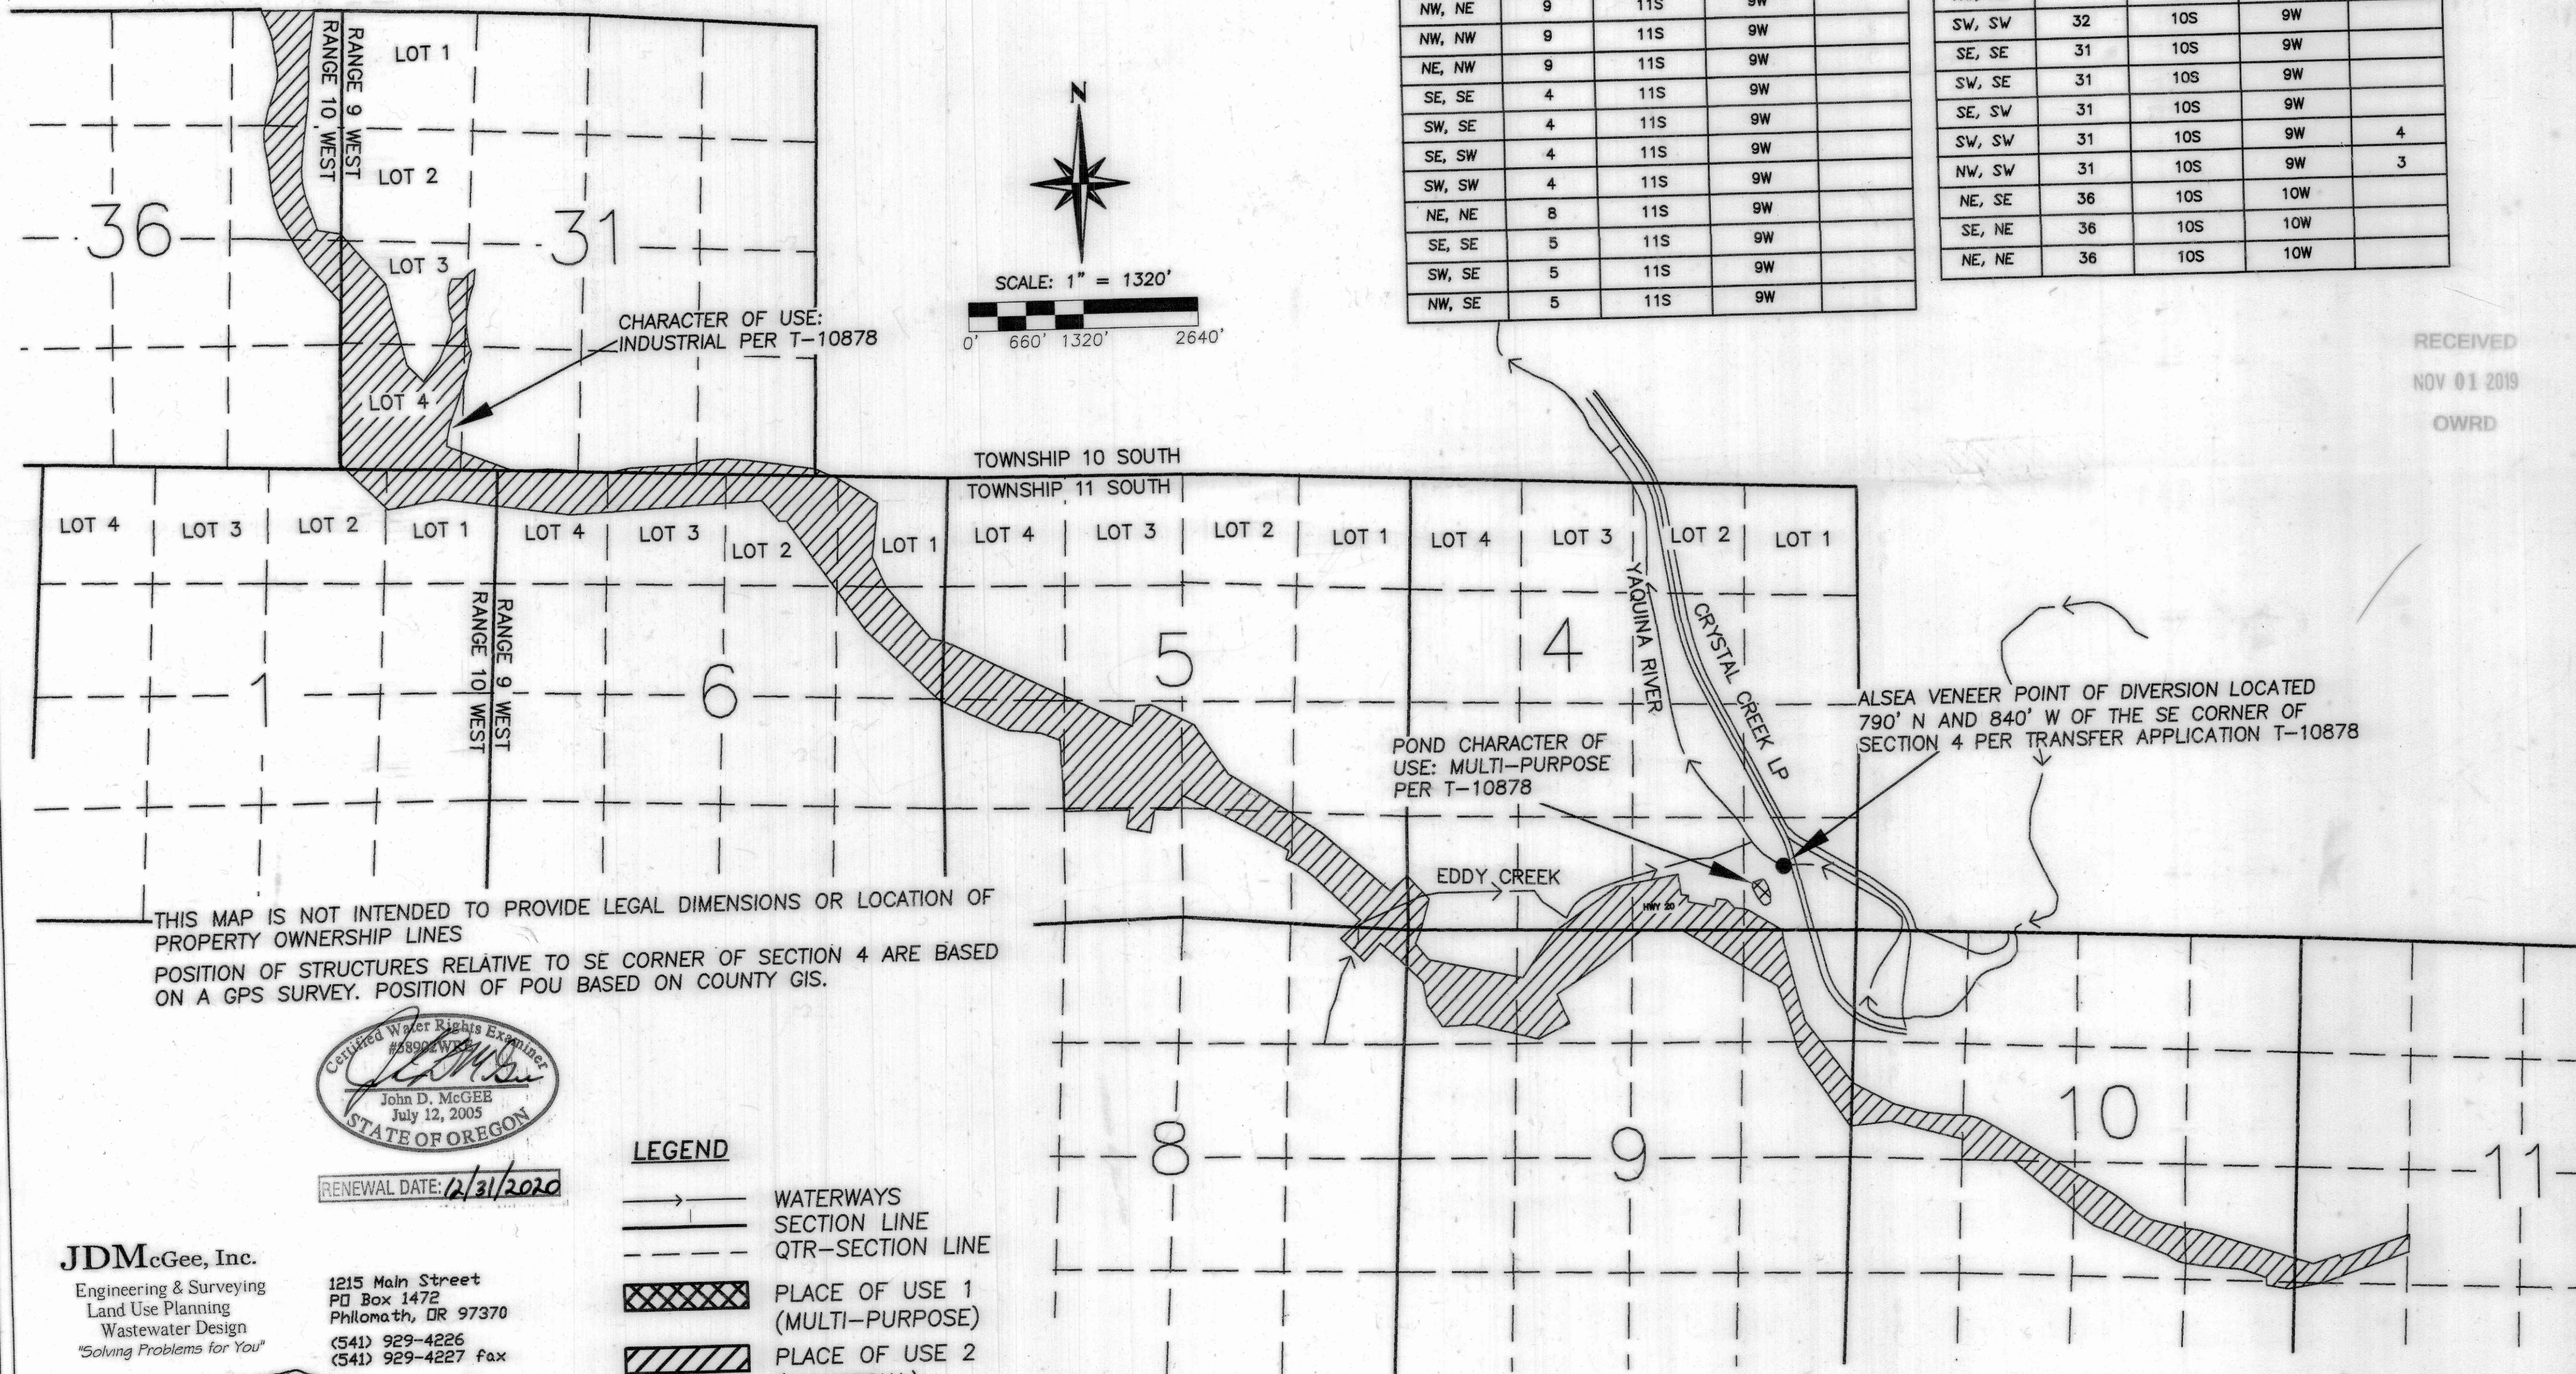

SCALE: 1" = 1320'


0' 660' 1320' 2640'

CHARACTER OF USE:
INDUSTRIAL PER T-10878

POND CHARACTER OF
USE: MULTI-PURPOSE
PER T-10878

ALSEA VENEER POINT OF DIVERSION LOCATED
790' N AND 840' W OF THE SE CORNER OF
SECTION 4 PER TRANSFER APPLICATION T-10878

THIS MAP IS NOT INTENDED TO PROVIDE LEGAL DIMENSIONS OR LOCATION OF
PROPERTY OWNERSHIP LINES
POSITION OF STRUCTURES RELATIVE TO SE CORNER OF SECTION 4 ARE BASED
ON A GPS SURVEY. POSITION OF POU BASED ON COUNTY GIS.

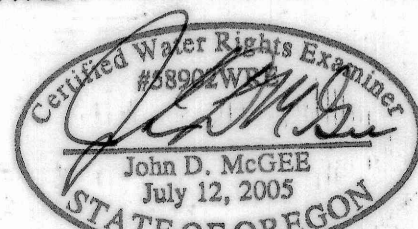

RENEWAL DATE: 12/31/2020

JDMcGee, Inc.

Engineering & Surveying
Land Use Planning
Wastewater Design
"Solving Problems for You"

1215 Main Street
PO Box 1472
Philomath, OR 97370
(541) 929-4226
(541) 929-4227 fax

DRAWN BY: KP
JDM PROJECT #: 18-34

CHECKED BY: JDM
DATE: 02-12-19

LEGEND

- SECTION LINE
- QTR-SECTION LINE
- XXXXXX PLACE OF USE 1 (MULTI-PURPOSE)
- ////// PLACE OF USE 2 (INDUSTRIAL)
- POINT OF DIVERSION

PLACE OF USE

1/4, 1/4	SECTION	TOWNSHIP	RANGE	GOV'T LOT
NW, SW	11	11S	9W	
SW, SW	11	11S	9W	
SE, SE	10	11S	9W	
NE, SE	10	11S	9W	
NW, SE	10	11S	9W	
NE, SW	10	11S	9W	
SE, NW	10	11S	9W	
SW, NW	10	11S	9W	
SE, NE	9	11S	9W	
NE, NE	9	11S	9W	
NW, NE	9	11S	9W	
NW, NW	9	11S	9W	
NE, NW	9	11S	9W	
SE, SE	4	11S	9W	
SW, SE	4	11S	9W	
SE, SW	4	11S	9W	
SW, SW	4	11S	9W	
NE, NE	8	11S	9W	
SE, SE	5	11S	9W	
SW, SE	5	11S	9W	
NW, SE	5	11S	9W	

1/4, 1/4	SECTION	TOWNSHIP	RANGE	GOV'T LOT
NE, SW	5	11S	9W	
SE, SW	5	11S	9W	
NW, SW	5	11S	9W	
SE, NW	5	11S	9W	
SE, NE	6	11S	9W	
NE, NE	6	11S	9W	1
NW, NE	6	11S	9W	2
NE, NW	6	11S	9W	3
NW, NW	6	11S	9W	4
NE, NE	1	11S	10W	1
NW, NE	1	11S	10W	2
SW, SW	32	10S	9W	
SE, SE	31	10S	9W	
SW, SE	31	10S	9W	
SE, SW	31	10S	9W	
SW, SW	31	10S	9W	4
NW, SW	31	10S	9W	3
NE, SE	36	10S	10W	
SE, NE	36	10S	10W	
NE, NE	36	10S	10W	

RECEIVED
NOV 01 2019
OWRD