




N.E. 1/4 of Section 3, T. 5 S. R. 1 E. W.M.

Clackamas County

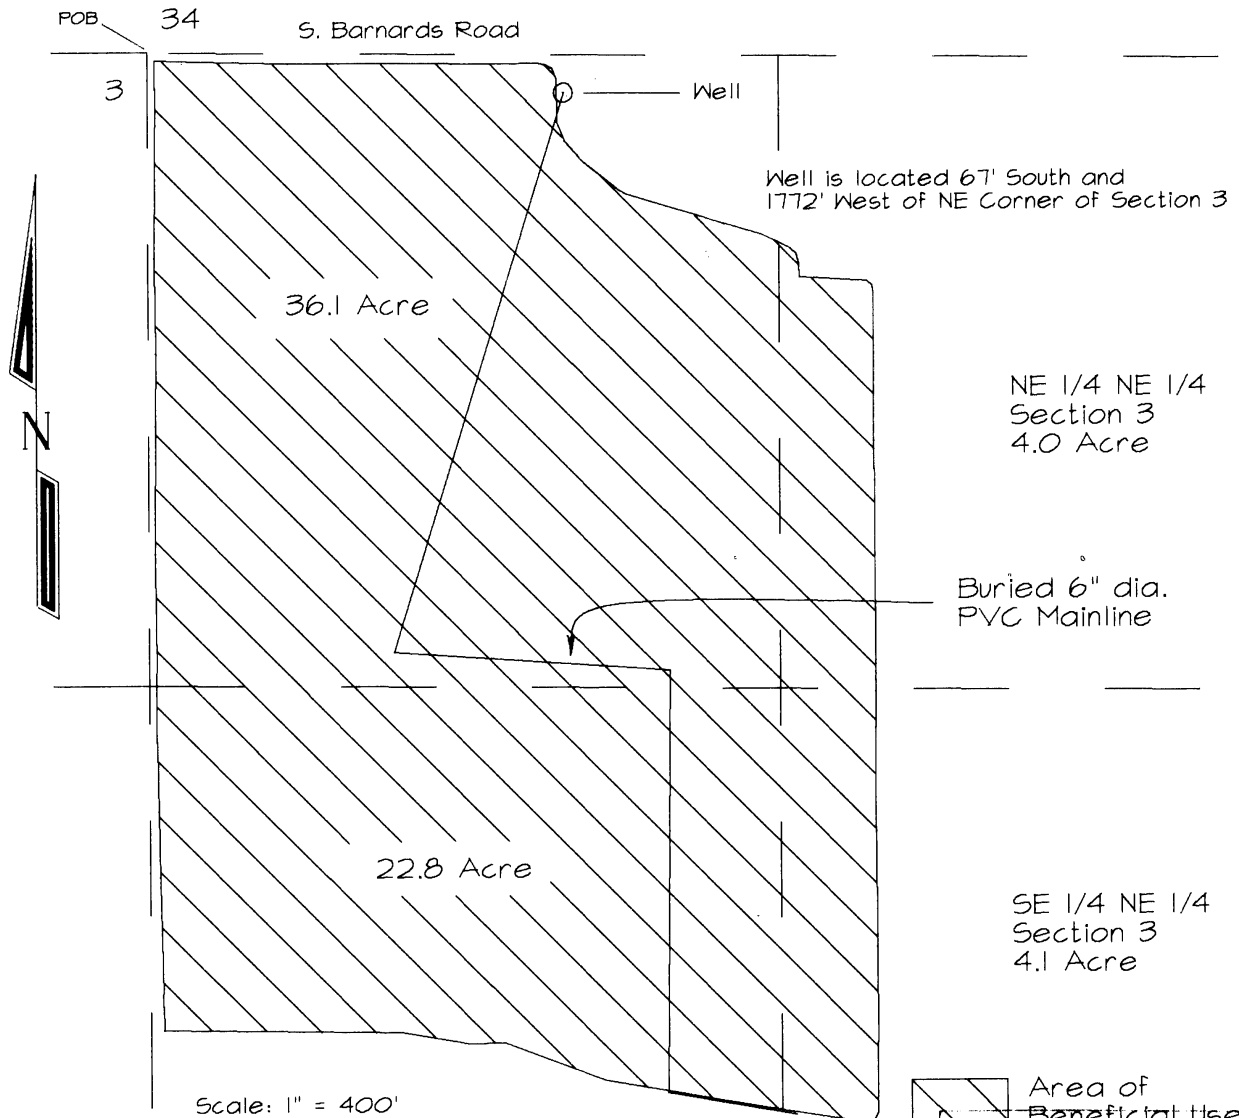

CLAIM OF BENEFICIAL USE
FOR
EYMAN LIMITED PARTNERSHIP II

APPLICATION NUMBER G-12249 PERMIT NUMBER G-12849

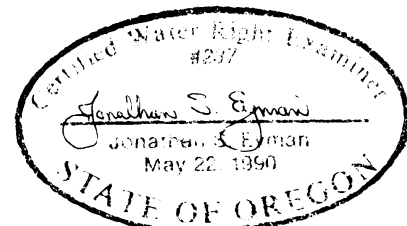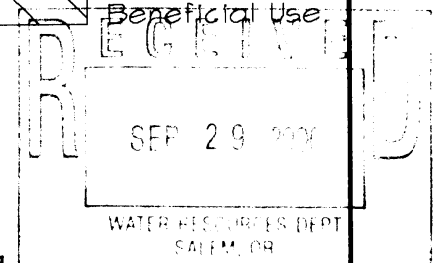

THE PREPARATION OF THIS MAP IS FOR THE PURPOSE OF IDENTIFYING THE LOCATION OF THE WATER RIGHT ONLY AND HAS NO INTENT TO PROVIDE DIMENSIONS OR LOCATION OF PROPERTY OWNERSHIP LINES.

September 25, 2000